


POLE AND EQUIPMENT SCHEDULE											
POLE No.	TYPE OF POLE	LUMINAIRE VOLTAGE/WATTAGE	VEHICLE SIGNAL					PEDESTRIAN SIGNAL			REMARKS
			No.	TYPE	MOUNTING	VISORS	LOUVERS/BP	No.	TYPE	MOUNTING	
①	EX. 10' TAPER TUBE POLE		42 21	3S8" 3S8"	TV-2-T	T T		28 89	1S-COUNT 1S-COUNT	SP-1 SP-1	
②	EX. 10' TAPER TUBE POLE		41 62	3S8" 3S8"	TV-2-T	T T		29	1S-COUNT	SP-1	
③	EX. 7' TAPER TUBE POLE							48	1S-COUNT	TP-1	
④	EX. 10' TAPER TUBE POLE		63	3S8"	TV-1	T					
⑤	EX. 10' TAPER TUBE POLE		61 82	3S8" 3S8"	TV-2-T-SF	T T		49 68	1S-COUNT 1S-COUNT	SP-1 SP-1	
⑥	EX. 10' TAPER TUBE POLE		22 81	3S8" 3S8"	TV-2-T	T T		69 88	1S-COUNT 1S-COUNT	SP-1 SP-1	
⑦	EX. 10' TAPER TUBE POLE		23	3S8"	TV-1	T					

PHASE DIAGRAM

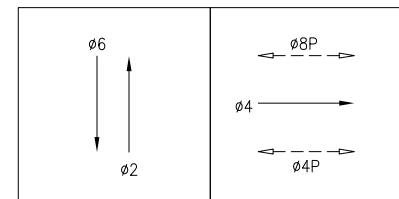

PHASE SEQUENCE

G	Y	R	DOLORES ST. (NB & SB) - ø2 & ø6		
R		G	Y	R	14TH ST. (EB) - ø4
RH		WM	FRH	RH	PEDS XING DOLORES ST. (SS & SN) - ø4P & ø8P

TABLE OF REVISIONS				
NO.	DATE	DESCRIPTION	BY	APP.
4/9/14		MOVED PED SIGNAL 88 TO POLE 6	NW	BBD
4/9/14		ADDED PED SIGNALS 28, 29, 68, AND 69	GH	MV
5/2/13		SUPERCEDES MSID AS PER FIELD CHECK	GH	MV

CHECK WITH TRACING TO SEE IF YOU HAVE LATEST REVISION

REFERENCE INFORMATION & FILE NO. OF SURVEYS	



SAN FRANCISCO MUNICIPAL TRANSPORTATION AGENCY
CITY AND COUNTY OF SAN FRANCISCO

DESIGNED:	DATE:
GH	6/2013
DRAWN:	DATE:
GH	6/2013
CHECKED:	DATE:
MV	6/2013

APPROVED	
SECTION ENGINEER	DATE:
CITY TRAFFIC ENGINEER	DATE:

SCALE:
AS SHOWN
SHEET OF SHEETS
1 OF 1

TRAFFIC SIGNAL INVENTORY DIAGRAM
14TH STREET AND DOLORES STREET

CNN NO.
25871000
REV NO.
2