


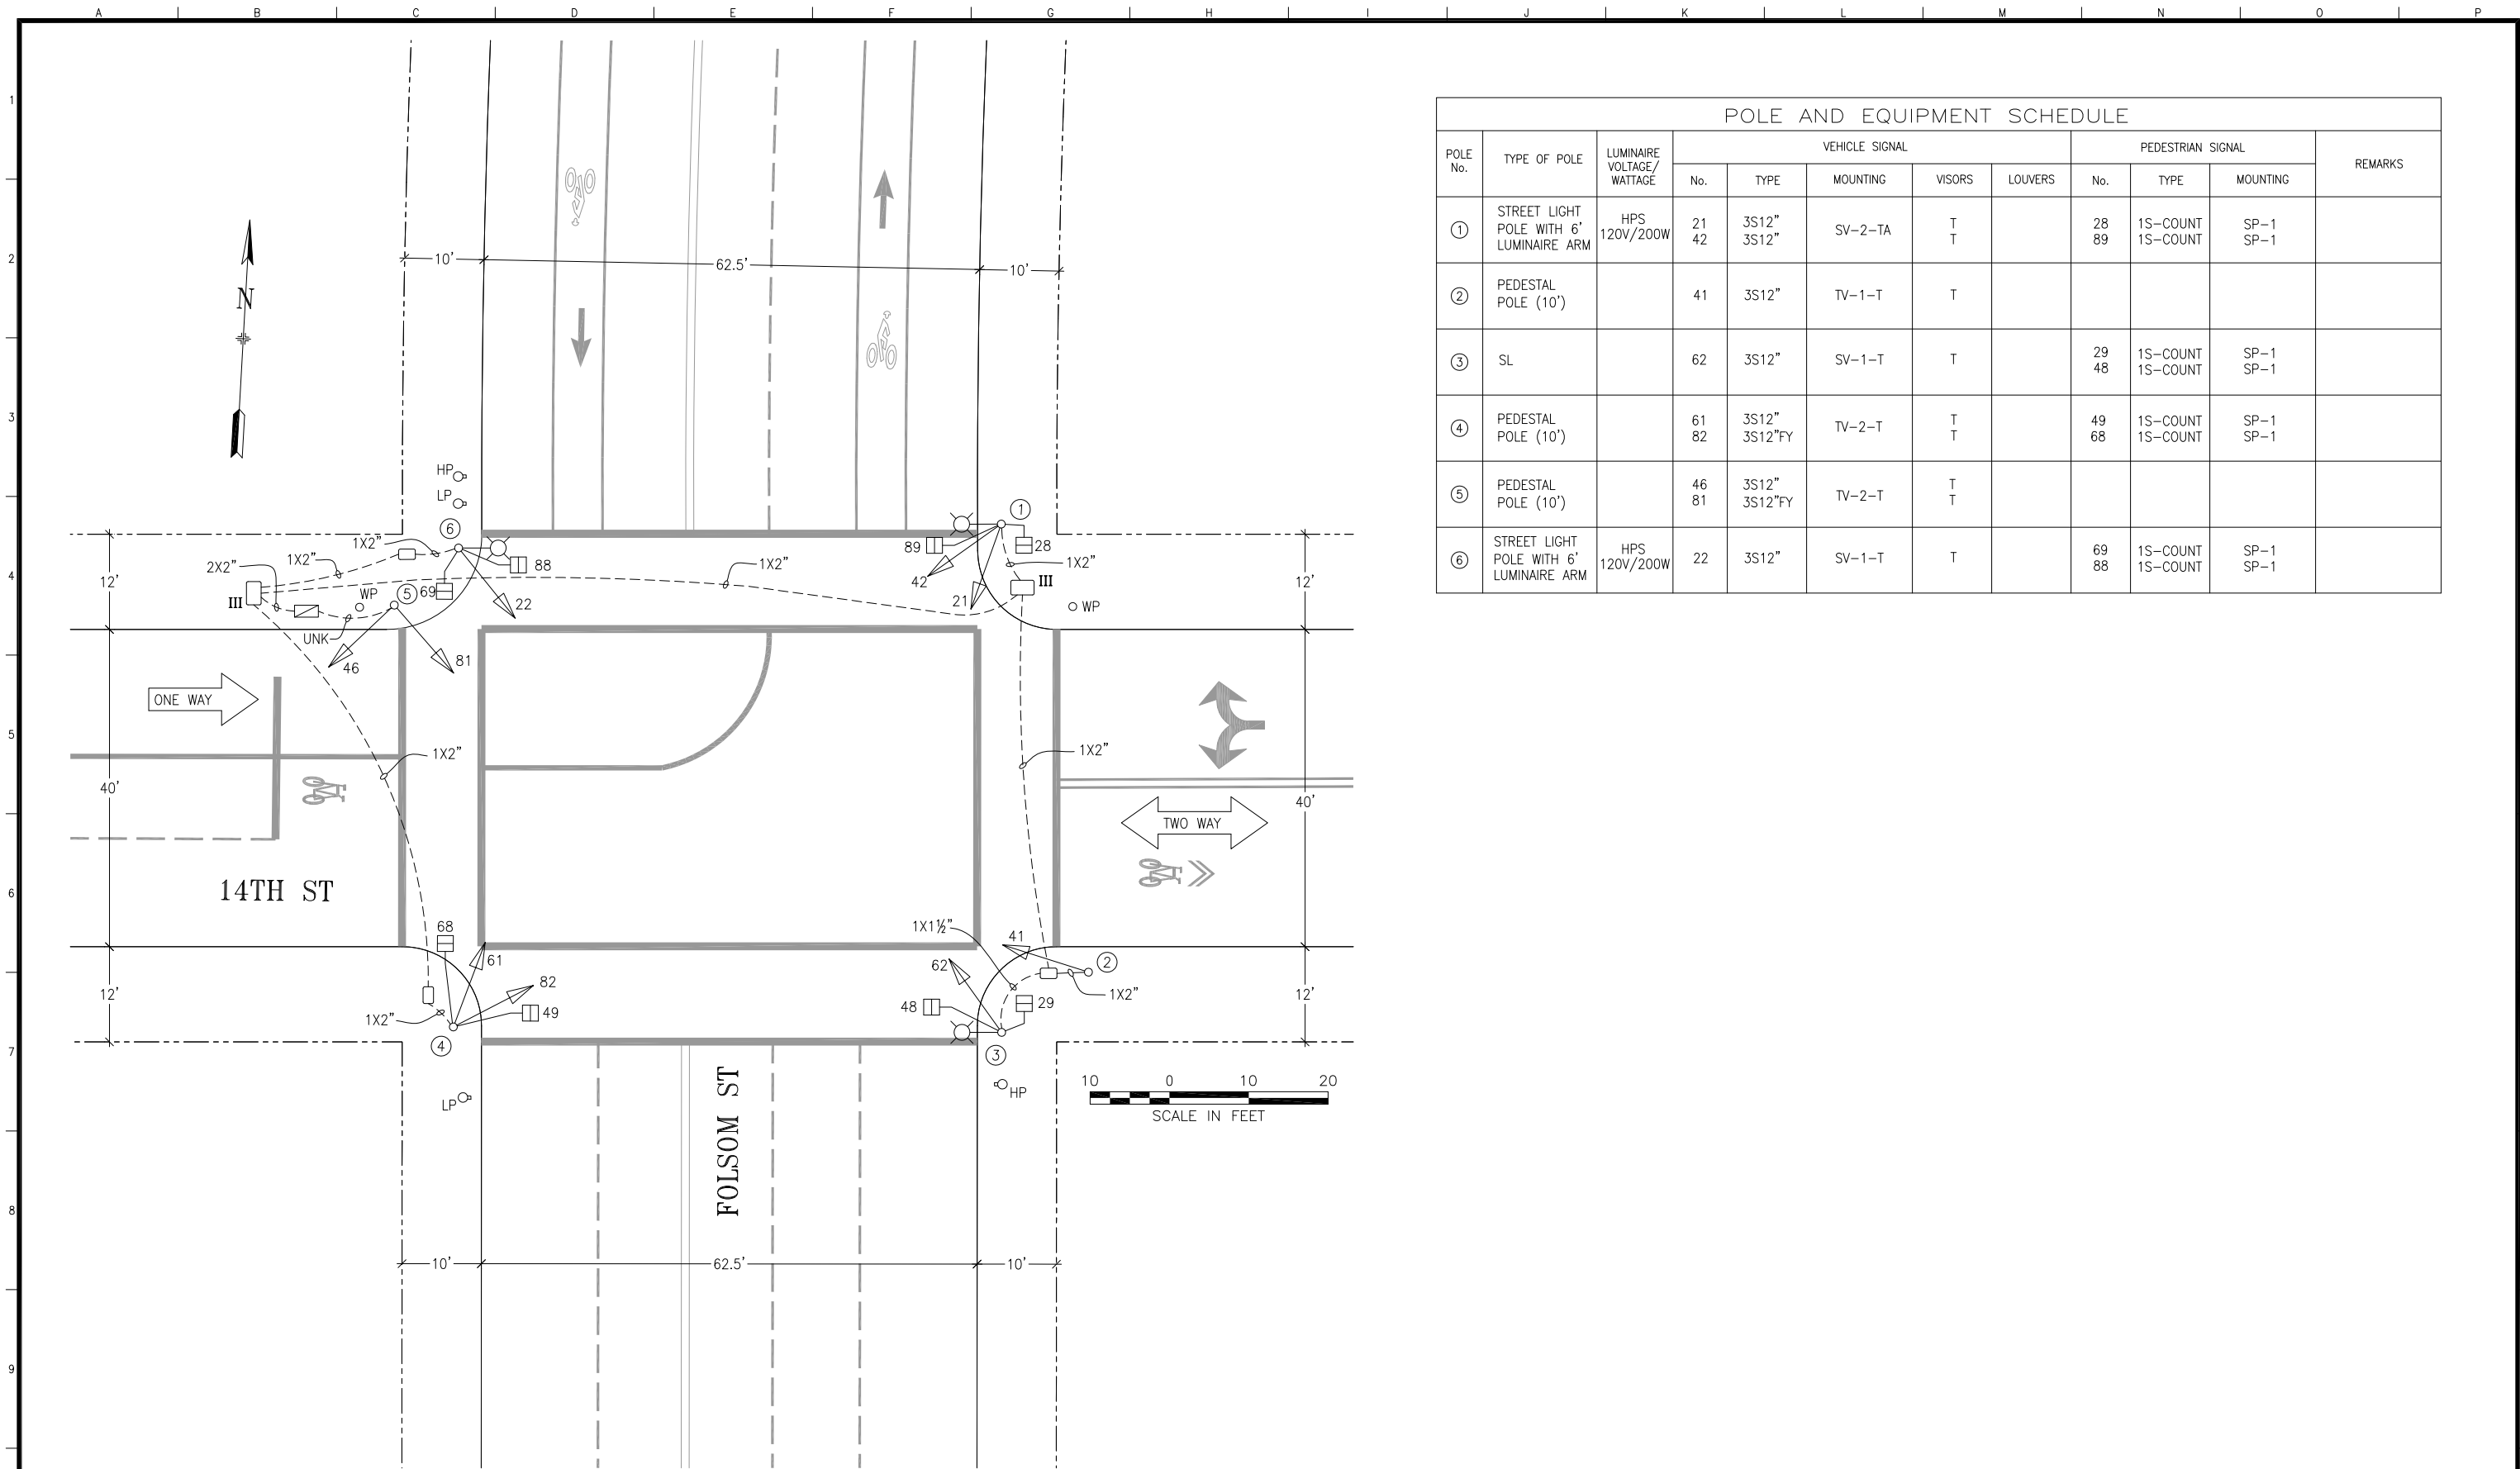

POLE AND EQUIPMENT SCHEDULE											
POLE No.	TYPE OF POLE	LUMINAIRE VOLTAGE/ WATTAGE	VEHICLE SIGNAL					PEDESTRIAN SIGNAL			REMARKS
			No.	TYPE	MOUNTING	VISORS	LOUVERS	No.	TYPE	MOUNTING	
①	STREET LIGHT POLE WITH 6' LUMINAIRE ARM	HPS 120V/200W	21 42	3S12" 3S12"	SV-2-TA	T T		28 89	1S-COUNT 1S-COUNT	SP-1 SP-1	
②	PEDESTAL POLE (10')		41	3S12"	TV-1-T	T					
③	SL		62	3S12"	SV-1-T	T		29 48	1S-COUNT 1S-COUNT	SP-1 SP-1	
④	PEDESTAL POLE (10')		61 82	3S12" 3S12"FY	TV-2-T	T T		49 68	1S-COUNT 1S-COUNT	SP-1 SP-1	
⑤	PEDESTAL POLE (10')		46 81	3S12" 3S12"FY	TV-2-T	T T					
⑥	STREET LIGHT POLE WITH 6' LUMINAIRE ARM	HPS 120V/200W	22	3S12"	SV-1-T	T		69 88	1S-COUNT 1S-COUNT	SP-1 SP-1	

1	10/5/16	INSTALL NEW PCS HEADS FOR 2P & 6P, SIGNAL HEAD #46, UPGRADE ALL SIGNALS FROM 8" TO 12".	NK	GD	
0	7/16/15	PER FIELD CHECK	SVohra	Melasco	
NO.	DATE	DESCRIPTION	BY	APP.	
TABLE OF REVISIONS CHECK WITH TRACING TO SEE IF YOU HAVE LATEST REVISION					

REFERENCE INFORMATION & FILE NO. OF SURVEYS



SAN FRANCISCO MUNICIPAL TRANSPORTATION AGENCY

CITY AND COUNTY OF SAN FRANCISCO

DRAWN:	DATE:
NK	12/2016
CHECKED:	DATE:
GD	12/2016

SCALE:
AS SHOWN
SHEET OF SHEETS
1 OF 1

TRAFFIC SIGNAL INVENTORY DIAGRAM
14TH STREET AND FOLSOM

CNN NO.
24336000
REV NO.
1