



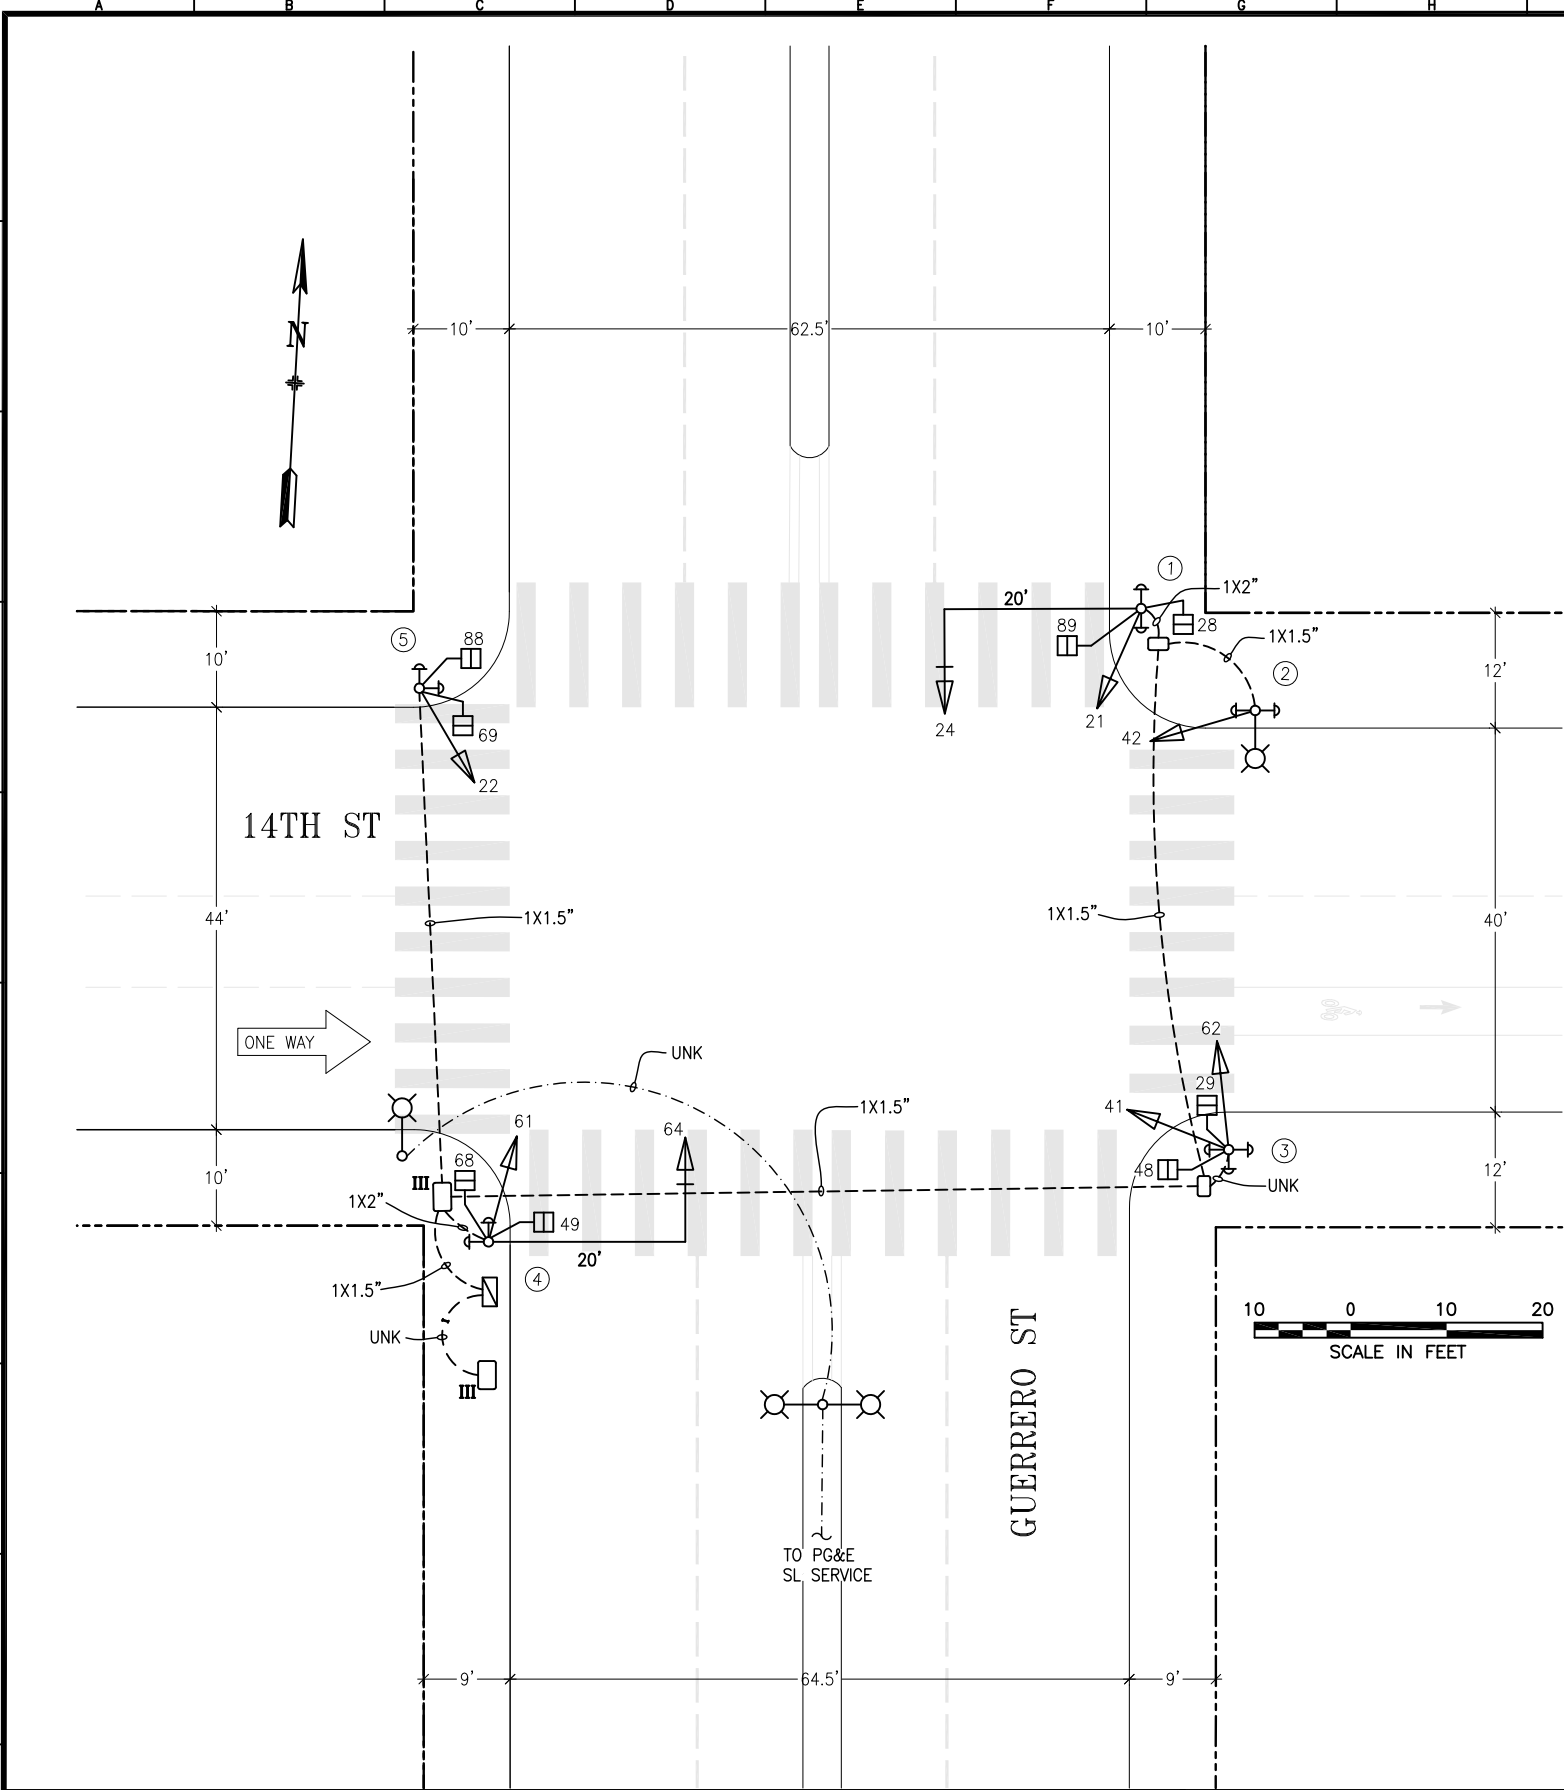

POLE AND EQUIPMENT SCHEDULE											
POLE No.	TYPE OF POLE	LUMINAIRE VOLTAGE/WATTAGE	VEHICLE SIGNAL					PEDESTRIAN SIGNAL			REMARKS
			No.	TYPE	MOUNTING	VISORS	LOUVERS/BP	No.	TYPE	MOUNTING	
①	16-1-70 WITH 20' MAST ARM		21 24	3S12" 3S12"	SV-1-T MAS	T FC	BP	28 89	1S-COUNT 1S-COUNT	SP-1 SP-1	APS-3W x 2
②	STREET LIGHT POLE WITH 6' LUMINAIRE ARM		42	3S12"	SV-1-T	T					APS-3W x 2
③	PEDESTAL POLE (10')		62 41	3S12" 3S12"	TV-2-T-SFA	T T		29 48	1S-COUNT 1S-COUNT	SP-1 SP-1	APS-3W x 3
④	16-1-70 WITH 20' MAST ARM		61 64	3S12" 3S12"	SV-1-T MAS	T FC	BP	49 68	1S-COUNT 1S-COUNT	SP-1 SP-1	APS-3W x 2
⑤	PEDESTAL POLE (10')		22	3S12"	TV-1-T	T		69 88	1S-COUNT 1S-COUNT	SP-1 SP-1	APS-3W x 2

NO.	DATE	DESCRIPTION	BY	APPROVED
3	7/18/23	INSTALL APS (SRC 2023-026)	ELuu	GdeLeon
2	6/04/20	PER SRC 2020-078 CHANGED SIGNALS 21, 41, 62 TO 12" HEADS	AKim	GHo
1	8/24/17	PCS FOR # 2P,4P,6P,8P; REMOVE #8 SRC 2017-218	JHornbostel	GDeLeon
0	7/16/15	PER FIELD CHECK	SVohra	MVelasco

TABLE OF REVISIONS
CHECKOUT DRAWING THROUGH THE SID CUSTODIAN FOR THE LATEST REVISION

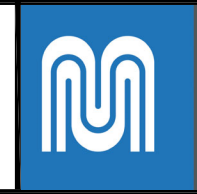

SFMTA

DRAWN BY: SVohra	DATE: 8/2015	SCALE AS SHOWN	TRAFFIC SIGNAL INVENTORY DIAGRAM 14TH STREET AND GUERRERO	CNN NO: 25835000
CHECKED BY: MVelasco	DATE: 8/2015	SHEET OF SHEETS 1 OF 1		REV NO: 3