


| POLE AND EQUIPMENT SCHEDULE | | | | | | | | | | | |
|-----------------------------|----------------------------|---------------------------|----------------|-------------|----------|--------|---------|-------------------|-------------------|-------------------------|--------------------------|
| POLE No. | TYPE OF POLE | LUMINAIRE VOLTAGE/WATTAGE | VEHICLE SIGNAL | | | | | PEDESTRIAN SIGNAL | | | REMARKS |
| | | | No. | TYPE | MOUNTING | VISORS | LOUVERS | No. | TYPE | MOUNTING | |
| ① | MUNI POLE W/ LUMINAIRE | 150W HPS | 61 | 3S12" | SV-1-T | T | | 68 | 1S-COUNT | SP-1-T | EXTERNAL CONDUIT 1 E-0.6 |
| ② | 1-A (10') | | | | | | | 49 | 1S-COUNT | SP-1(22") | |
| ③ | MUNI POLE W/ LUMINAIRE | 150W HPS | 22 65 | 3S12" 3S12" | SV-2-TA | T T | | 69 88 | 1S-COUNT 1S-COUNT | SP-1 (22") SP-1-SF(12") | PREEMPT RADIO |
| ④ | MUNI POLE W/ LUMINAIRE | 150W HPS | 21 | 3S12" | SV-1-T | T | | 28 | 1S-COUNT | SP-1 | |
| ⑤ | 1-A (10') | | 42 | 3S12" | TV-1-T | T | | 89 | 1S-COUNT | SP-1 | |
| ⑥ | CITY STANDARD STREET LIGHT | 150W HPS | 41 | 3S12" | SV-1-T | T | | 48 | 1S-COUNT | SP-1 | |
| ⑦ | MUNI POLE W/ LUMINAIRE | 150W HPS | 62 25 | 3S12" 3S12" | SV-2-TA | T T | | 29 | 1S-COUNT | SP-1 | |

- SHEET NOTES:**
- ① COORDINATE WITH ENGINEER FOR REMOVAL AND SHUT DOWN OF RLC SYSTEM AND WIRING. PROVIDE TEN (10) WORKING DAYS NOTICE.
 - ② SPLICE NEW 12C INTERCONNECT CABLE TO EXISTING 12C INTERCONNECT CABLE.
 - ③ PRIOR TO ABANDONING CONDUIT AND WIRES IN PLACE. CONTRACTOR TO FIELD VERIFY ALL EXISTING CIRCUIT TO REMAIN. UNUSED WIRES SHALL BE CUT TO THE FACE OF PULLBOX.
 - ④ SPLICE NEW STREET LIGHT WIRES TO EXISTING STREETLIGHT WIRES TO MAINTAIN STREET LIGHT CIRCUIT.
 - ⑤ RUN CONDUIT ALONG THE EXISTING POLE FOUNDATION WITH STUB OUT AT THE BASE. PROVIDE LB CONDULET, GASKET AND INNER TUBE. SEE PHOTO. 4 E-0.6

PHASE DIAGRAM

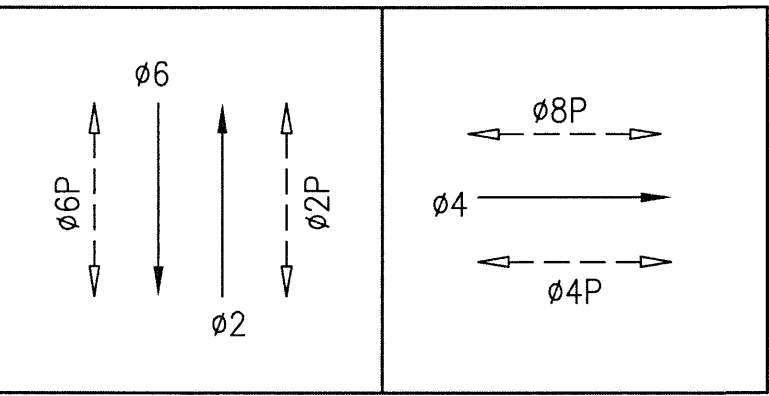

PHASE SEQUENCE

| | | | | | | | |
|----|--|-----|----|-----|----|---|-----------------------|
| G | | Y | R | | | SOUTH VAN NESS AVENUE (NB + SB) - 02 + 06 | |
| R | | | G | | Y | R | 14TH STREET (EB) - 04 |
| WM | | FRH | RH | | | PED XING 14TH STREET (ES + WS) - 02P + 06P | |
| RH | | | WM | FRH | RH | PED XING SOUTH VAN NESS AVE (SS + NS) - 04P + 08P | |

NOTE;
THIS AUTOCAD DRAWING HAS BEEN REVISED AND REPLOTTED SUBSEQUENT TO INTERNAL ENGINEERING APPROVAL AND SIGN-OFF. FOR THOSE SIGNATURES, SEE THE DRAWING PLOTTED AND ISSUED PREVIOUSLY DURING BIDDING. THE SIGNED DRAWING REMAINS VALID EXCEPT FOR THE CHANGES ONLY AS CLEARLY MARKED ON THIS DRAWING AND ISSUED UNDER THIS LATEST REVISION NUMBER AS SHOWN IN THE TABLE OF REVISIONS LOCATED AT THE LOWER LEFT CORNER OF THE DRAWING. ALL ISSUED REVISIONS SUBSEQUENT TO PREVIOUSLY PLOTTED DRAWING DURING BIDDING REMAIN VALID UNLESS SUPERSEDED BY LATER ISSUED REVISIONS. CHECK ALL ISSUED REVISIONS OF THIS DRAWING.

| NO. | DATE | DESCRIPTION | BY | APP. |
|--------------------|---------|---|----|------|
| 1 | 6/22/22 | SRC 2022-066: ADDED PREEMPT RADIO | JL | LV |
| 2 | 4/10 | PG&E SERVICE AND MISC POLE LAYOUT CHANGES | DG | SL |
| TABLE OF REVISIONS | | | | |

| REFERENCE INFORMATION & FILE NO. OF SURVEYS | |
|---|--|
| | |

INFRASTRUCTURE DIVISION
DEPARTMENT OF PUBLIC WORKS
CITY AND COUNTY OF SAN FRANCISCO

DESIGNED: DATE: SS/DY/ZH 8/2015
DRAWN: DATE: SS/DY/ZH 8/2015
CHECKED: DATE: MV/SL

APPROVED

SECTION MANAGER DATE:

DEPUTY DIVISION MANAGER DATE:

DIVISION MANAGER DATE:

SCALE: AS SHOWN

SHEET OF SHEETS 9 OF 22

SOUTH VAN NESS AVE TRAFFIC SIGNAL UPGRADE

14TH STREET AND SOUTH VAN NESS AVENUE TRAFFIC SIGNAL MODIFICATIONS

CONTRACT NO. 2569J

DRAWING NO. E-1.0

FILE NO. 105,266

REV. NO. 2

| CONDUIT AND WIRING SCHEDULE (FURNISH AND INSTALL CONDUIT AND WIRES) | | | | | | | | | | | | | | | | | | | | | | | | | | | | | | | | | |
|---|--------------------------|-----|-----|----|---|----|----|----|----|-----|----|----|----|----|-----|----|----|----|----|-----|----|-----|----|-----|----|-----|--|--|--|--|--|--|--|
| CONDUIT RUN NUMBER | | 1 | 2 | 3 | 4 | 5 | 6 | 7 | 8 | 9 | 9A | 10 | 11 | 12 | 12A | 13 | 14 | 15 | 16 | 17 | 18 | 19 | 20 | 21 | 22 | 23 | | | | | | | |
| CONDUIT SIZE (INCH) | | 2 | 2 | 2 | 2 | 2 | 2 | 3 | 2 | 2 | 2 | 2 | 2 | 3 | 2 | 2 | 2 | 2 | 3 | 2 | 2 | 2 | 2 | 2 | 2 | 2 | | | | | | | |
| | | GRS | GRS | | | EX | | | SP | GRS | | | EX | SP | | SP | | | | GRS | SP | GRS | SP | GRS | SP | GRS | | | | | | | |
| NOTES | | | | | | | | | | | | | | 1 | | | | | | | | | | SP | | SP | | | | | | | |
| | VEHICLE SIGNAL 62 | 3 | | 3 | | | 3 | 3 | | | | | | | | | | | | | | | | | | | | | | | | | |
| | VEHICLE SIGNAL 25 | 3 | | 3 | | | 3 | 3 | | | | | | | | | | | | | | | | | | | | | | | | | |
| | PED SIGNAL 29 | 2 | | 2 | | | 2 | 2 | | | | | | | | | | | | | | | | | | | | | | | | | |
| | VEHICLE SIGNAL 41 | | 3 | 3 | | | 3 | 3 | | | | | | | | | | | | | | | | | | | | | | | | | |
| | PED SIGNAL 48 | | 2 | 2 | | | 2 | 2 | | | | | | | | | | | | | | | | | | | | | | | | | |
| | VEHICLE SIGNAL 42 | | | | 3 | | 3 | 3 | | | | | | | | | | | | | | | | | | | | | | | | | |
| | PED SIGNAL 89 | | | | 2 | | 2 | 2 | | | | | | | | | | | | | | | | | | | | | | | | | |
| | VEHICLE SIGNAL 21 | | | | | 3 | 3 | 3 | | | | | | | | | | | | | | | | | | | | | | | | | |
| | PED SIGNAL 28 | | | | | 2 | 2 | 2 | | | | | | | | | | | | | | | | | | | | | | | | | |
| | VEHICLE SIGNAL 61 | | | | | | | | | 3 | | 3 | | 3 | | | | | | | | | | | | | | | | | | | |
| | PED SIGNAL 49 | | | | | | | | | | 2 | 2 | | 2 | | | | | | | | | | | | | | | | | | | |
| | PED SIGNAL 68 | | | | | | | | | 2 | | 2 | | 2 | | | | | | | | | | | | | | | | | | | |
| | VEHICLE SIGNAL 22 | | | | | | | | | | | | | 3 | 3 | | | | | | | | | | | | | | | | | | |
| | VEHICLE SIGNAL 65 | | | | | | | | | | | | | 3 | 3 | | | | | | | | | | | | | | | | | | |
| | PED SIGNAL 69 | | | | | | | | | | | | | 2 | 2 | | | | | | | | | | | | | | | | | | |
| | PED SIGNAL 88 | | | | | | | | | | | | | 2 | 2 | | | | | | | | | | | | | | | | | | |
| | | | | | | | | | | | | | | | | | | | | | | | | | | | | | | | | | |
| | | | | | | | | | | | | | | | | | | | | | | | | | | | | | | | | | |
| | | | | | | | | | | | | | | | | | | | | | | | | | | | | | | | | | |
| | #14 NEUTRAL | 2 | 2 | | 2 | 2 | | | | 2 | 1 | | 3 | | | | | | | | | | | | | | | | | | | | |
| | #14 SPARE | | | 3 | | | 3 | 3 | | | | 3 | | 3 | | | | | | | | | | | | | | | | | | | |
| | TOTAL #14 WIRES | 10 | 7 | 16 | 7 | 7 | 26 | 26 | | 7 | 3 | 10 | 13 | 20 | | | | | | | | | | | | | | | | | | | |
| | #10 WIRES NEUTRAL | | | 1 | | | 2 | 2 | | | | 1 | | 2 | | | | | | | | | | | | | | | | | | | |
| | #10 WIRES STREET LIGHT | | 2 | | | | | | | | | | | | | | | | | | | | | | | | | | | | | | |
| | #8 WIRES STREET LIGHT | | | | | | | | | | | | | | | | | | | | | 2 | | | | | | | | | | | |
| | #8 WIRES (120 V SERVICE) | | | | | | | | | | | | | | 2 | | | 2 | 2 | | | | | | | | | | | | | | |
| | INTERCONNECT 12C CABLE | | | | | | | | | | | | | | | | | 3 | | | | | | | | | | | | | | | |
| | | | | | | | | | | | | | | | | | | | | | | | | | | | | | | | | | |
| | | | | | | | | | | | | | | | | | | | | | | | | | | | | | | | | | |
NOTE;
THIS AUTOCAD DRAWING HAS BEEN REVISED AND REPLOTTED
SUBSEQUENT TO INTERNAL ENGINEERING APPROVAL AND
SIGN-OFF. FOR THOSE SIGNATURES, SEE THE DRAWING
PLOTTED AND ISSUED PREVIOUSLY DURING BIDDING. THE
SIGNED DRAWING REMAINS VALID EXCEPT FOR THE CHANGES
ONLY AS CLEARLY MARKED ON THIS DRAWING AND ISSUED
UNDER THIS LATEST REVISION NUMBER AS SHOWN IN THE
TABLE OF REVISIONS LOCATED AT THE LOWER LEFT CORNER
OF THE DRAWING. ALL ISSUED REVISIONS SUBSEQUENT TO
PREVIOUSLY PLOTTED DRAWING DURING BIDDING REMAIN
VALID UNLESS SUPERSEDED BY LATER ISSUED REVISIONS.
CHECK ALL ISSUED REVISIONS OF THIS DRAWING.