


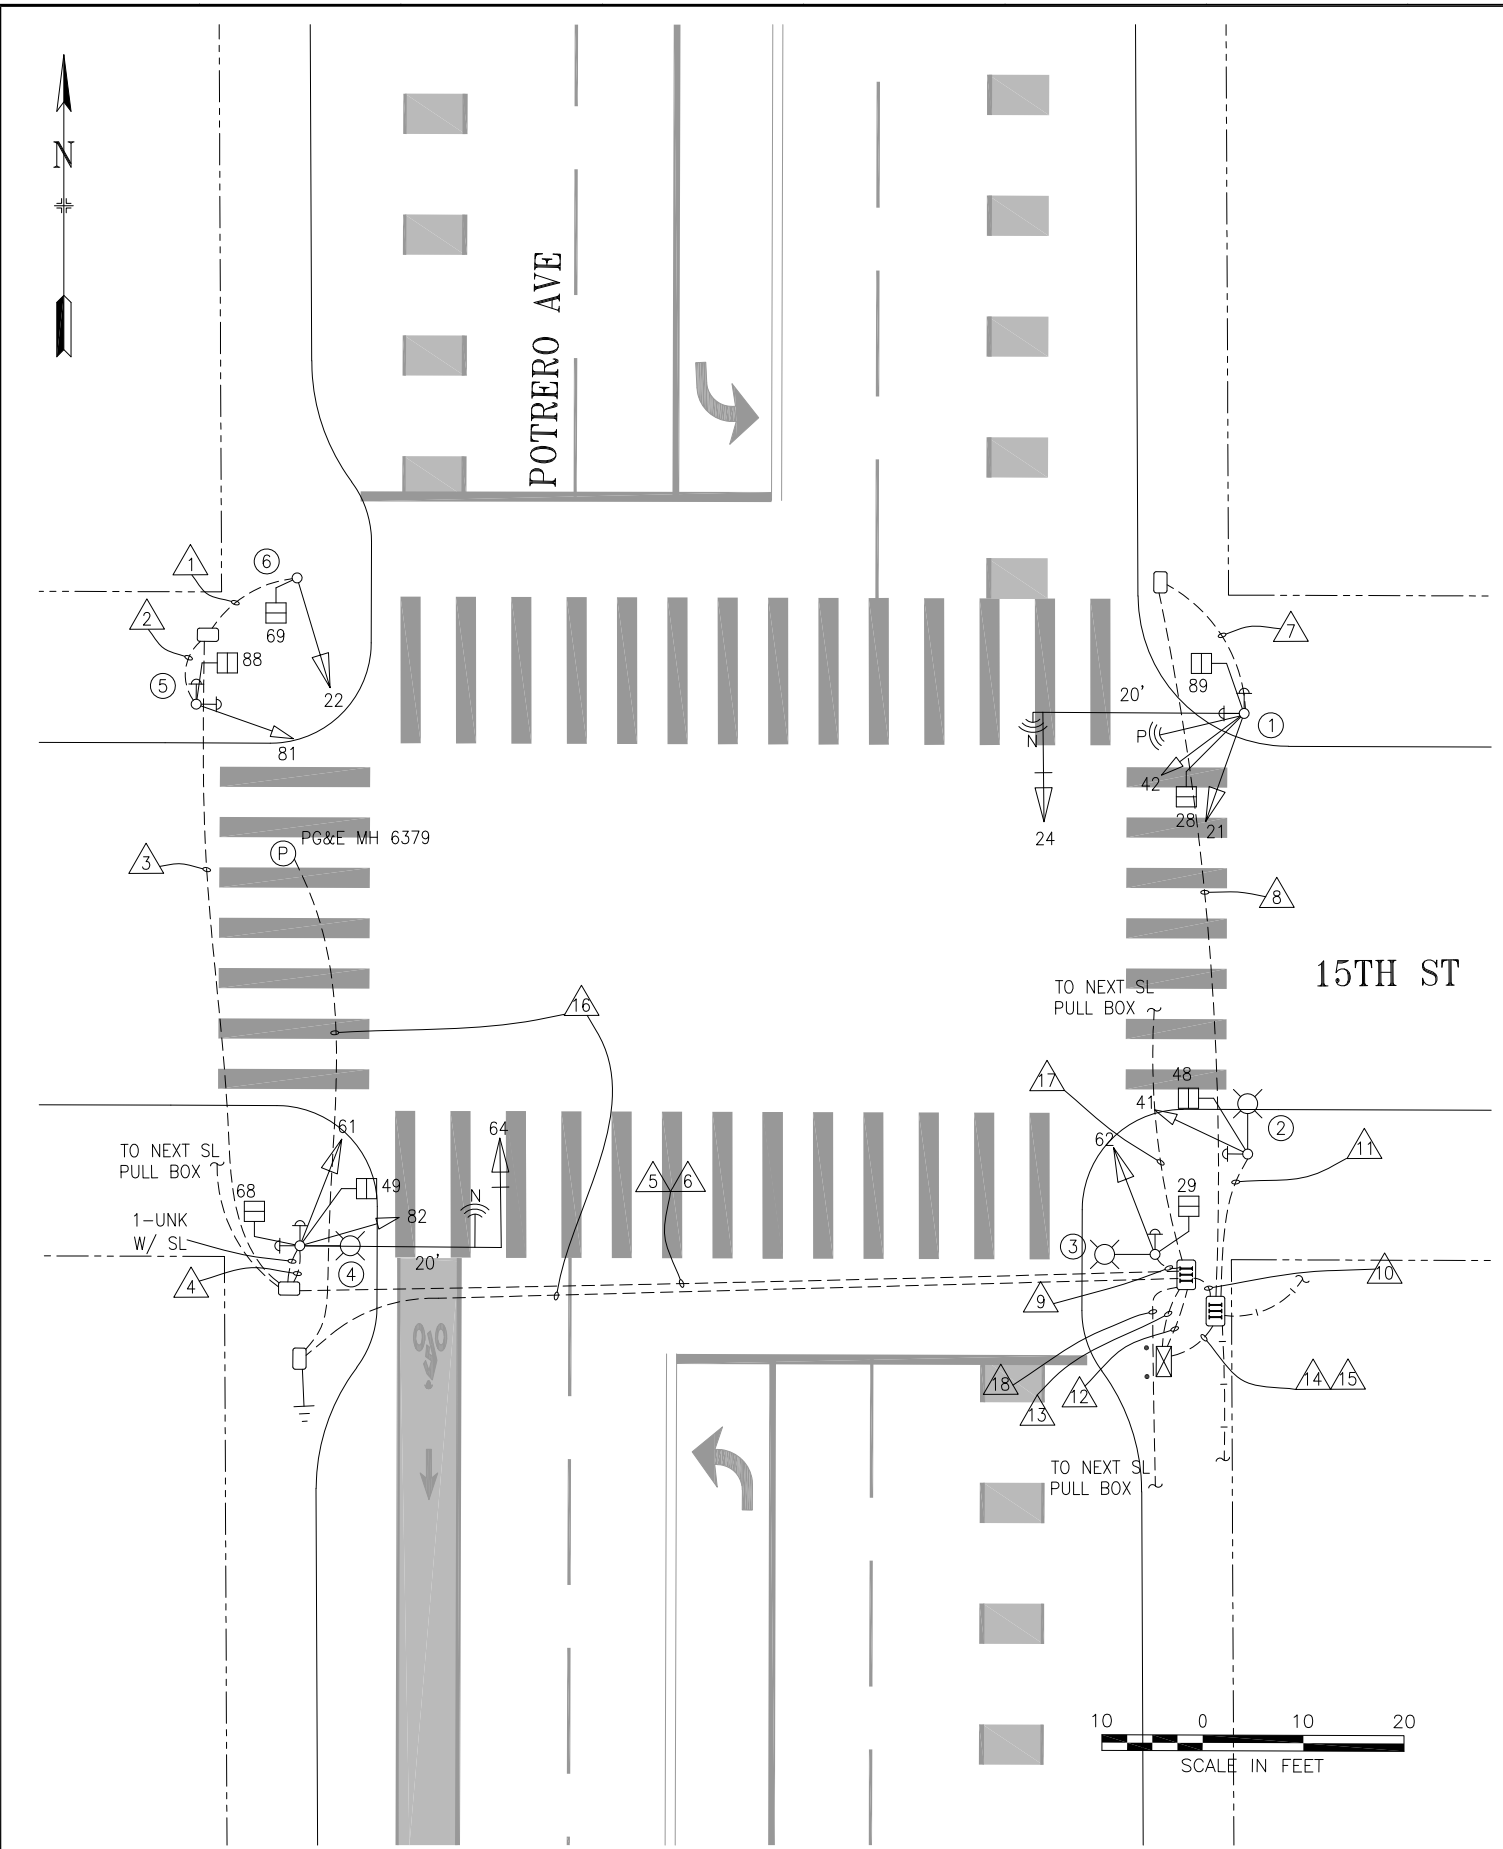

POLE AND EQUIPMENT SCHEDULE											
POLE No.	TYPE OF POLE	LUMINAIRE (HPS) VOLTAGE/ WATTS	VEHICLE SIGNAL					PEDESTRIAN SIGNAL			REMARKS
			No.	TYPE	MOUNTING	VISORS	LOUVERS	No.	TYPE	MOUNTING	
①	EX 16-1-70 with 20' MAST ARM		24 21 42	3S12" 3S12" 3S8"	MAS SV-2-T-SF W/ EXTENDER AND COUPLER	T T T		28 89	1S-COUNT 1S-COUNT	SP-1-SF (12") SP-1 (22")	BP NETWORK RADIO PREEMPT RADIO APS-2W x 2
②	CITY STANDARD STREET LIGHT W/ 6' LUMINAIRE ARM	240V/ 100W	41	3S8"	SV-1-T	T		48	1S-COUNT	SP-1	APS-2W
③	CITY STANDARD STREET LIGHT W/ 6' LUMINAIRE ARM	240V/ 150W	62	3S12"	SV-1-T	T		29	1S-COUNT	SP-1	APS-2W
④	EX 17B-1-70 with 20' MAST ARM AND 6' LUMINAIRE ARM		64 61 82	3S12" 3S12" 3S8"	MAS SV-2-T-SF W/ EXTENDER AND COUPLER	T T T		49 68	1S-COUNT 1S-COUNT	SP-1-SF (12") SP-1 (22")	BP NETWORK RADIO APS-2W x 2
⑤	1 - A (10')		81	3S8"	TV-1	T		88	1S-COUNT	SP-1	APS-2W x 2
⑥	1 - A (10')		22	3S12"	TV-1-T	T		69	1S-COUNT	SP-1	

NO.	DATE	DESCRIPTION	BY	APP.
2	10/20/20	APS PER 2019-211; UPDATE LOCATION OF TSP EQUIP PER FIELD	JH	GD
1	4/27/13	NEW M-SF ON ADAPTER PLATE PER SRC 2012-276	RML	CH
0	8/2/05	UPGRADE BY 0777J; CONVERTED FROM AS-BUILTS	JH	GD
TABLE OF REVISIONS				
CHECK WITH TRACING TO SEE IF YOU HAVE LATEST REVISION				

REFERENCE INFORMATION
& FILE NO. OF SURVEYS



SAN FRANCISCO MUNICIPAL TRANSPORTATION AGENCY
CITY AND COUNTY OF SAN FRANCISCO

DRAWN: JH
DATE: 6/2019
CHECKED: GD
DATE: 6/2019

SCALE:

AS SHOWN

SHEET OF SHEETS

01 OF 02

TRAFFIC SIGNAL INVENTORY DIAGRAM

15TH STREET AND POTRERO AVENUE

CNN NO.

24186000

REV NO.

