


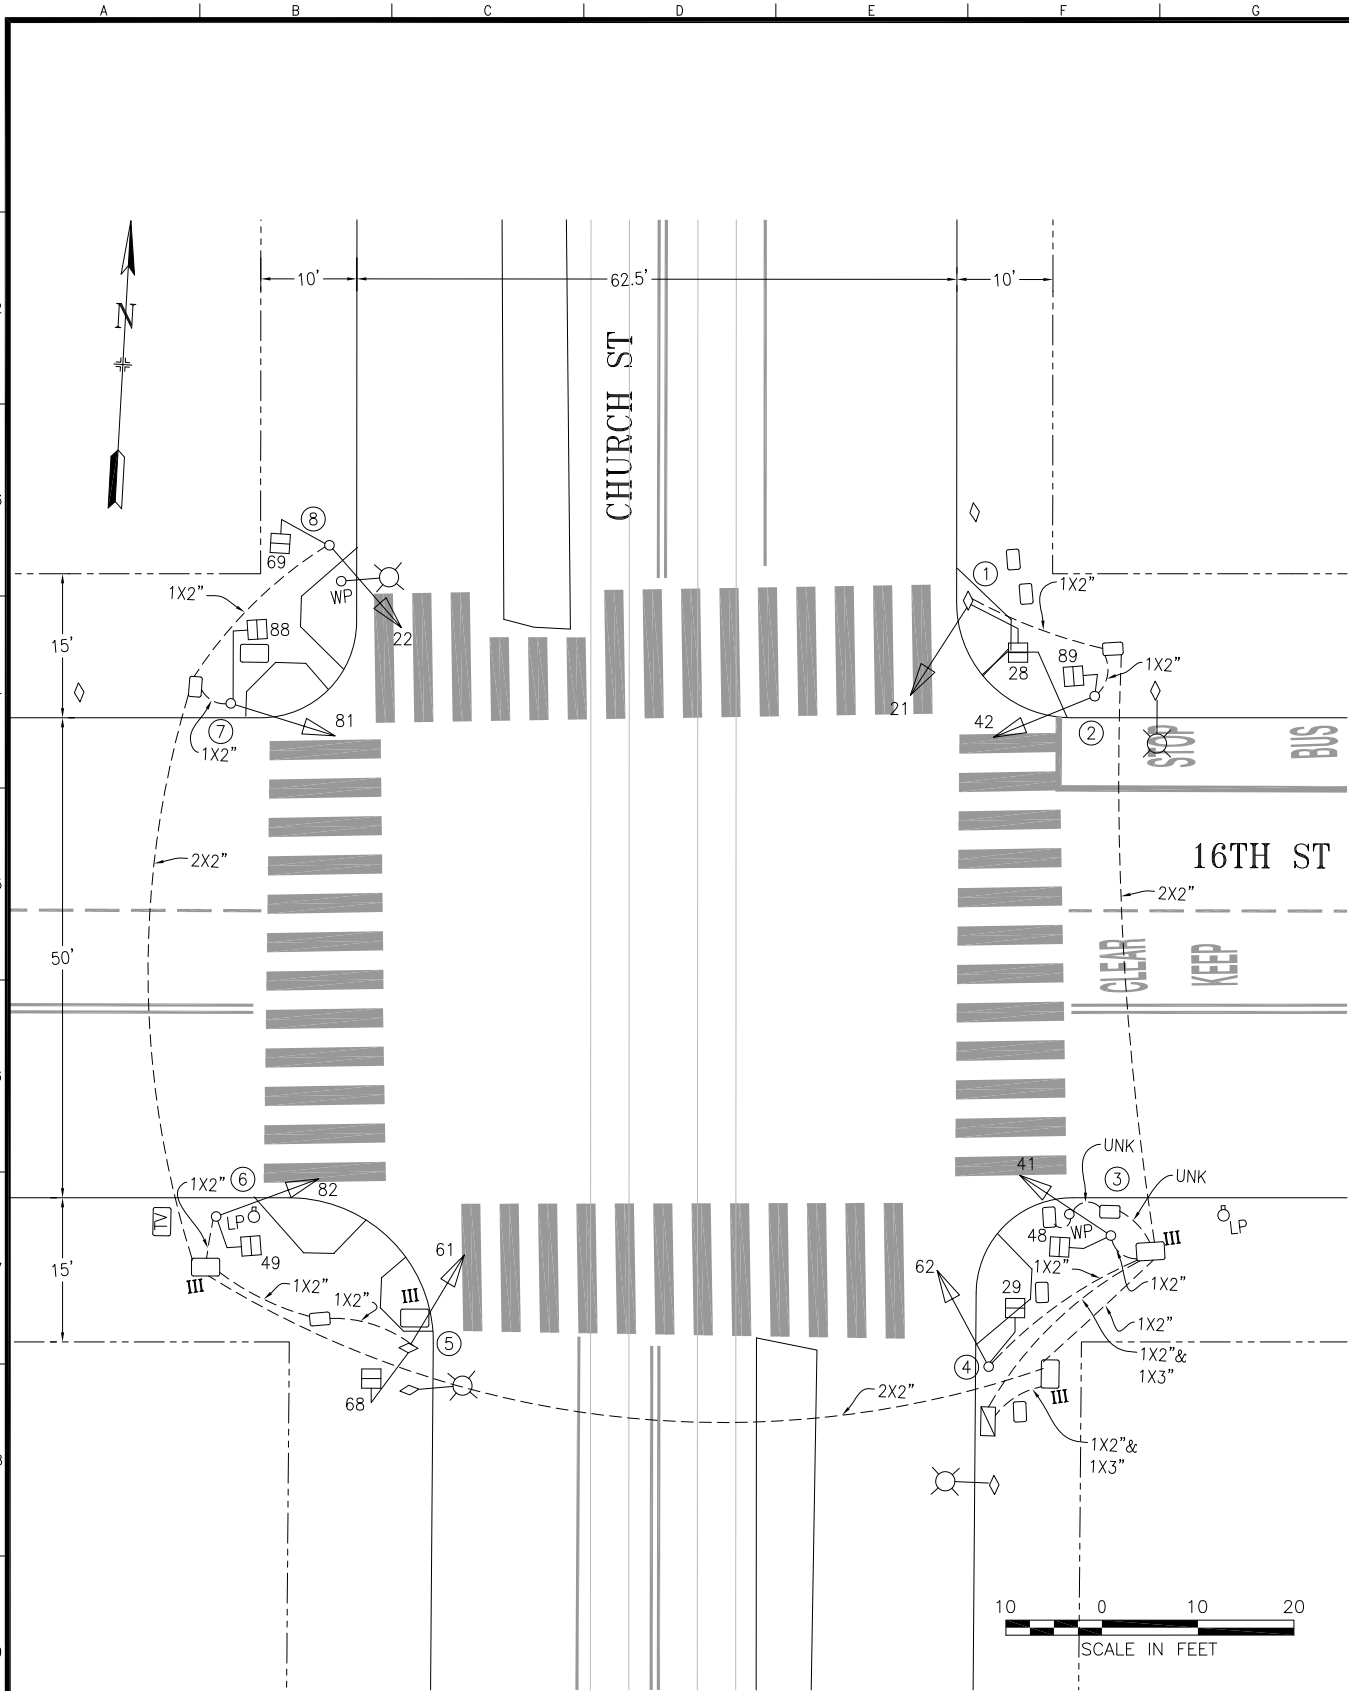

POLE AND EQUIPMENT SCHEDULE										
POLE No.	TYPE OF POLE	VEHICLE SIGNAL					PEDESTRIAN SIGNAL			REMARKS
		No.	TYPE	MOUNTING	VISORS	LOUVERS	No.	TYPE	MOUNTING	
①	EX. MUNI (STEEL STRUCTURE)	21	3S12"	SV-1-T	T		28	1S-COUNT	SP-1-T	EXTERNAL CONDUIT
②	1-A (10')	42	3S12"	TV-1-T (16")	T		89	1S-COUNT	SP-1	MOUNT SIGNAL 42 ON SIDEWALK SIDE
③	1-A (10')	41	3S12"	TV-1-T	T		48	1S-COUNT	SP-1	
④	1-A (10')	62	3S12"	TV-1-T (16")	T		29	1S-COUNT	SP-1	MOUNT SIGNAL 62 ON SIDEWALK SIDE
⑤	EX. MUNI	61	3S12"	SV-1-T	T		68	1S-COUNT	SP-1	
⑥	1-A (10')	82	3S12"	TV-1-T	T		49	1S-COUNT	SP-1	
⑦	1-A (10')	81	3S12"	TV-1-T (16")	T		88	1S-COUNT	SP-1	MOUNT SIGNAL 81 ON SIDEWALK SIDE
⑧	1-A (10')	22	3S12"	TV-1-T	T		69	1S-COUNT	SP-1	

0	5/13/14	SIGNAL UPGRADE ACTIVATED THRU 1901J AND CONVERTED FROM AS-BUILTS						DYeung	MVelasco
NO.	DATE	DESCRIPTION						BY	APP.
TABLE OF REVISIONS									
CHECK WITH TRACING TO SEE IF YOU HAVE LATEST REVISION									

COMPLETION DATE / ELECTRICIAN INITIAL
--



SAN FRANCISCO MUNICIPAL TRANSPORTATION AGENCY
TRANSPORTATION ENGINEERING
CITY AND COUNTY OF SAN FRANCISCO

DRAWN: DYeung	DATE: 5/2015	SCALE: AS SHOWN
CHECKED: MVelasco	DATE: 5/2015	SHEET OF SHEETS: 1 OF 1

TRAFFIC SIGNAL INVENTORY DIAGRAM
16TH STREET AND CHURCH STREET

CNN NO. 25726000
REV. NO. 0