


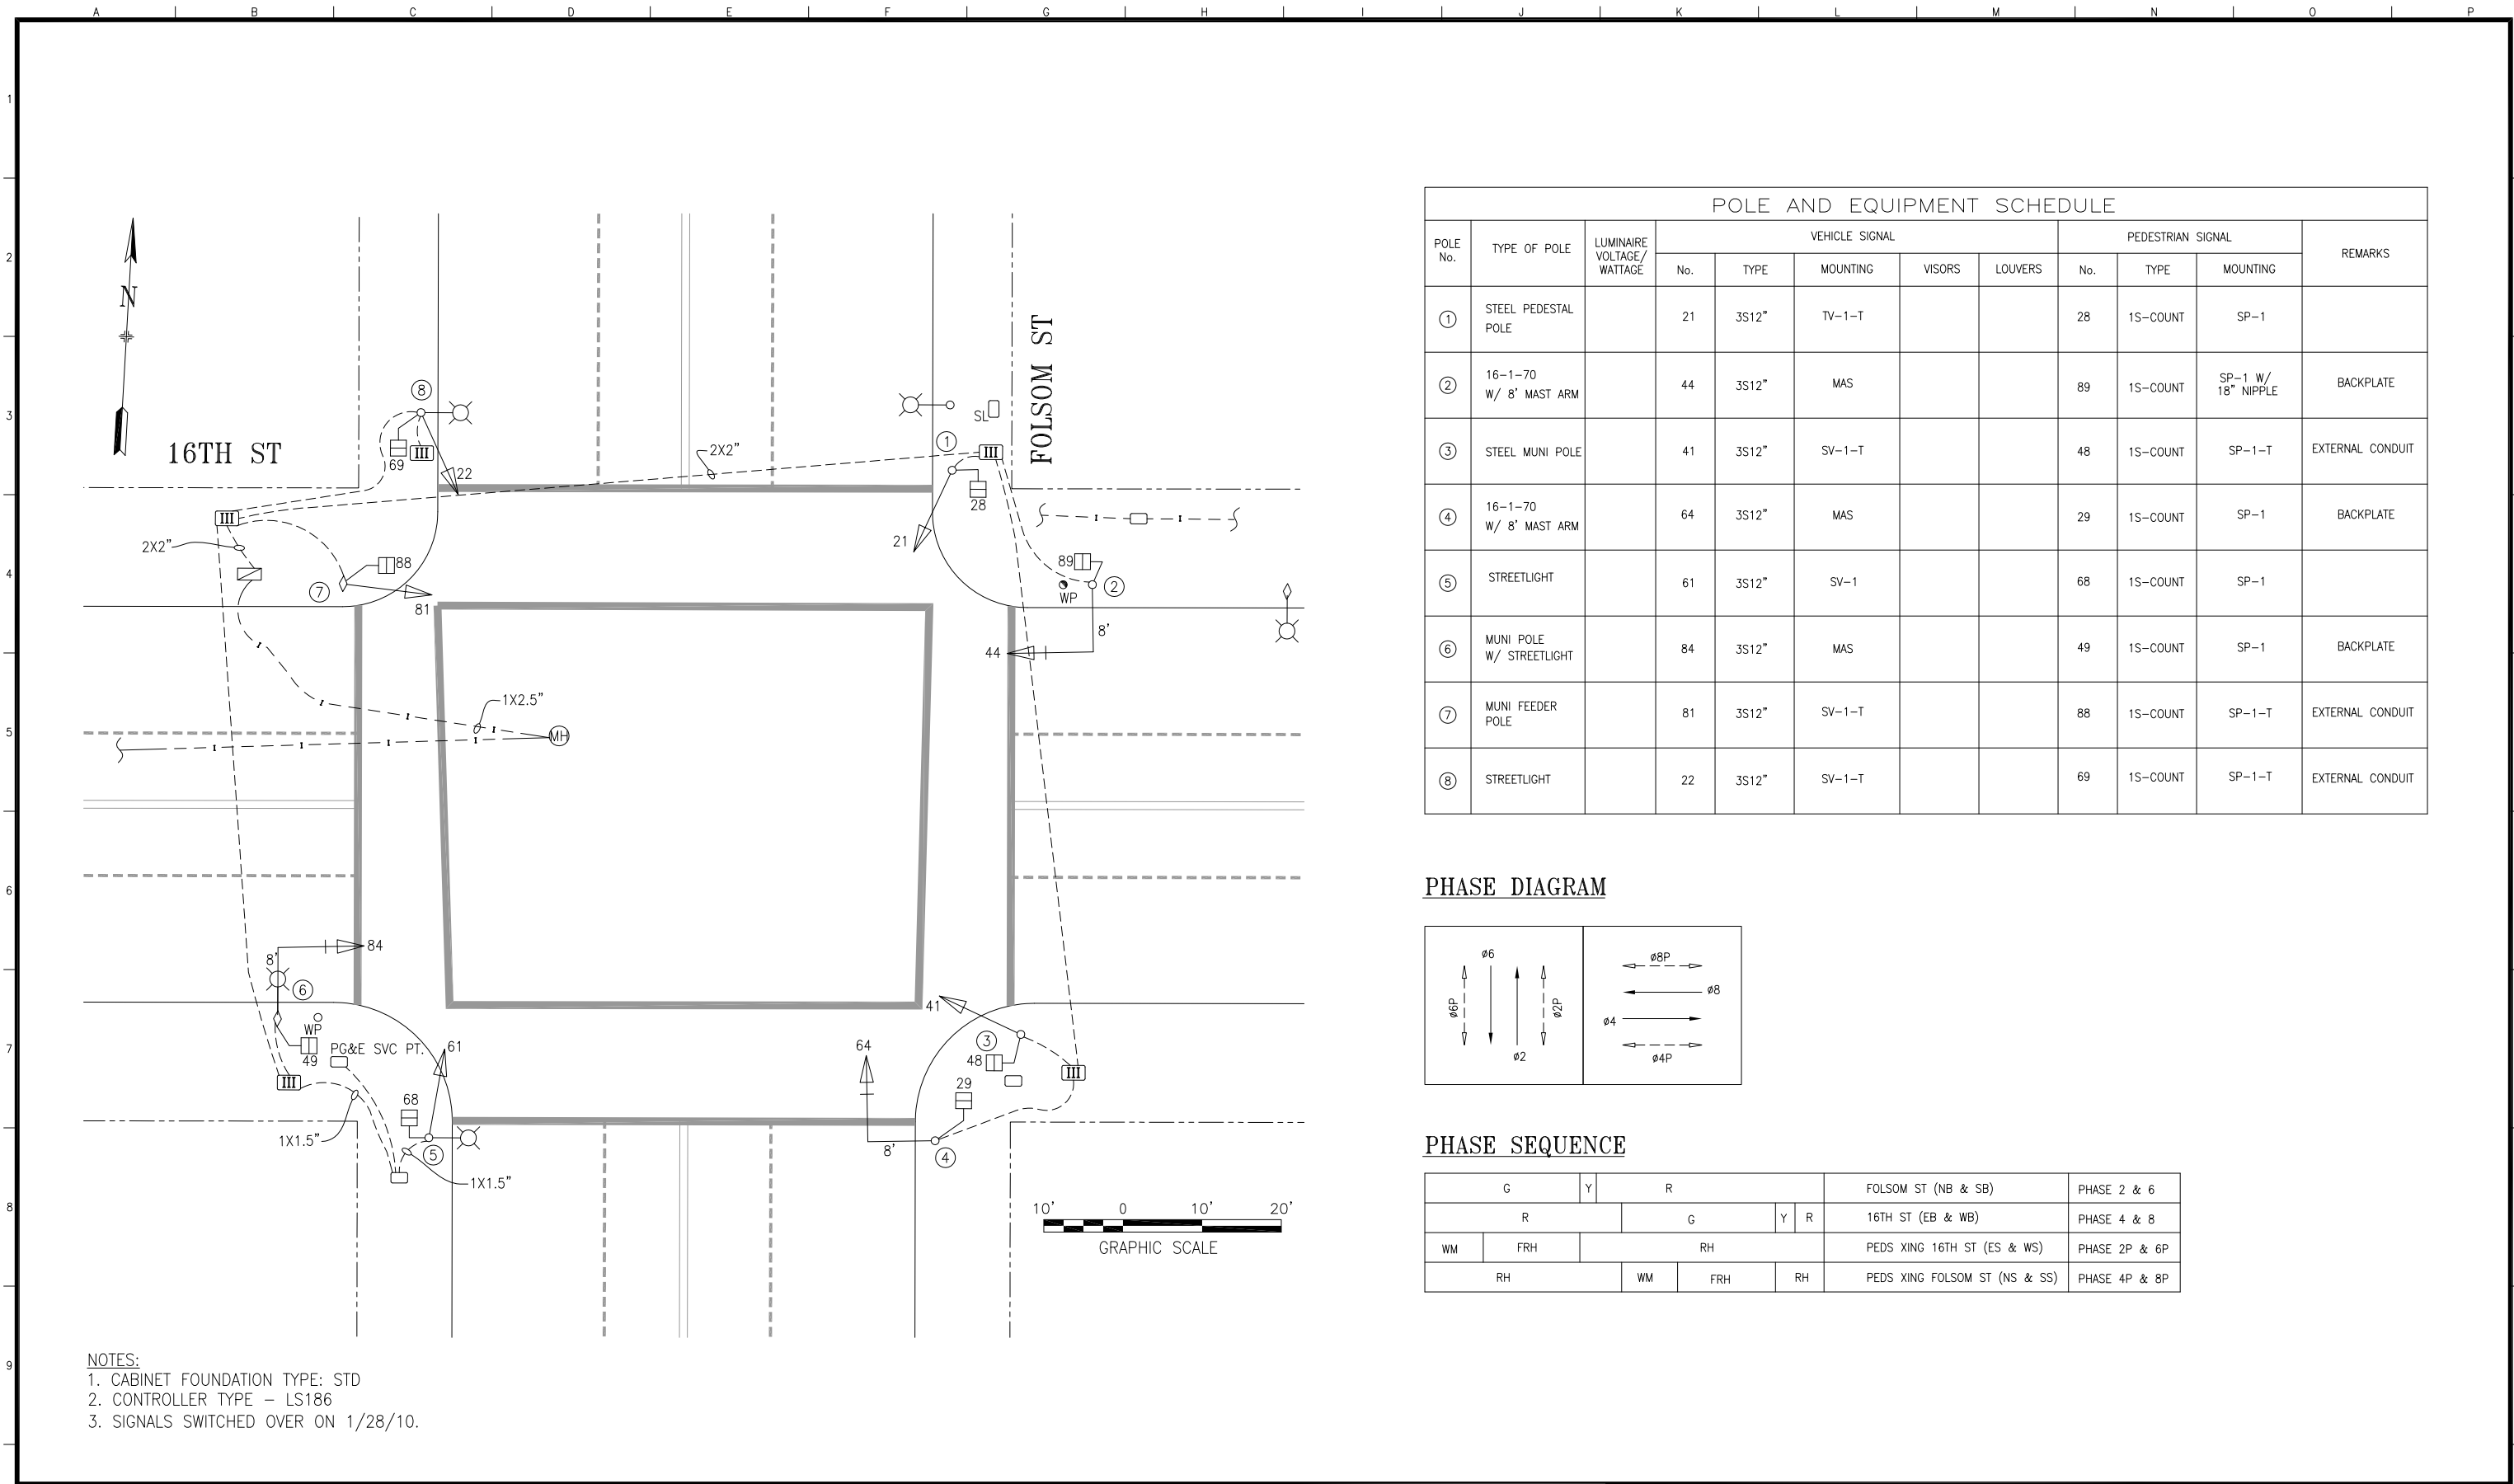


- NOTES:
1. CABINET FOUNDATION TYPE: STD
 2. CONTROLLER TYPE - LS186
 3. SIGNALS SWITCHED OVER ON 1/28/10.

POLE AND EQUIPMENT SCHEDULE

POLE No.	TYPE OF POLE	LUMINAIRE VOLTAGE/ WATTAGE	VEHICLE SIGNAL					PEDESTRIAN SIGNAL			REMARKS
			No.	TYPE	MOUNTING	VISORS	LOUVERS	No.	TYPE	MOUNTING	
①	STEEL PEDESTAL POLE		21	3S12"	TV-1-T			28	1S-COUNT	SP-1	
②	16-1-70 W/ 8' MAST ARM		44	3S12"	MAS			89	1S-COUNT	SP-1 W/ 18" NIPPLE	BACKPLATE
③	STEEL MUNI POLE		41	3S12"	SV-1-T			48	1S-COUNT	SP-1-T	EXTERNAL CONDUIT
④	16-1-70 W/ 8' MAST ARM		64	3S12"	MAS			29	1S-COUNT	SP-1	BACKPLATE
⑤	STREETLIGHT		61	3S12"	SV-1			68	1S-COUNT	SP-1	
⑥	MUNI POLE W/ STREETLIGHT		84	3S12"	MAS			49	1S-COUNT	SP-1	BACKPLATE
⑦	MUNI FEEDER POLE		81	3S12"	SV-1-T			88	1S-COUNT	SP-1-T	EXTERNAL CONDUIT
⑧	STREETLIGHT		22	3S12"	SV-1-T			69	1S-COUNT	SP-1-T	EXTERNAL CONDUIT

PHASE DIAGRAM

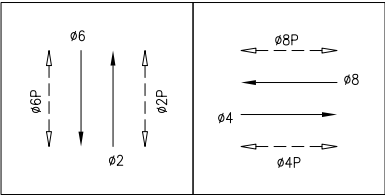

PHASE SEQUENCE

G	Y	R		FOLSOM ST (NB & SB)	PHASE 2 & 6
R		G	Y R	16TH ST (EB & WB)	PHASE 4 & 8
WM	FRH	RH		PEDS XING 16TH ST (ES & WS)	PHASE 2P & 6P
RH		WM	FRH RH	PEDS XING FOLSOM ST (NS & SS)	PHASE 4P & 8P

NO.	DATE	DESCRIPTION	BY	APP.
1	3/5/10	UPDATE PER FIELD -- UPGRADE ALL SIGNALS TO 12" (SIGNALS 21, 22, 41, 61, 81)	DY	CH
0	1/28/10	PED SIGNAL UPGRADE --PROP K FUNDS FY 05/06, MUNI 22 FILLMORE OVERHEAD UPGRADE	DY	CH
TABLE OF REVISIONS				
CHECK WITH TRACING TO SEE IF YOU HAVE LATEST REVISION				

COMPLETION DATE /
ELECTRICIAN INITIAL



DEPARTMENT OF PARKING AND TRAFFIC
DIVISION OF TRAFFIC ENGINEERING
CITY AND COUNTY OF SAN FRANCISCO

DRAWN: DATE: SCALE:
DY 3/10 1" = 10'
CHECKED: DATE: SHEET OF SHEETS
CH 9/2014 1 OF 1

TRAFFIC SIGNAL INVENTORY DIAGRAM

16TH ST AND FOLSOM ST

CNN NO.
24138000
REV. NO.
1