


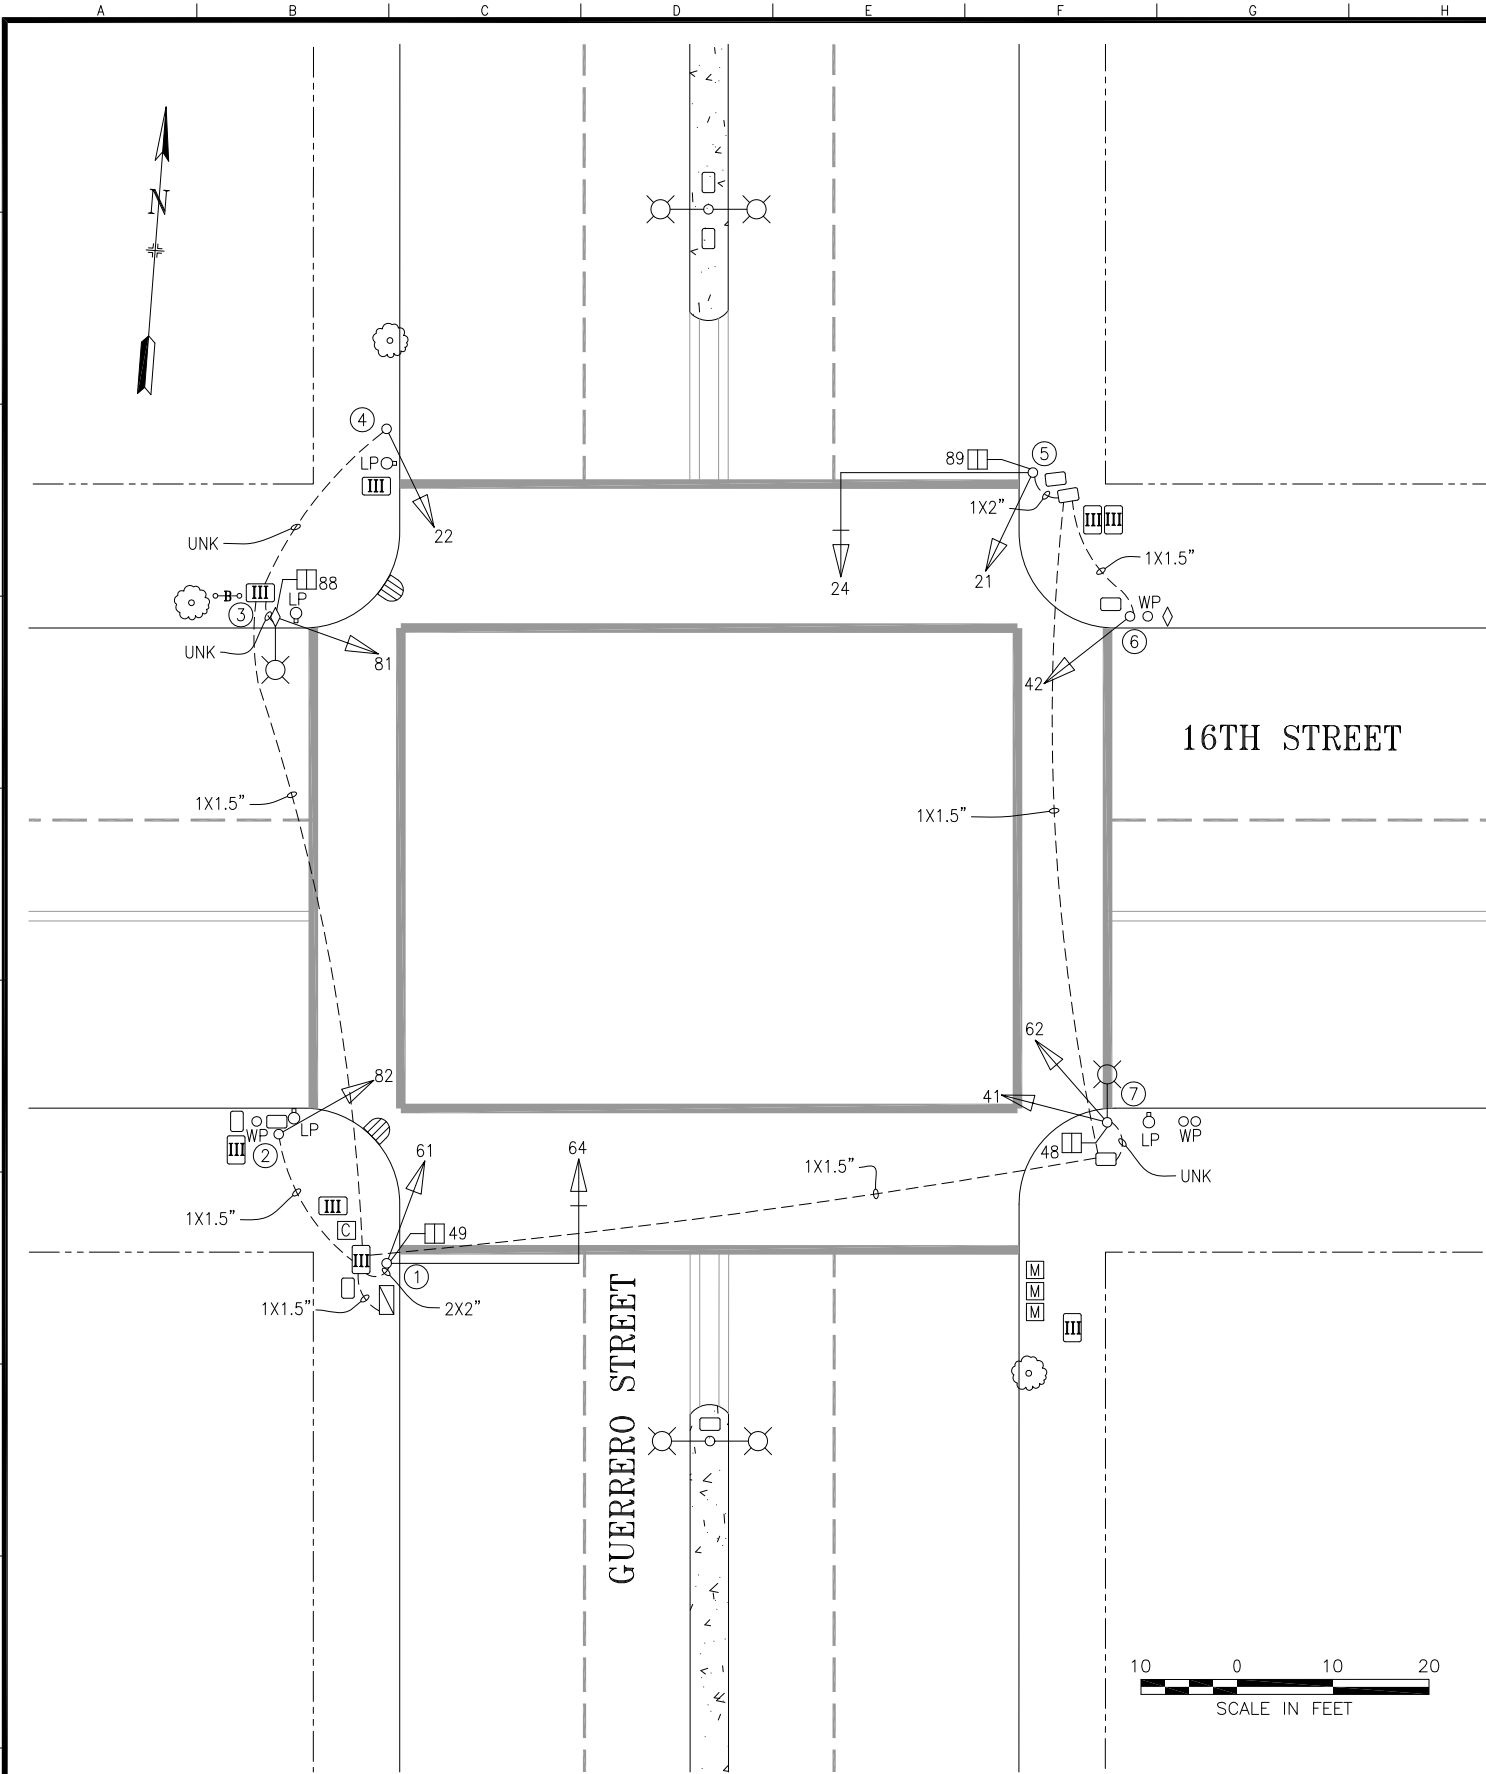

POLE AND EQUIPMENT SCHEDULE											
POLE No.	TYPE OF POLE	LUMINAIRE VOLTAGE/ WATTAGE	VEHICLE SIGNAL					PEDESTRIAN SIGNAL			REMARKS
			No.	TYPE	MOUNTING	VISORS	LOUVERS	No.	TYPE	MOUNTING	
①	16-1-70 W/20' SIGNAL MAST ARM		64 61	3S12" 3S12"	MAS SV-1-T	T T		49	1S-COUNT	SP-1	BACKPLATE
②	1-A (10')		82	3S12"	TV-1-T	T					
③	MUNI POLE & STREET LIGHT		81	3S12"	SV-1-T	T		88	1S-COUNT	SP-1	EXTERNAL CONDUIT
④	1-A (10')		22	3S12"	TV-1-T	T					
⑤	16-1-70 W/20' SIGNAL MAST ARM		24 21	3S12" 3S12"	MAS SV-1-T	T T		89	1S-COUNT	SP-1	BACKPLATE
⑥	1-A (10')		42	3S12"	TV-1-T	T					
⑦	CITY STANDARD STREET LIGHT		41 62	3S12" 3S12"	SV-2-TA	T T		48	1S-COUNT	SP-1	

0	8/4/15	2543J PUNCHLIST WALKTHROUGH	DY	MV	
NO.	DATE	DESCRIPTION	BY	APP.	
TABLE OF REVISIONS					
CHECK WITH TRACING TO SEE IF YOU HAVE LATEST REVISION					

REFERENCE INFORMATION & FILE NO. OF SURVEYS



SAN FRANCISCO MUNICIPAL TRANSPORTATION AGENCY

CITY AND COUNTY OF SAN FRANCISCO

DRAWN:	DATE:
ASCALES	9/2015
CHECKED:	DATE:
MYELASCO	9/2015

SCALE:
AS SHOWN
SHEET OF SHEETS
1 OF 1

TRAFFIC SIGNAL INVENTORY DIAGRAM
16TH STREET AND GUERRERO STREET

CNN NO.
25698000
REV NO.
0