


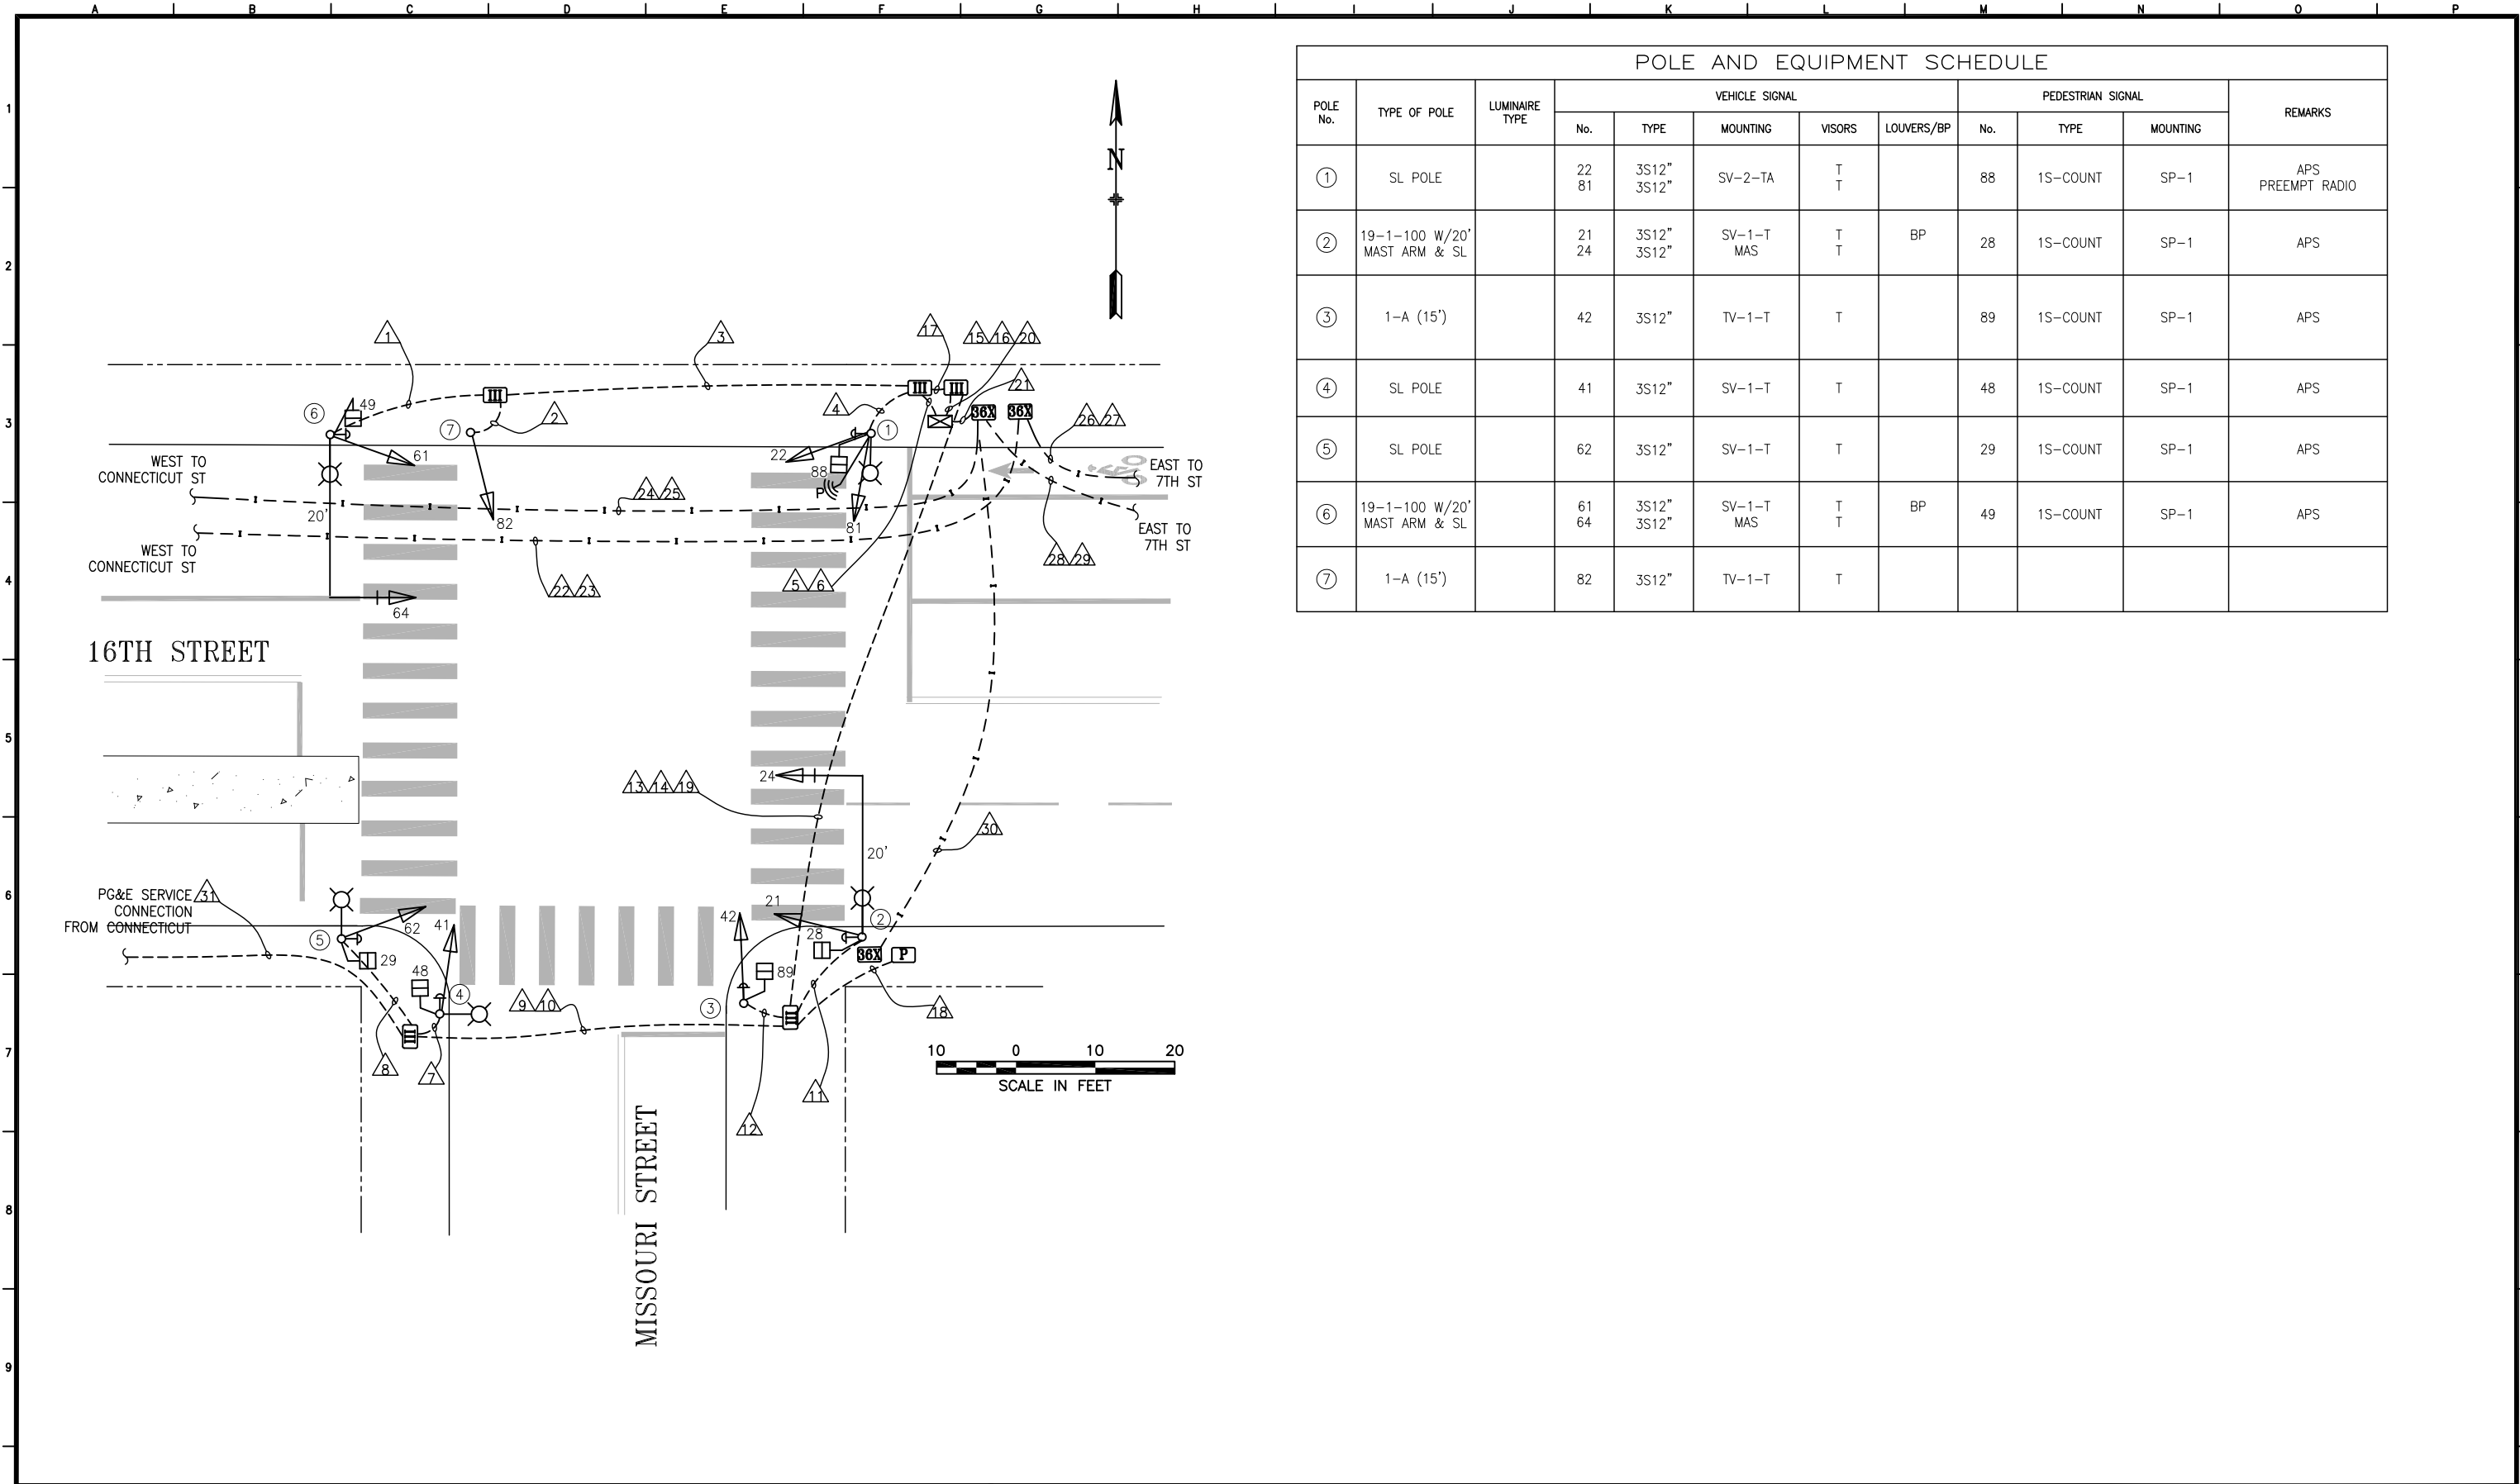

POLE AND EQUIPMENT SCHEDULE											
POLE No.	TYPE OF POLE	LUMINAIRE TYPE	VEHICLE SIGNAL					PEDESTRIAN SIGNAL			REMARKS
			No.	TYPE	MOUNTING	VISORS	LOUVERS/BP	No.	TYPE	MOUNTING	
①	SL POLE		22 81	3S12" 3S12"	SV-2-TA	T T		88	1S-COUNT	SP-1	APS PREEMPT RADIO
②	19-1-100 W/20' MAST ARM & SL		21 24	3S12" 3S12"	SV-1-T MAS	T T	BP	28	1S-COUNT	SP-1	APS
③	1-A (15')		42	3S12"	TV-1-T	T		89	1S-COUNT	SP-1	APS
④	SL POLE		41	3S12"	SV-1-T	T		48	1S-COUNT	SP-1	APS
⑤	SL POLE		62	3S12"	SV-1-T	T		29	1S-COUNT	SP-1	APS
⑥	19-1-100 W/20' MAST ARM & SL		61 64	3S12" 3S12"	SV-1-T MAS	T T	BP	49	1S-COUNT	SP-1	APS
⑦	1-A (15')		82	3S12"	TV-1-T	T					

0	06/01/20	CONVERTED FROM CONTRACT: NEW SIGNAL ACTIVATED THROUGH 1303R	S. ARIAS	D. ALABA
NO.	DATE	DESCRIPTION	BY	APPROVED
TABLE OF REVISIONS				
CHECKOUT DRAWING THROUGH THE SID CUSTODIAN FOR THE LATEST REVISION				



SFMTA

DRAWN BY: S. ARIAS	DATE: 8/30/21
CHECKED BY: D. ALABA	DATE: 6/6/23

SCALE AS SHOWN
SHEET OF SHEETS 01 OF 02

TRAFFIC SIGNAL INVENTORY DIAGRAM
16TH STREET AND MISSOURI STREET

CNN NO: 23787000
REV NO: 0

