




POLE AND EQUIPMENT SCHEDULE											
POLE No.	TYPE OF POLE	LUMINAIRE TYPE	VEHICLE SIGNAL					PEDESTRIAN SIGNAL			REMARKS
			No.	TYPE	MOUNTING	VISORS	LOUVERS/BP	No.	TYPE	MOUNTING	
①	SL POLE		81	3S12"	SV-1-T	T		88	1S-COUNT	SP-1	APS PREEMPT RADIO
②	1-A (13')		22	3S12"	TV-1-T	T		69	1S-COUNT	SP-1	APS
③	TROLLEY POLE W/ 8' MAST ARM & SL		24 21	3S12" 3S12"	MAS SV-1-T	T T	BP	28	1S-COUNT	SP-1	APS TROLLEY POLE #1889
④	SL POLE		42	3S12"	SV-1-T	T		89	1S-COUNT	SP-1	APS
⑤	1-A (10')		41	3S12"	TV-1-T	T		48	1S-COUNT	SP-1	APS
⑥	SL POLE		62	3S12"	SV-1-T	T		29	1S-COUNT	SP-1	APS
⑦	TROLLEY POLE W/ 8' MAST ARM		61 64	3S12" 3S12"	MAS SV-1-T	T T	BP	68	1S-COUNT	SP-1	APS TROLLEY POLE #1906
⑧	1-A (10')		82	3S12"	TV-1-T			49	1S-COUNT	SP-1	APS

0	05/28/20	CONVERTED FROM CONTRACT: NEW SIGNAL ACTIVATED THROUGH 1303R	S. ARIAS	D. ALABA
NO.	DATE	DESCRIPTION	BY	APPROVED

TABLE OF REVISIONS
CHECKOUT DRAWING THROUGH THE SID CUSTODIAN FOR THE LATEST REVISION

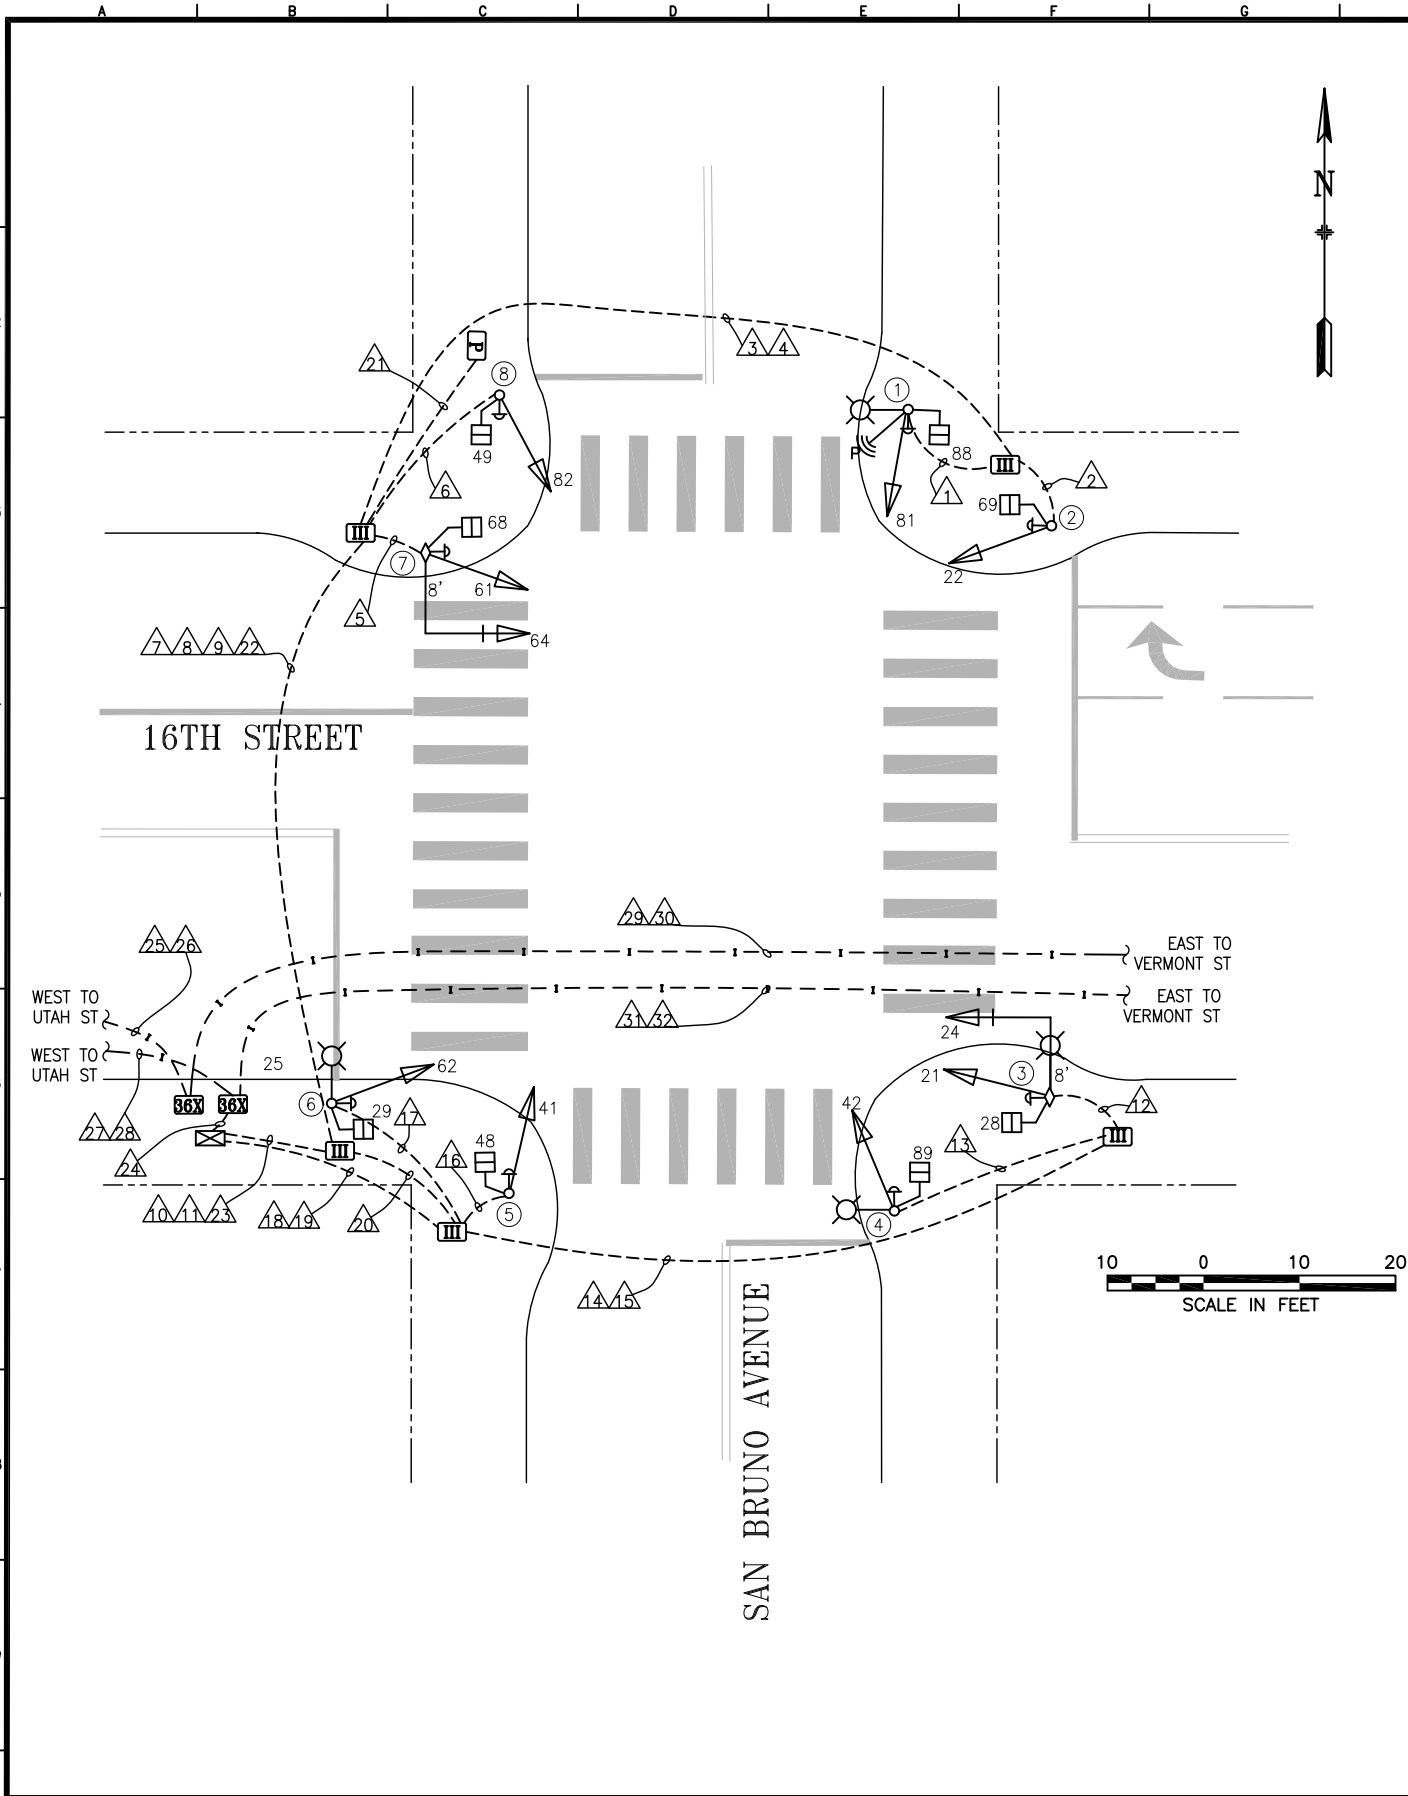

SFMTA

DRAWN BY: S. ARIAS	DATE: 8/25/21
CHECKED BY: D. ALABA	DATE: 6/6/23

SCALE AS SHOWN	TRAFFIC SIGNAL INVENTORY DIAGRAM	CNN NO: 23781000
SHEET OF SHEETS 01 OF 02		REV NO: 0

