


SANCHEZ & 16th ST.

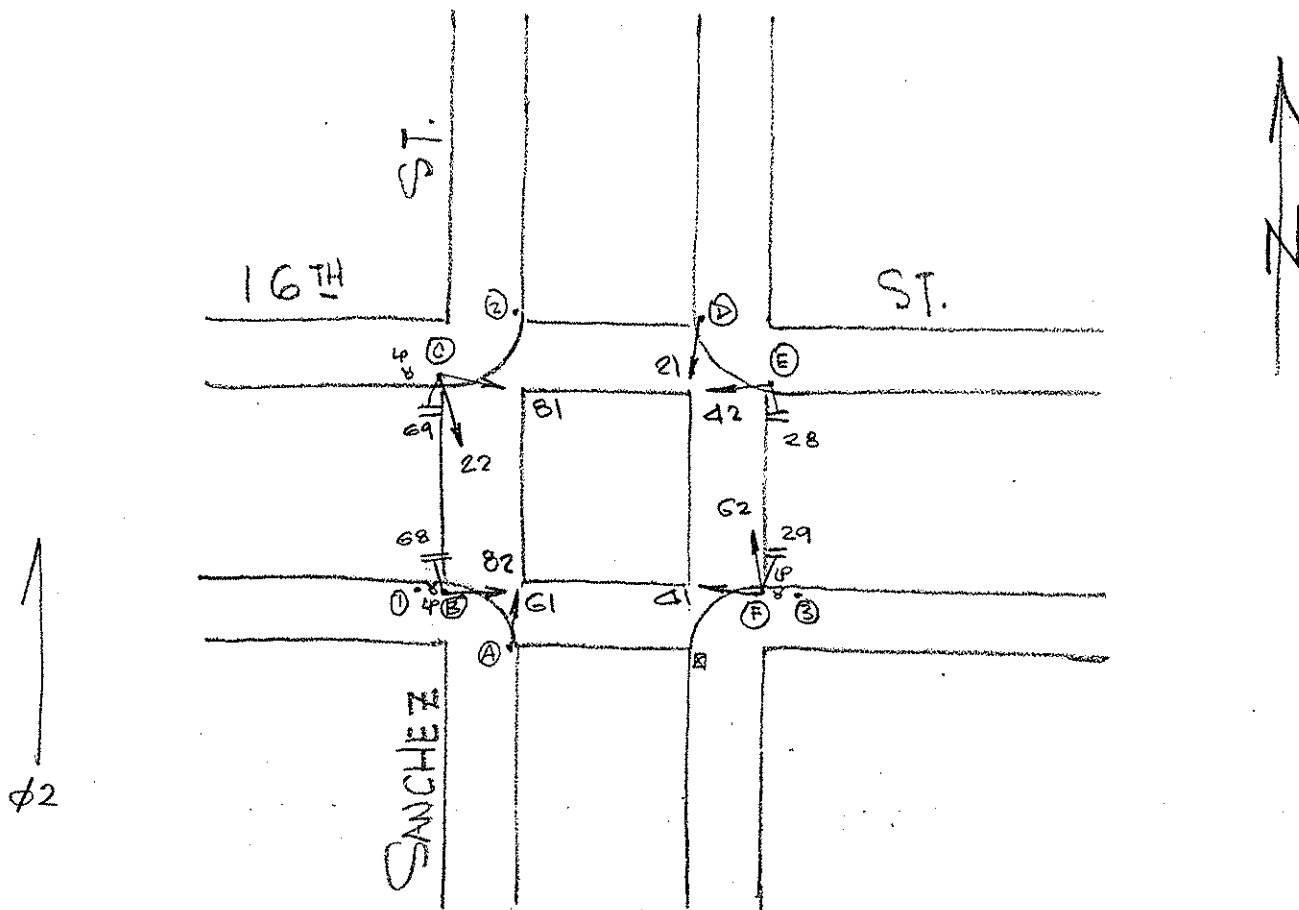

10-29-91

[illegible]

CONTROLLER CABINET SIZE : ORDINARY BASE CABINET: YES

COMMENTS: Replaced ped. signal #68 with ICC