


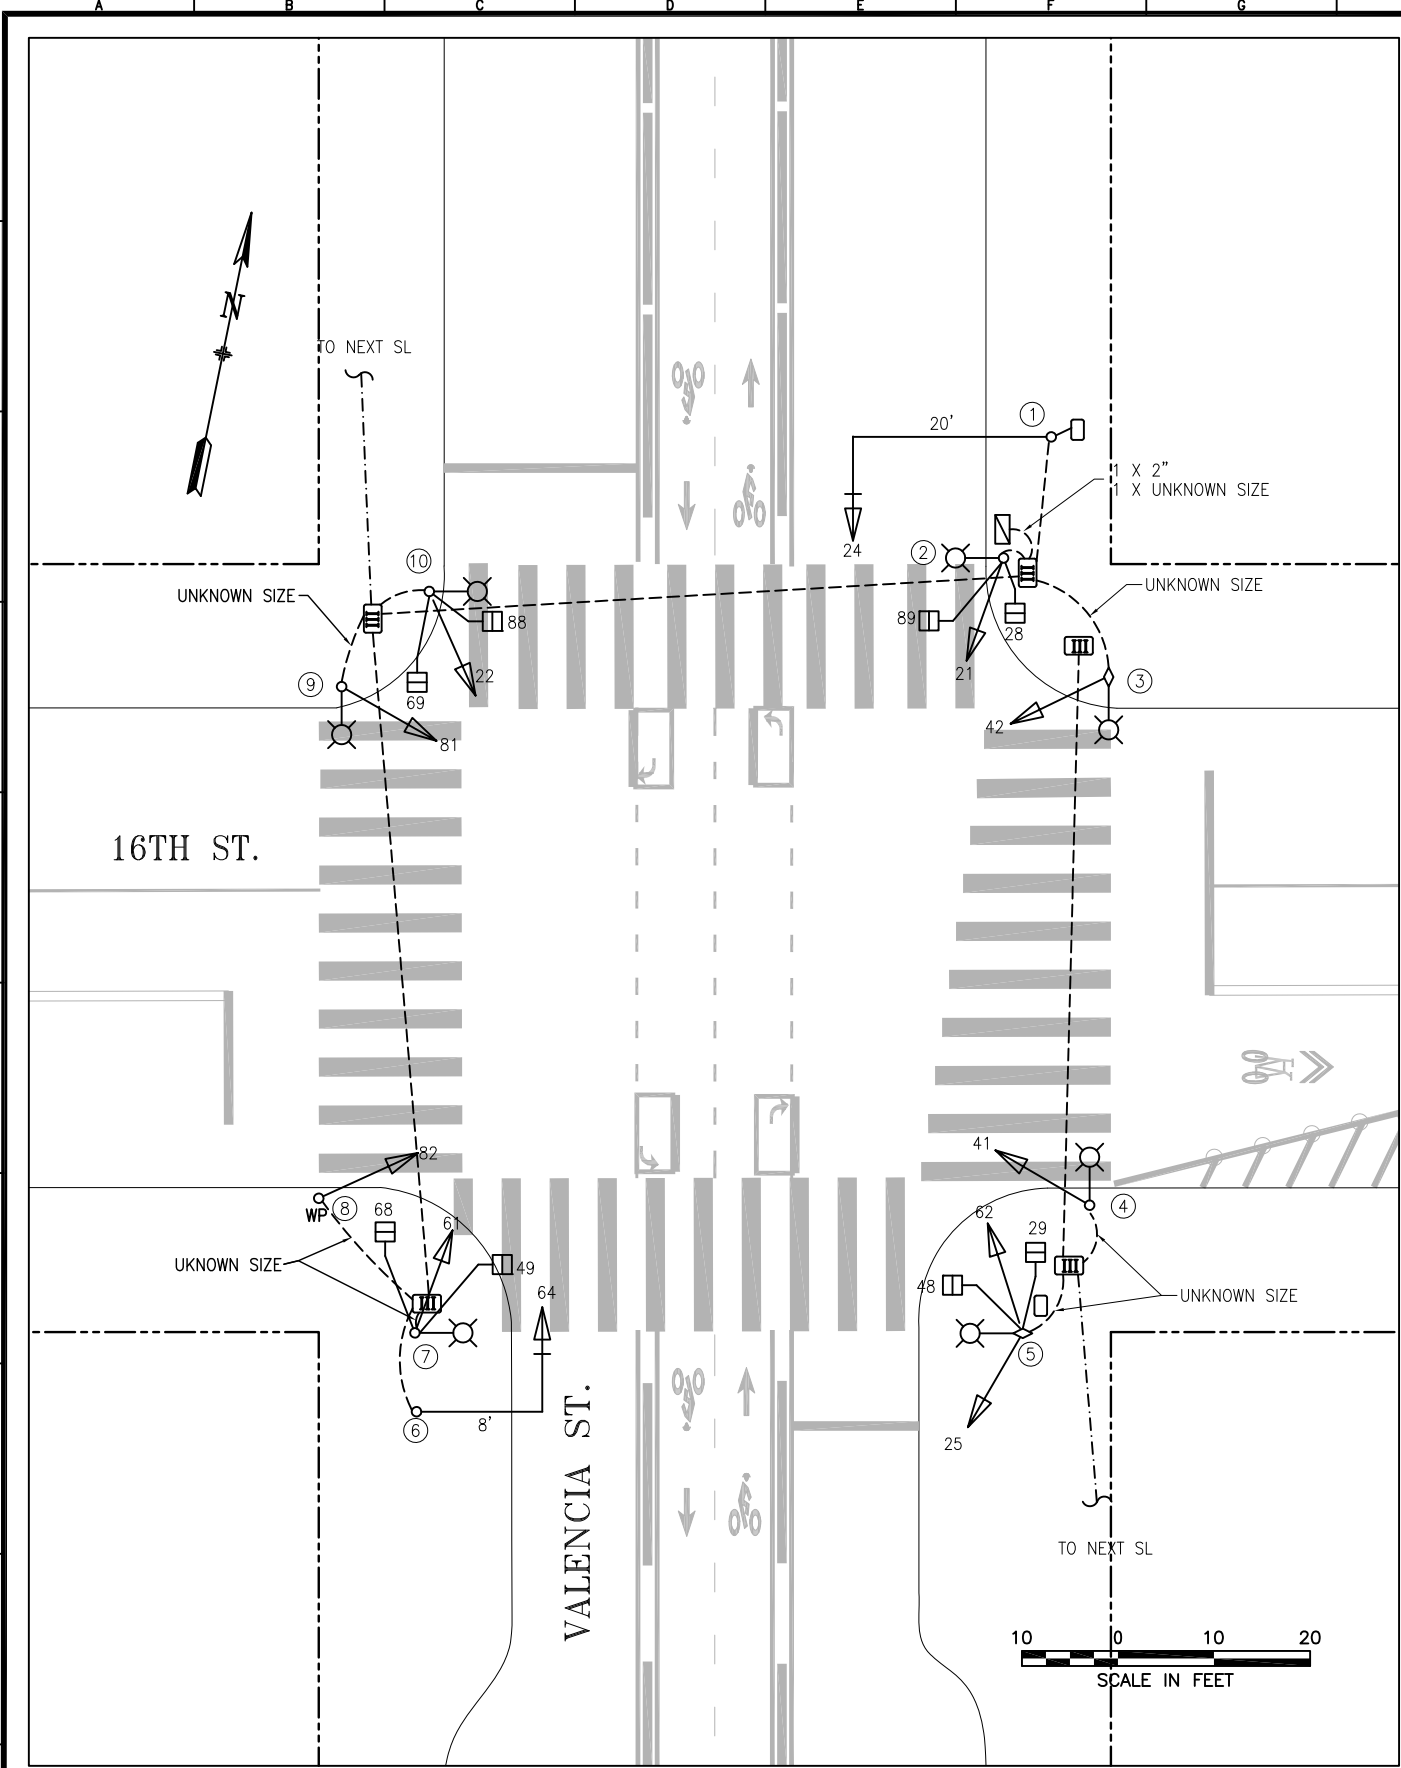

POLE AND EQUIPMENT SCHEDULE										
POLE No.	TYPE OF POLE	VEHICLE SIGNAL					PEDESTRIAN SIGNAL			REMARKS
		No.	TYPE	MOUNTING	VISORS	LOUVERS	No.	TYPE	MOUNTING	
①	16-1-70 WITH 20' MAST ARM	24	3S12"	MAS	T					BP
②	SL	21	3S12"	SV-1-T	T		28 89	1S-COUNT 1S-COUNT	SP-1 SP-1	
③	SL/MUNI POLE	42	3S12"	SV-1-T	T					EXTERNAL CONDUIT
④	SL	41	3S12"	SV-1-T	T					
⑤	SL/MUNI POLE	62	3S12"	SV-1-T	T		29 48	1S-COUNT 1S-COUNT	SP-1 SP-1	
⑥	16-1-70 WITH 8' MAST ARM	64	3S12"	MAS	T					BP
⑦	SL	61	3S12"	SV-1-T	T		49 68	1S-COUNT 1S-COUNT	SP-1 SP-1	
⑧	POWER POLE	82	3S12"	SV-1-T	T					EXTERNAL CONDUIT
⑨	SL/MUNI POLE	81	3S12"	SV-1-T	T					EXTERNAL CONDUIT
⑩	SL	22	3S12"	SV-1-T	T		69 88	1S-COUNT 1S-COUNT	SP-1 SP-1	

Δ	07/07/23	REMOVE SIGNALS 25,65,131,132,151,153. ADD SIGNALS 22 & 62 PER SRC 2023-133.	C.BECK	G.HO	
Δ	03/23/23	ADD BIKE SIGNALS (BAGGED) & UPGRADE ALL TO 3S12" PER SRC 2023-033.	W.LEE	G.HO	
Δ	07/XX/05	ADD ADDITIONAL PED SIGNALS BY SIGNAL SHOP.	C.LEUNG	J.K.	
NO.	DATE	DESCRIPTION	BY	APPROVED	
TABLE OF REVISIONS					
CHECKOUT DRAWING THROUGH THE SID CUSTODIAN FOR THE LATEST REVISION					



SFMTA

DRAWN BY: C.LEUNG	DATE: 04/2003
CHECKED BY: J.K.	DATE: 05/2006

SCALE AS SHOWN
SHEET OF SHEETS 01 OF 01

TRAFFIC SIGNAL INVENTORY DIAGRAM
16th STREET & VALENCIA STREET

CNN NO: 24183000
REV NO: 3