


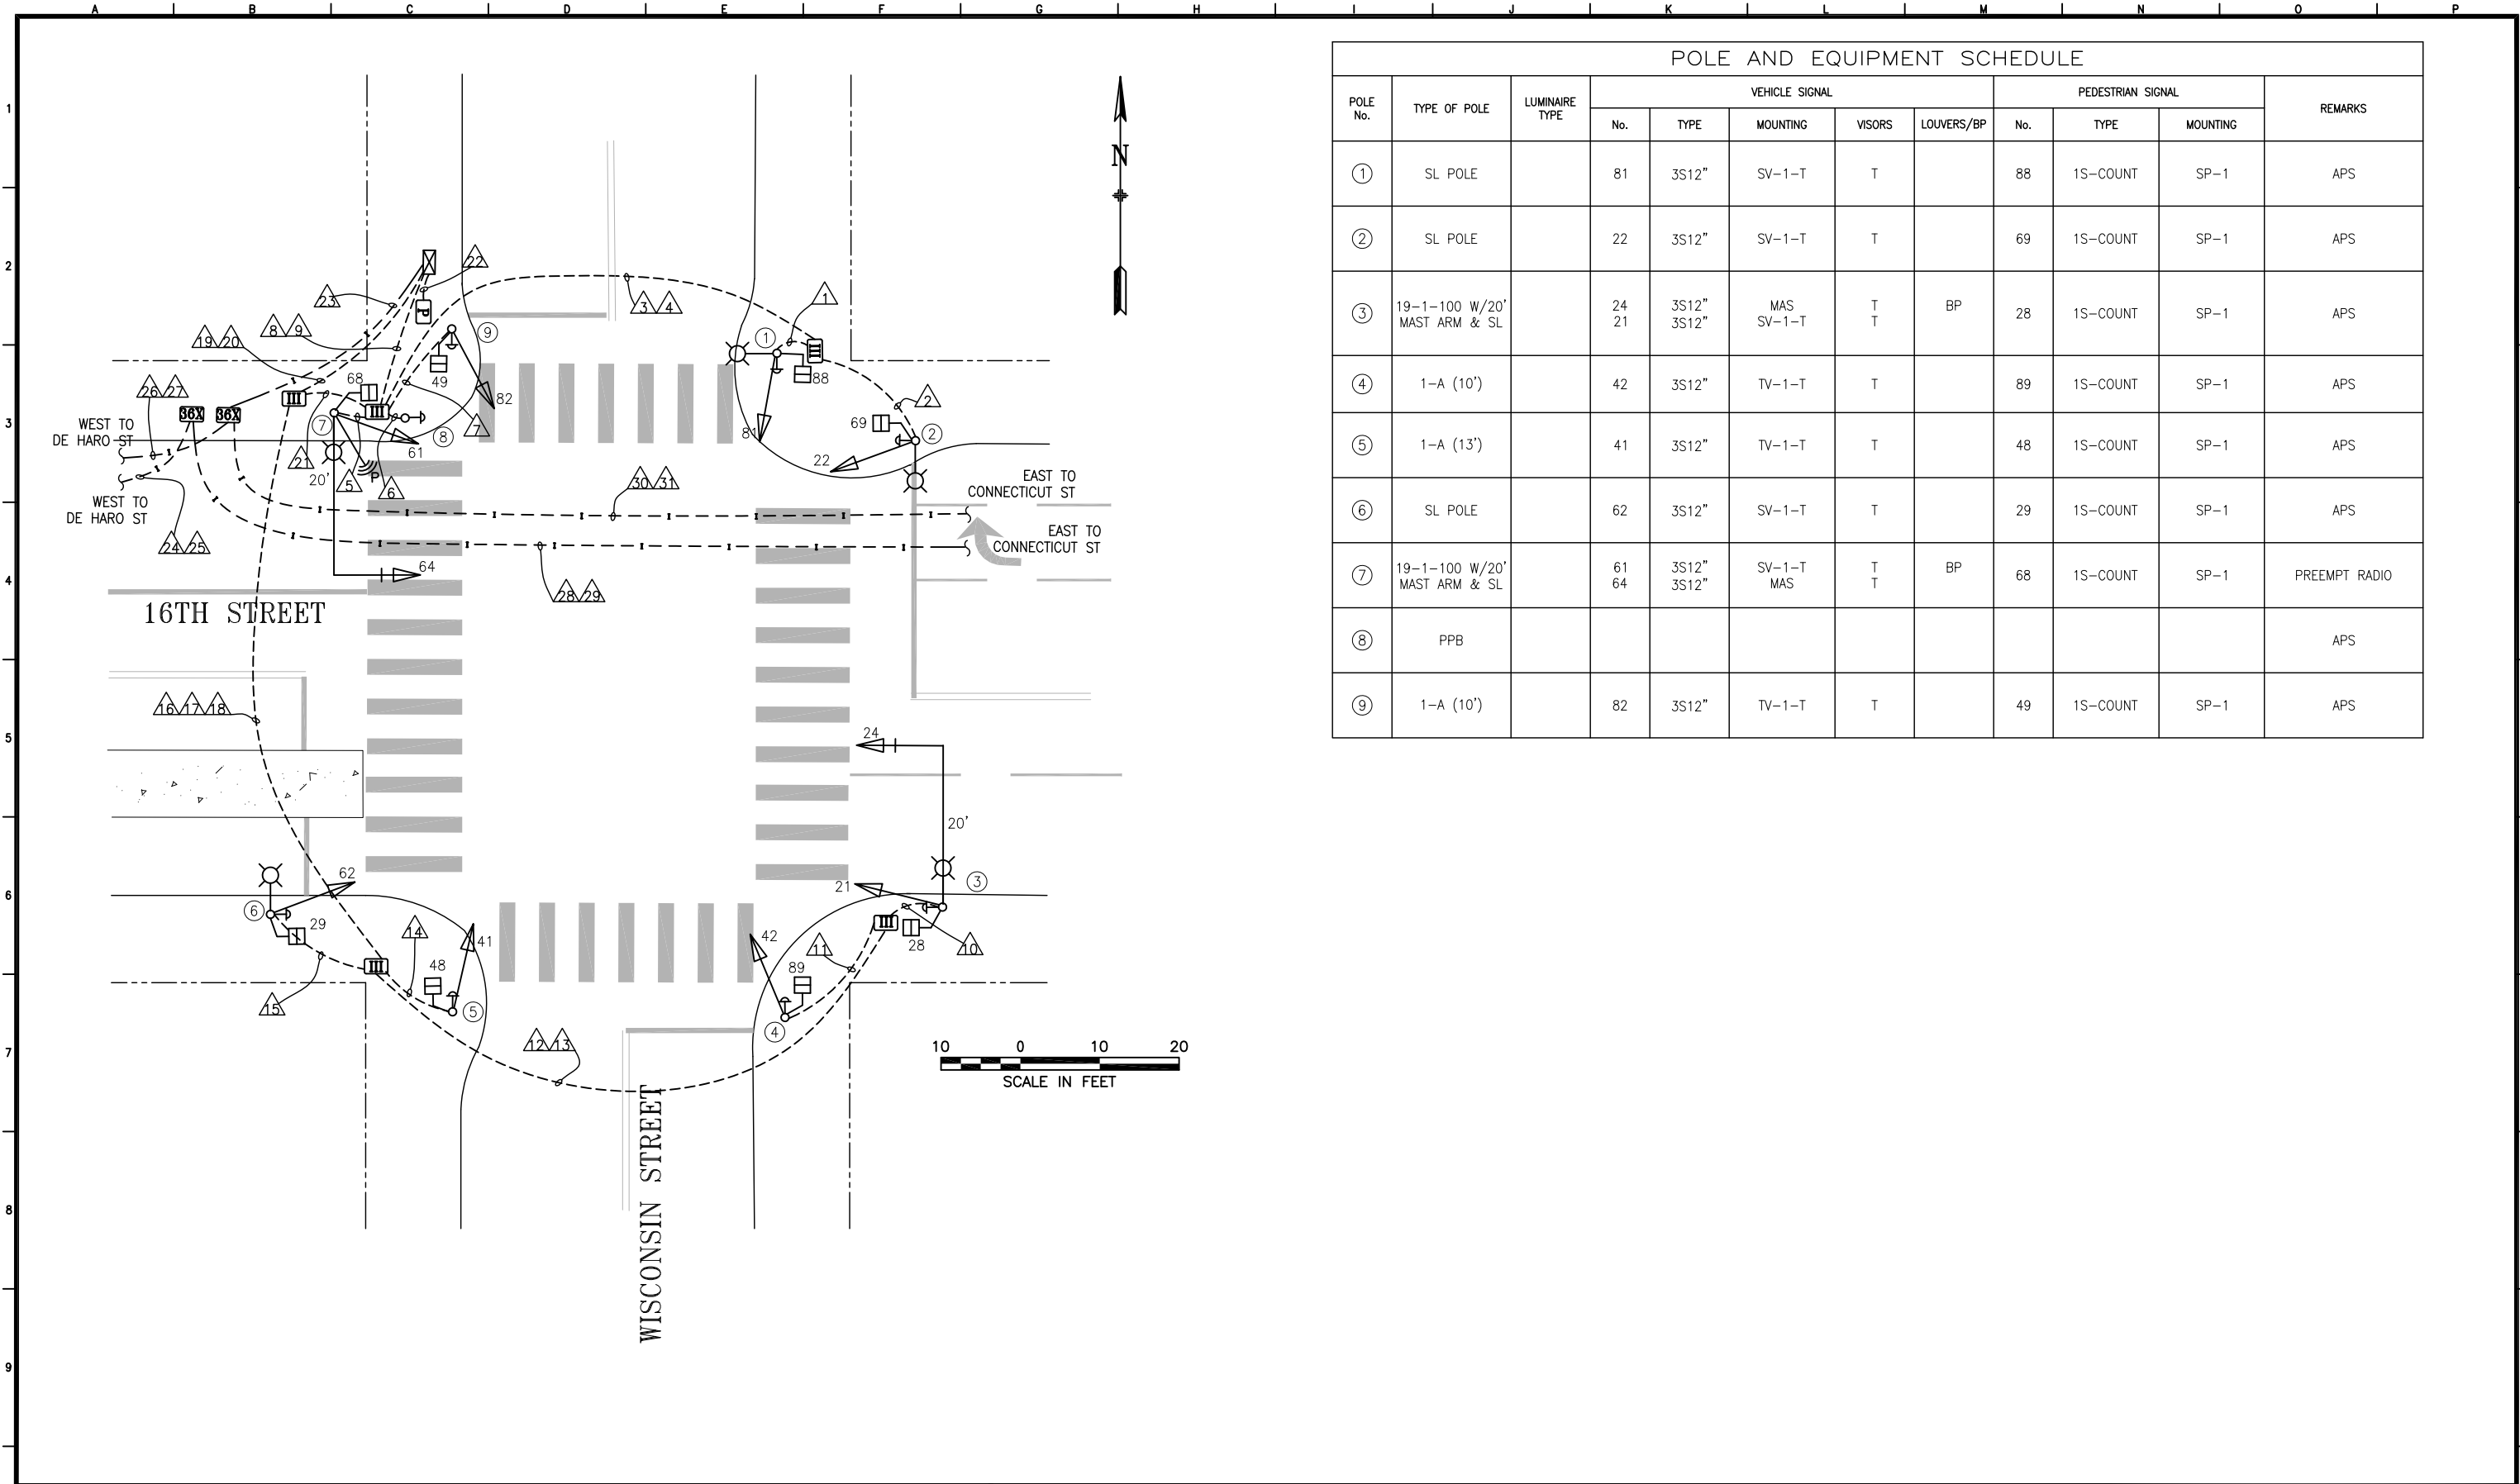

POLE AND EQUIPMENT SCHEDULE											
POLE No.	TYPE OF POLE	LUMINAIRE TYPE	VEHICLE SIGNAL					PEDESTRIAN SIGNAL			REMARKS
			No.	TYPE	MOUNTING	VISORS	LOUVERS/BP	No.	TYPE	MOUNTING	
①	SL POLE		81	3S12"	SV-1-T	T		88	1S-COUNT	SP-1	APS
②	SL POLE		22	3S12"	SV-1-T	T		69	1S-COUNT	SP-1	APS
③	19-1-100 W/20' MAST ARM & SL		24 21	3S12" 3S12"	MAS SV-1-T	T T	BP	28	1S-COUNT	SP-1	APS
④	1-A (10')		42	3S12"	TV-1-T	T		89	1S-COUNT	SP-1	APS
⑤	1-A (13')		41	3S12"	TV-1-T	T		48	1S-COUNT	SP-1	APS
⑥	SL POLE		62	3S12"	SV-1-T	T		29	1S-COUNT	SP-1	APS
⑦	19-1-100 W/20' MAST ARM & SL		61 64	3S12" 3S12"	SV-1-T MAS	T T	BP	68	1S-COUNT	SP-1	PREEMPT RADIO
⑧	PPB										APS
⑨	1-A (10')		82	3S12"	TV-1-T	T		49	1S-COUNT	SP-1	APS

0	06/04/20	CONVERTED FROM CONTRACT: NEW SIGNAL ACTIVATED THROUGH 1303R	S. ARIAS	D. ALABA	
NO.	DATE	DESCRIPTION	BY	APPROVED	
TABLE OF REVISIONS					
CHECKOUT DRAWING THROUGH THE SID CUSTODIAN FOR THE LATEST REVISION					



SFMTA

DRAWN BY:	DATE:
S. ARIAS	8/25/21
CHECKED BY:	DATE:
D. ALABA	6/6/23

SCALE
AS SHOWN
SHEET OF SHEETS
01 OF 02

TRAFFIC SIGNAL INVENTORY DIAGRAM
16TH STREET AND WISCONSIN STREET

CNN NO:
23746000
REV NO:
0

