




POLE AND EQUIPMENT SCHEDULE											
POLE No.	TYPE OF POLE	LUMINAIRE VOLTAGE/ WATTAGE	VEHICLE SIGNAL					PEDESTRIAN SIGNAL			REMARKS
			No.	TYPE	MOUNTING	VISORS	LOUVERS	No.	TYPE	MOUNTING	
①	CITY STANDARD STREETLIGHT	100W HPS	81	3S12"	SV-1-T	T		88	1S-COUNT	SP-1	APS-2W
②	1-A (10')							69	1S-COUNT	SP-1	APS-2W
③	CITY STANDARD STREETLIGHT WITH TWO LA		23	3S12"	SV-1-T	T					
④	1-A (10')		21	3S12"	TV-1-T	T		28	1S-COUNT	SP-1	APS-2W
⑤	1-A (10')		42	3S12"	TV-1-T	T		89	1S-COUNT	SP-1	APS-2W
⑥	1-A (10')		41	3S12"	TV-1-T (30")	T		48	1S-COUNT	SP-1(30")	
⑦	1-A (10')							29	1S-COUNT	SP-1	APS-2W
⑧	CITY STANDARD STREETLIGHT WITH TWO LA		63	3S12"	SV-1-T	T					
⑨	1-A (10')		61	3S12"	TV-1-T	T		68	1S-COUNT	SP-1	APS-2W
⑩	1-A (10')		82	3S12"	TV-1-T	T		49	1S-COUNT	SP-1	APS-2W
⑪	PPB POLE										APS-2W

NO.	DATE	DESCRIPTION	BY	APP.
2	8/9/19	CHANGE SIGNAL 41 MOUNT TO TV-1-T(30") PER FIELD CHECK	D.YEUNG	G.DELEON
1	4/11/19	INSTALL APS - SRC 2018-155	D.YEUNG	G.DELEON
0	03/15/17	SIGNAL UPGRADED THROUGH 2595J	D.YEUNG	G.DELEON
TABLE OF REVISIONS CHECK WITH TRACING TO SEE IF YOU HAVE LATEST REVISION				

REFERENCE INFORMATION & FILE NO. OF SURVEYS
--

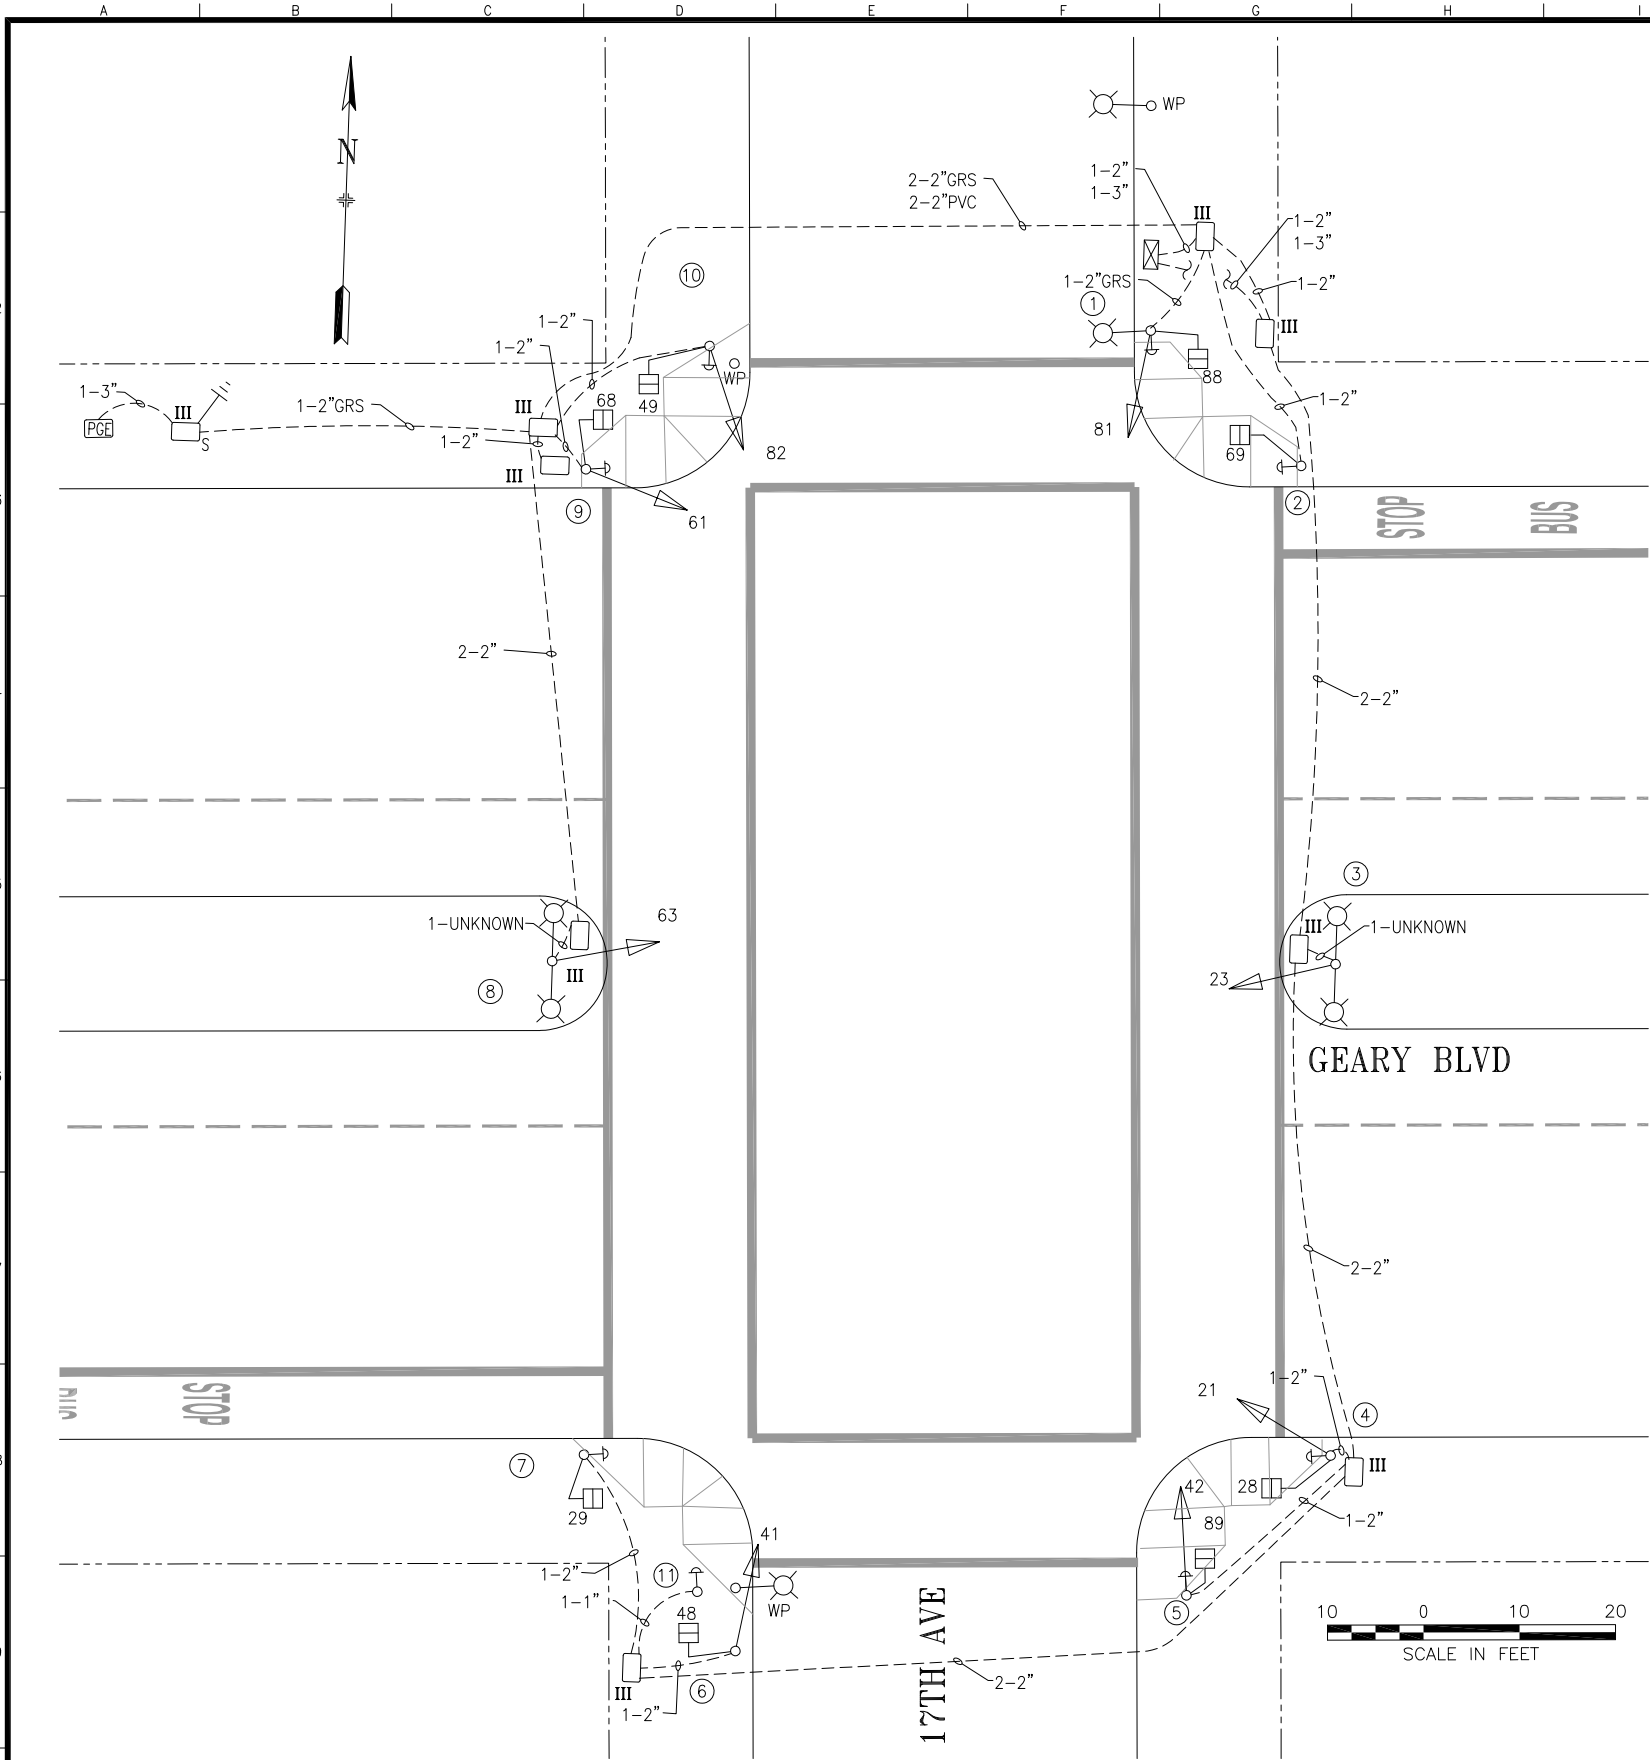

SAN FRANCISCO MUNICIPAL TRANSPORTATION AGENCY
CITY AND COUNTY OF SAN FRANCISCO

DRAWN:	DATE:
D YEUNG	10/5/18
CHECKED:	DATE:
G DE LEON	10/9/18

SCALE:
AS SHOWN
SHEET OF SHEETS
OF

TRAFFIC SIGNAL INVENTORY DIAGRAM
17TH AVENUE AND GEARY BOULEVARD

CNN NO.
27500000
REV NO.
2