



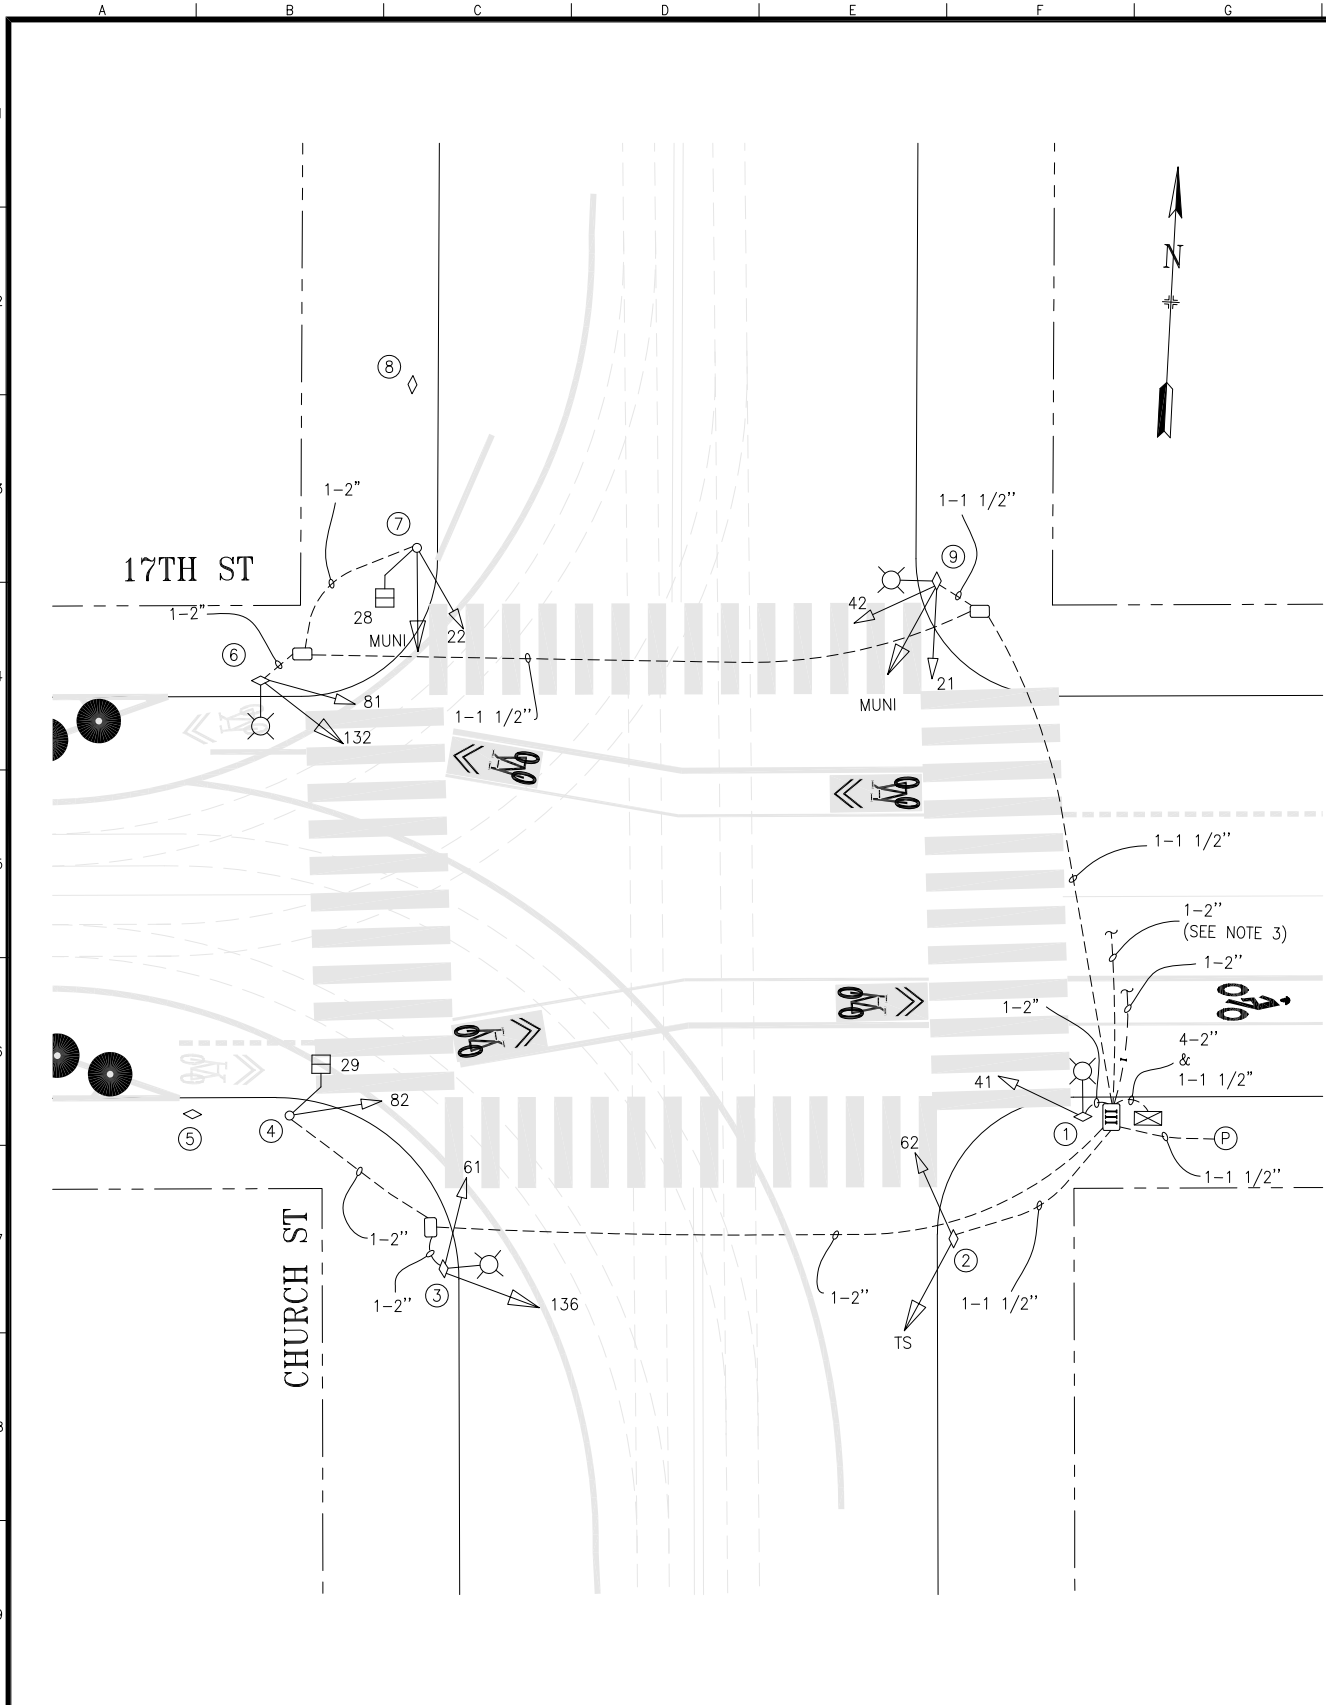

POLE AND EQUIPMENT SCHEDULE										
POLE No.	TYPE OF POLE	VEHICLE SIGNAL					PEDESTRIAN SIGNAL			REMARKS
		No.	TYPE	MOUNTING	VISORS	LOUVERS	No.	TYPE	MOUNTING	
①	MUNI POLE WITH LUMINAIRE (POLE #3695)	41	3S8"	SV-1	FC					
②	MUNI POLE (POLE #509)	62 TS	3S8" 4S12"	SV-1 SV-1	FC T					BOTH SV-1 MOUNTINGS CONNECTED VIA EXTERNAL CONDUIT
③	MUNI POLE WITH LUMINAIRE (POLE #508)	61 136	3S8" 2S12" LB	SV-1-T SV-1	FC T					BOTH MOUNTINGS ON POLE 3 CONNECTED VIA EXTERNAL CONDUIT
④	1-A (10')	82	3S8"	TV-1-UM	FC		29	1S-COUNT	SP-1	
⑤	MUNI POLE (POLE #3709)									
⑥	MUNI POLE (POLE #3704)	81 136	3S8" 2S12" LB	SV-1 SV-1	FC T					
⑦	1-A (10')	22 MUNI	3S8" 2S12" LB		FC T		28	1S-COUNT	SP-1	MUNI SIGNAL NOT USED
⑧	MUNI POLE (POLE #498)									
⑨	MUNI POLE (POLE #497)	21 42 MUNI	3S8" 3S8" 2S12" LB	SV-2-T-SF SV-1	FC FC T					MUNI SIGNAL NOT USED

NOTE:
1. CABINET FOUNDATION TYPE: M
2. TS = TRACK SWITCH (4 SECTION - POLE 2: WHITE BALL, AMBER BAR (STRAIGHT/L), RED X)
TRACK SWITCH SIGNALS MAINTAINED BY MOW - SHOWN FOR REFERENCE ONLY
3. TO TRACK SWITCH CONTROLLER CABINET - SEE CONTRACT MR-894, SHEET E-3 FOR FURTHER DETAILS

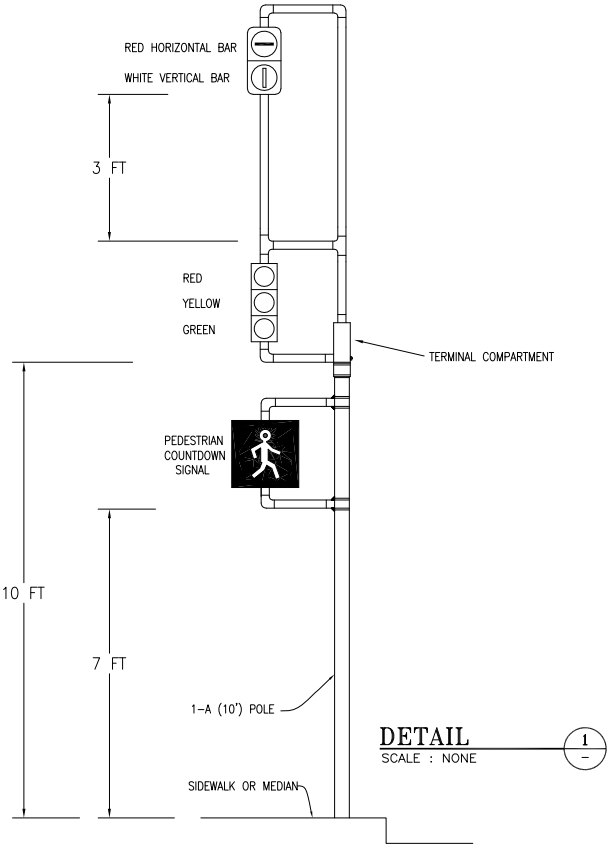

6	12/15/17	SRC 2017-300: CONVERTED "T" TO BAR SIGNALS	TY	CL
5	8/13/17	SRC 2017-226: CONVERTED TS WHITE BARS TO AMBER BARS	TY	CL
4	3/2014	PER FIELD: REMOVED TS FROM POLE 5	TY	MV
3	11/2013	PER FIELD: REMOVED TS FROM OVERHEAD SPAN WIRES, INSTALL "T" SIGNALS ON POLES 3, 6, 7 & 9, NEW TS ON POLE 2 & NEW VEHICLE SIGNAL HEAD MOUNTING ASSEMBLY ON POLE 7	TY	MV
2	6/17/11	SRC 2010-064: INSTALLED M-SF CABINET	TY	RO
1	1/15/03	SRC 2002-170: INSTALLED COUNTDOWN PED SIGNALS	FM	JM
NO.	DATE	DESCRIPTION	BY	APP.
TABLE OF REVISIONS CHECK WITH TRACING TO SEE IF YOU HAVE LATEST REVISION				

REFERENCE INFORMATION
& FILE NO. OF SURVEYS

CONTRACT MR-894
SHEETS E-1, E-3, E-5.1, E-6,
& E-11.



SAN FRANCISCO MUNICIPAL TRANSPORTATION AGENCY
CITY AND COUNTY OF SAN FRANCISCO

DRAWN: DATE:
TY 02/2019
CHECKED: DATE:
MV 03/2019

SCALE:
1" = 10'

SHEET OF SHEETS
1 OF 1

TRAFFIC SIGNAL INVENTORY DIAGRAM

17TH ST & CHURCH ST

CNN NO.
25723000
REV NO.
6