


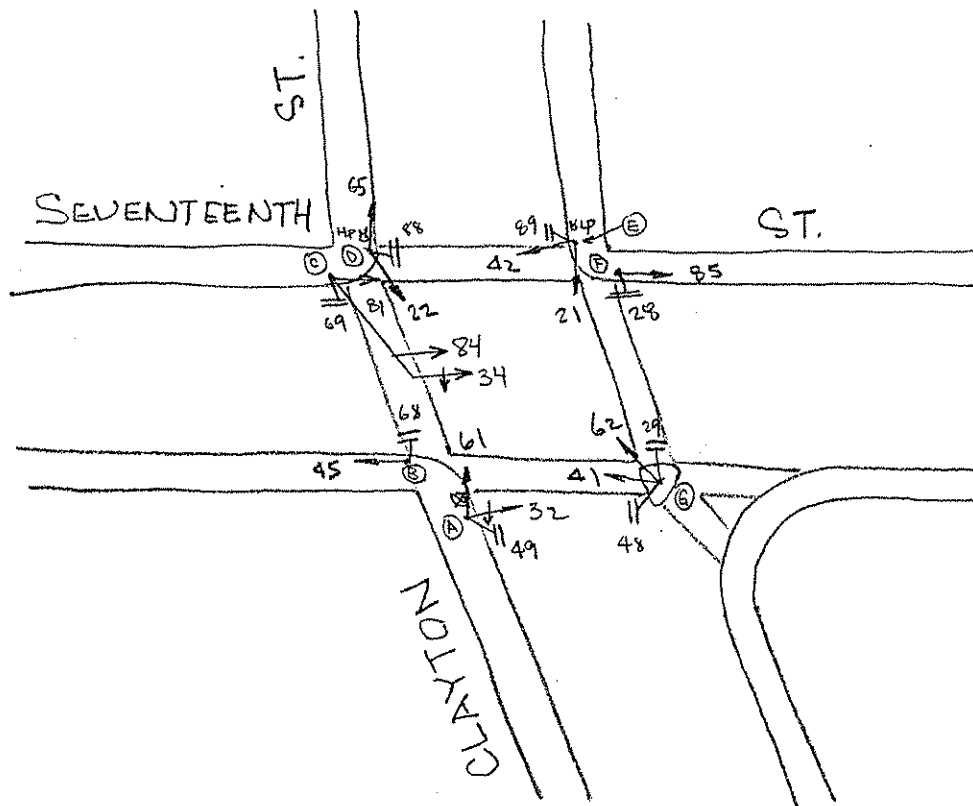

φ2

10-15-92

POLE	FUNC.	MAT'L	SIGNAL NO.	MAKE	NO. OF SECT.	SIZE	VISOR	B.P. OR LOUVERS	MOUN'T	PED SIGNAL NO.	LEGEND	MESSAGE		MAKE	MOUN'T
												ELEMENT	COLOR		
A	M	S	32	TCT	3	12"	FC 12"	No	S	49	INT.	IS-I	W/OR	ICC	S
B	S	S	61	EC	3	8"	FC 8"	No	S	68	INT.	IS-I	W/OR	ICC	S
C	L	S	45	EO	3	8"	FC 8"	No	T	69	INT.	IS-I	W/OR	ICC	S
D	M	S	81	TCT	3	8"	FC 8"	No	S	88	INT.	IS-T	W/OR	ICC	S
E	M	S	22	EC	3	8"	FC 8"	No	S	89	INT.	IS-T	W/OR	ICC	S
F	S	S	65	EC	3	8"	FC 8"	No	S	28	INT.	IS-I	W/OR	ICC	S
G	M	S	42	EC	3	8"	FC 8"	No	S	29	INT.	IS-I	W/OR	ICC	S
			21	EC	3	8"	FC 8"	No	S	48	INT.	IS-I	W/OR	ICC	S
			85	EA	3	8"	FC 8"	No	T						
			84	TCT	3	12"	FC 12"	No	S						
			62	EC	3	8"	FC 8"	No	S						
			41	EC	3	8"	FC 8"	No	S						
			34	TCT	3	12"	FC 12"	No	S						

CONTROLLER CABINET SIZE : ORDINARY BASE CABINET: YES

COMMENTS :