




POLE AND EQUIPMENT SCHEDULE											
POLE No.	TYPE OF POLE	LUMINAIRE VOLTAGE/WATTAGE	VEHICLE SIGNAL					PEDESTRIAN SIGNAL			REMARKS
			No.	TYPE	MOUNTING	VISORS	LOUVERS	No.	TYPE	MOUNTING	
①	16-1-70 W/20' SIGNAL MAST ARM		21 24	3S8" 3S12"	SV-1-T MAS	T T		28 89	1S-COUNT 1S-COUNT	SP-1 SP-1	BACKPLATE
②	CITY STANDARD STREET LIGHT		42	3S8"	SV-1-T	T					
③	PEDESTAL SIGNAL POLE (10')		41 62	3S8" 3S8"	TV-2-T	T T		29 48	1S-COUNT 1S-COUNT	SP-1 SP-1	
④	16-1-70 W/20' SIGNAL MAST ARM		61 64	3S8" 3S12"	SV-1 MAS	T T		49	1S-COUNT	SP-1	BACKPLATE
⑤	CITY STANDARD STREET LIGHT		42	3S12"	SV-1-T	T		68	1S-COUNT	SP-1	
⑥	PEDESTAL SIGNAL POLE (10')		22 81	3S8" 3S8"	TV-2-T	T T		69 88	1S-COUNT 1S-COUNT	SP-1 SP-1	

2	3/22/16	ADDED PCS XING 17TH PER SRC 2015-279	AScales	WVelasco	
1	1/14	SIGNAL 82 UPGRADED TO 3S12" PER FIELD	AScales	GDeLeon	
0	12/94	SIGNAL UPGRADE CONTRACT 21; CONVERTED FROM MSID	AScales	GDeLeon	
NO.	DATE	DESCRIPTION	BY	APP.	
TABLE OF REVISIONS					
CHECK WITH TRACING TO SEE IF YOU HAVE LATEST REVISION					

REFERENCE INFORMATION & FILE NO. OF SURVEYS
--

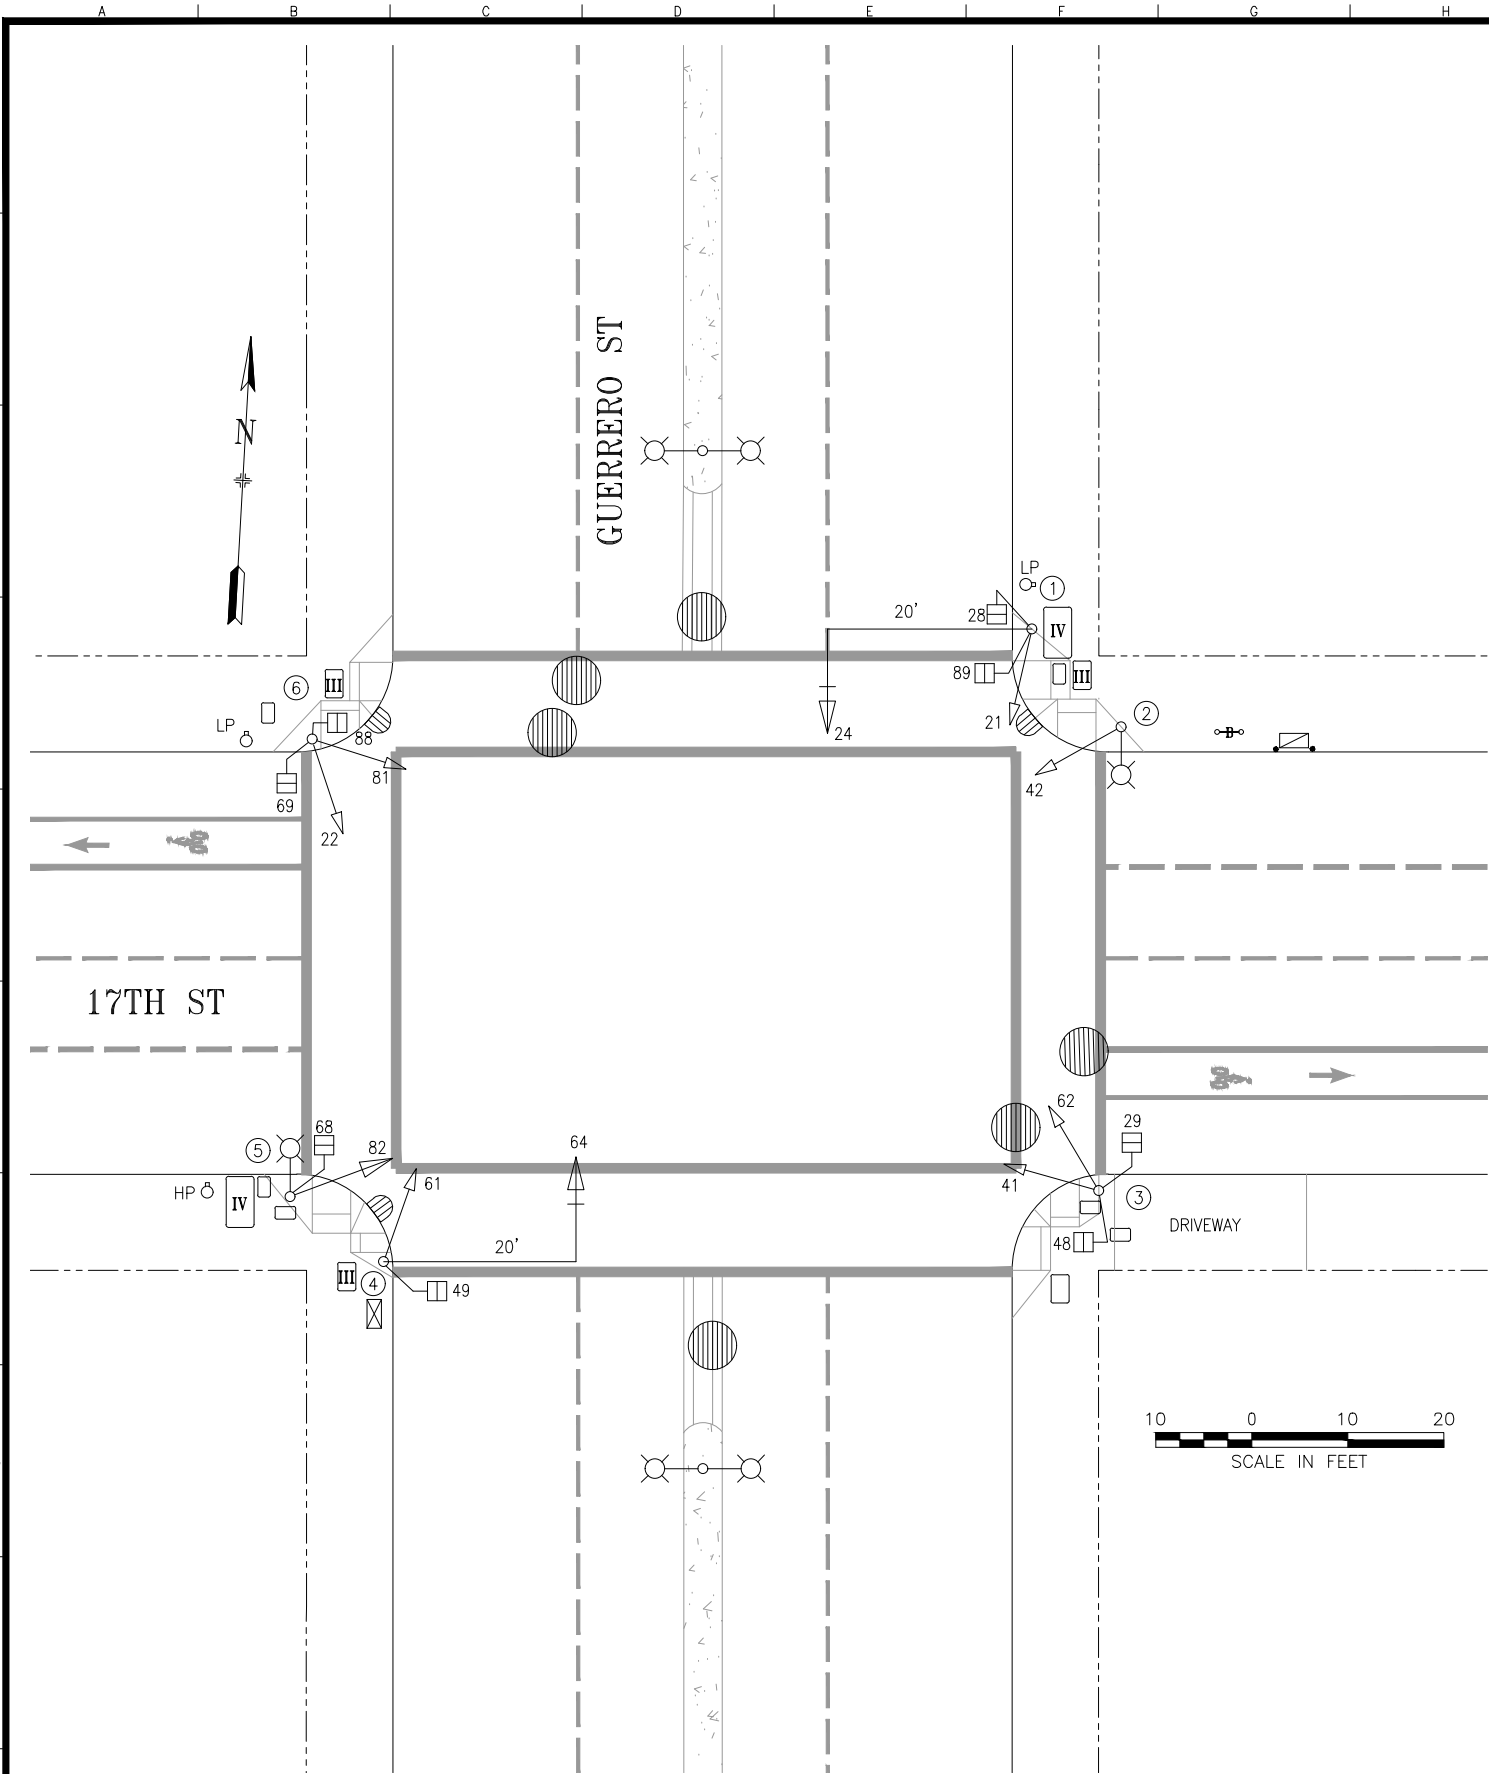

SAN FRANCISCO MUNICIPAL TRANSPORTATION AGENCY

CITY AND COUNTY OF SAN FRANCISCO

DRAWN:	DATE:
AScales	12/15/2016
CHECKED:	DATE:
GDeLeon	12/16/2016

SCALE:
AS SHOWN
SHEET OF SHEETS
1 OF 1

TRAFFIC SIGNAL INVENTORY DIAGRAM
17TH STREET AND GUERRERO STREET

CNN NO.
25690000
REV NO.
2