


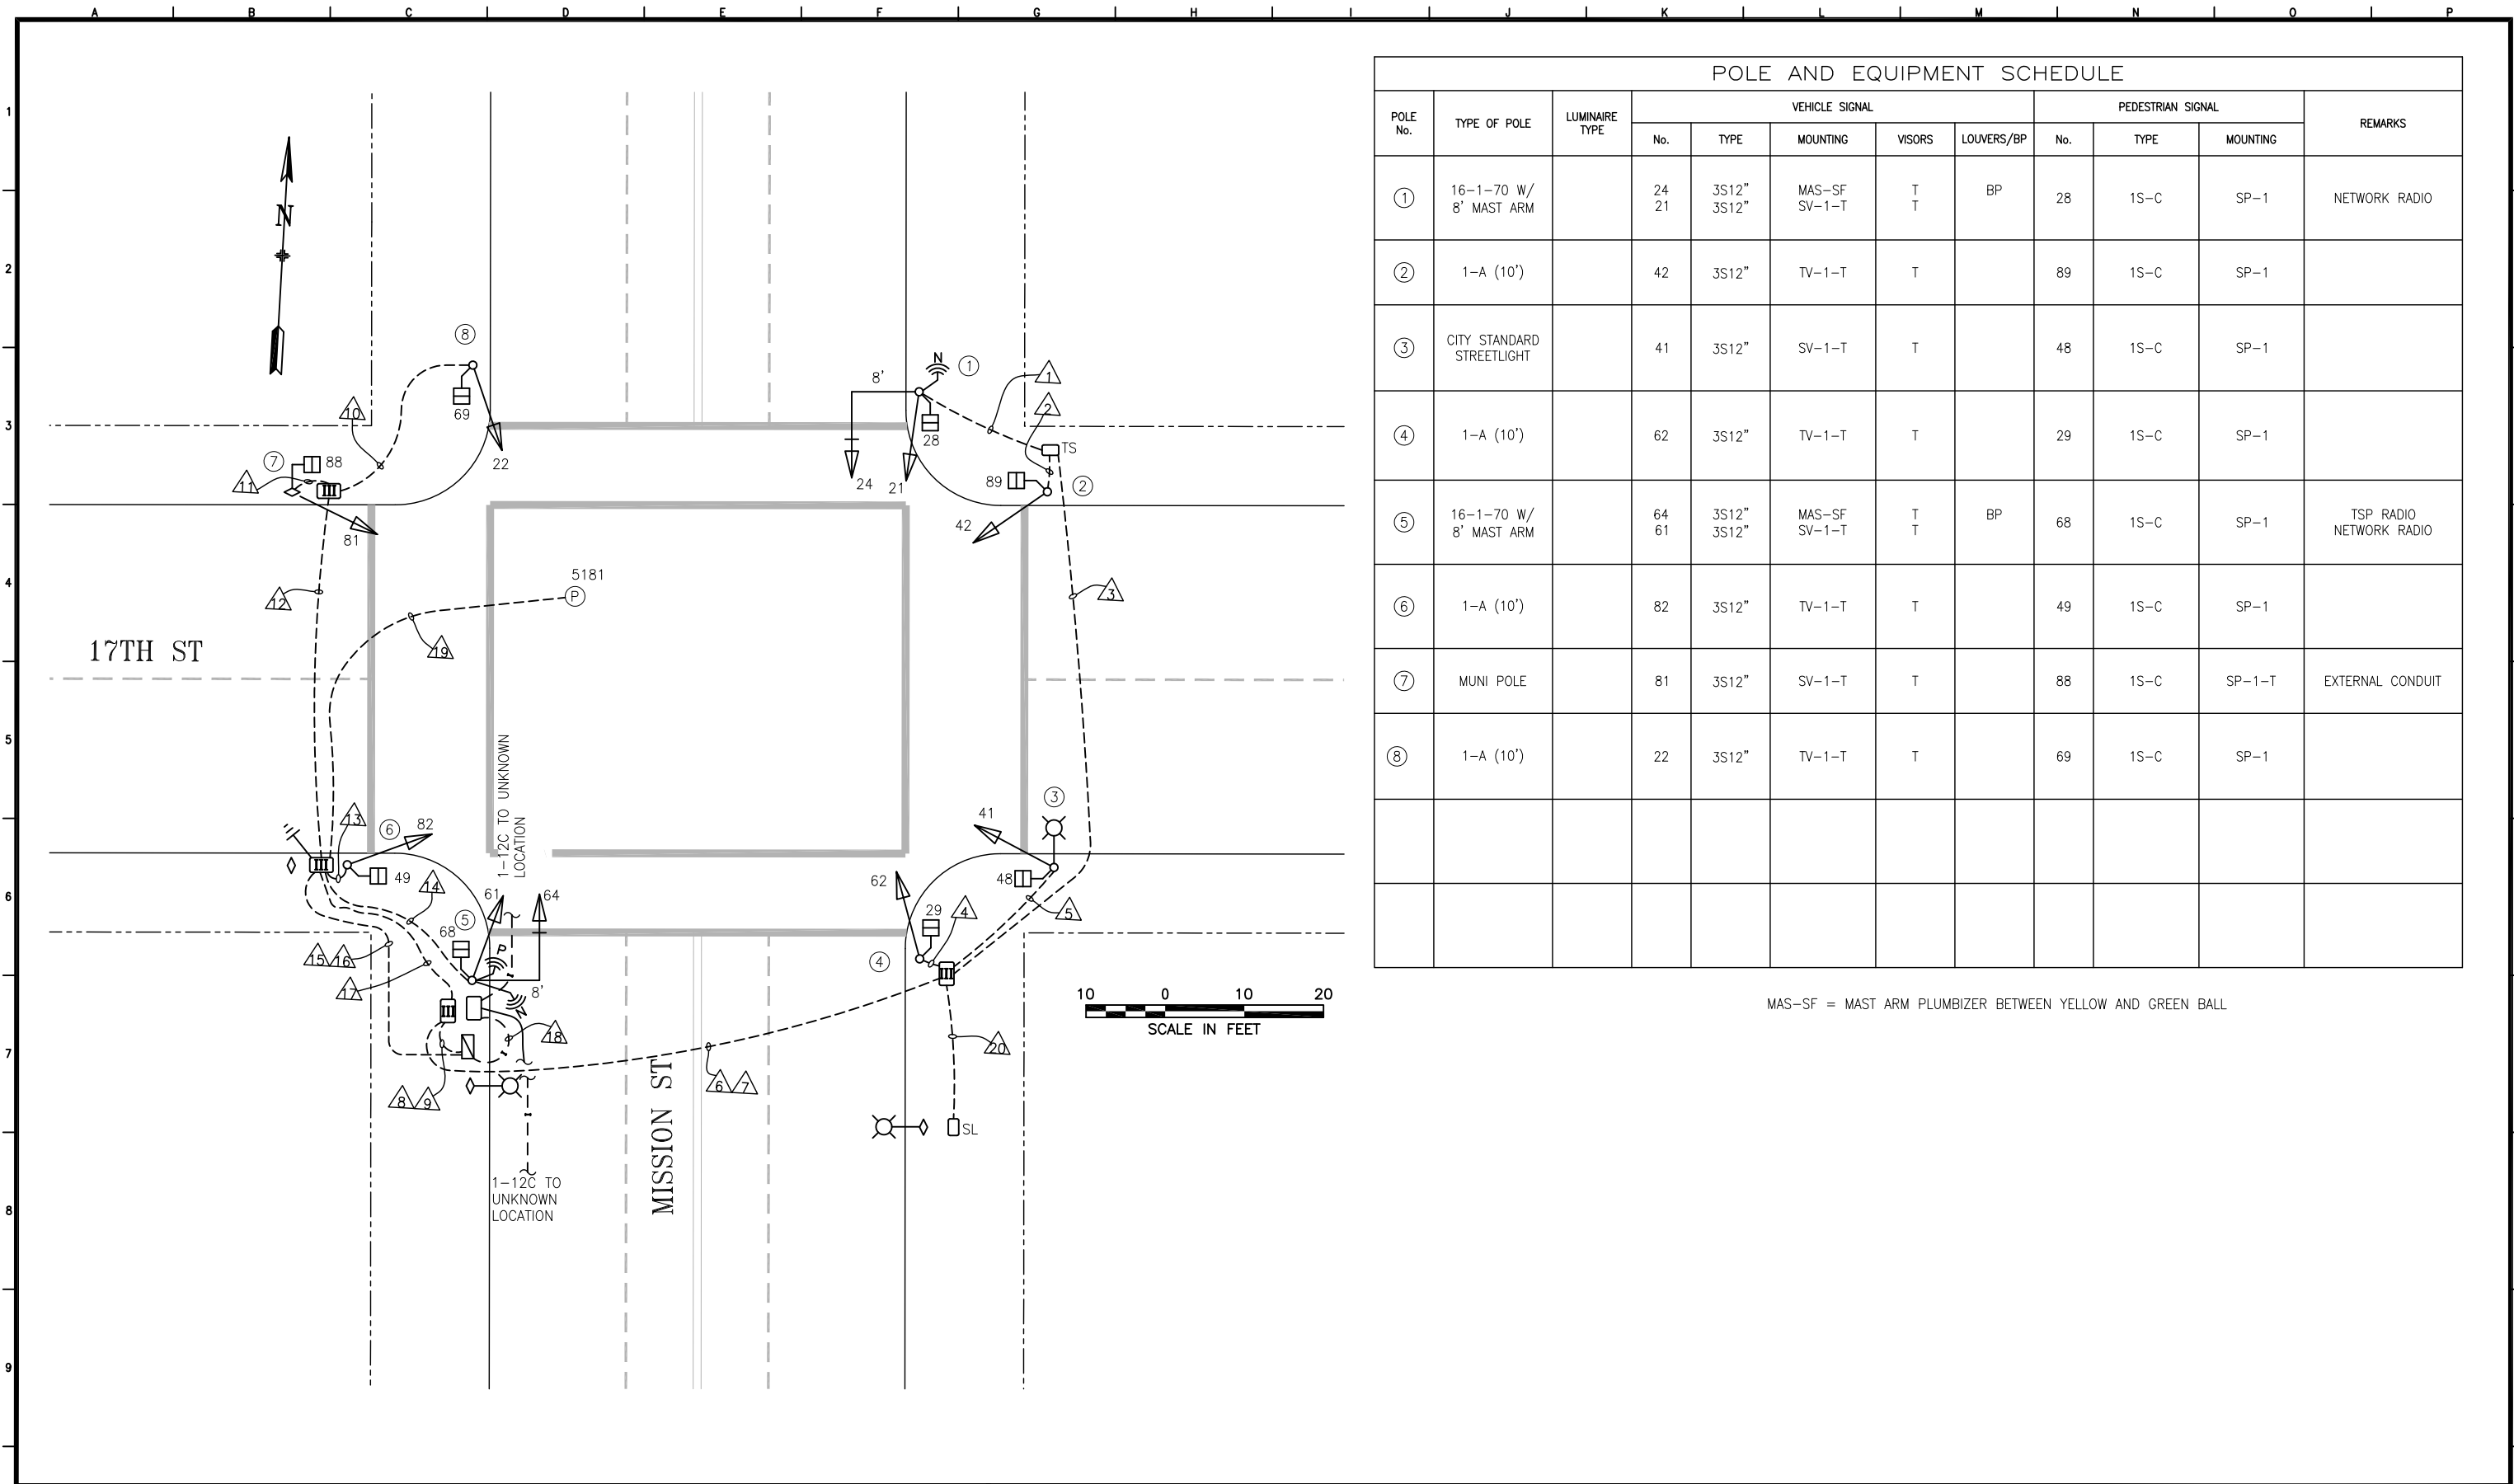

MAS-SF = MAST ARM PLUMBIZER BETWEEN YELLOW AND GREEN BALL

5/16/23	SRC 2023-043: UPGRADE ALL SIGNALS MOUNTED AT 10FT FROM 8 TO 12-INCH	D. YEUNG	G. DE LEON		
2/9/23	UPDATE PER FIELD: UPDATE TSP/NETWORK EQUIPMENT & MAS PLUMBIZER	D. YEUNG	G. DE LEON		
11/13/07	CONVERTED FROM CONTRACT 0944J(R) CONSTRUCTION PLAN	D. YEUNG	G. DE LEON		
NO.	DATE	DESCRIPTION	BY	APPROVED	
TABLE OF REVISIONS					
CHECKOUT DRAWING THROUGH THE SID CUSTODIAN FOR THE LATEST REVISION					



SFMTA

		SCALE AS SHOWN	TRAFFIC SIGNAL INVENTORY DIAGRAM	CNN NO: 24165000
DRAWN BY: D. YEUNG	DATE: FEB 2023	SHEET OF SHEETS 1 OF 2		17TH ST AND MISSION ST
CHECKED BY: G. DE LEON	DATE: FEB 2023			

