


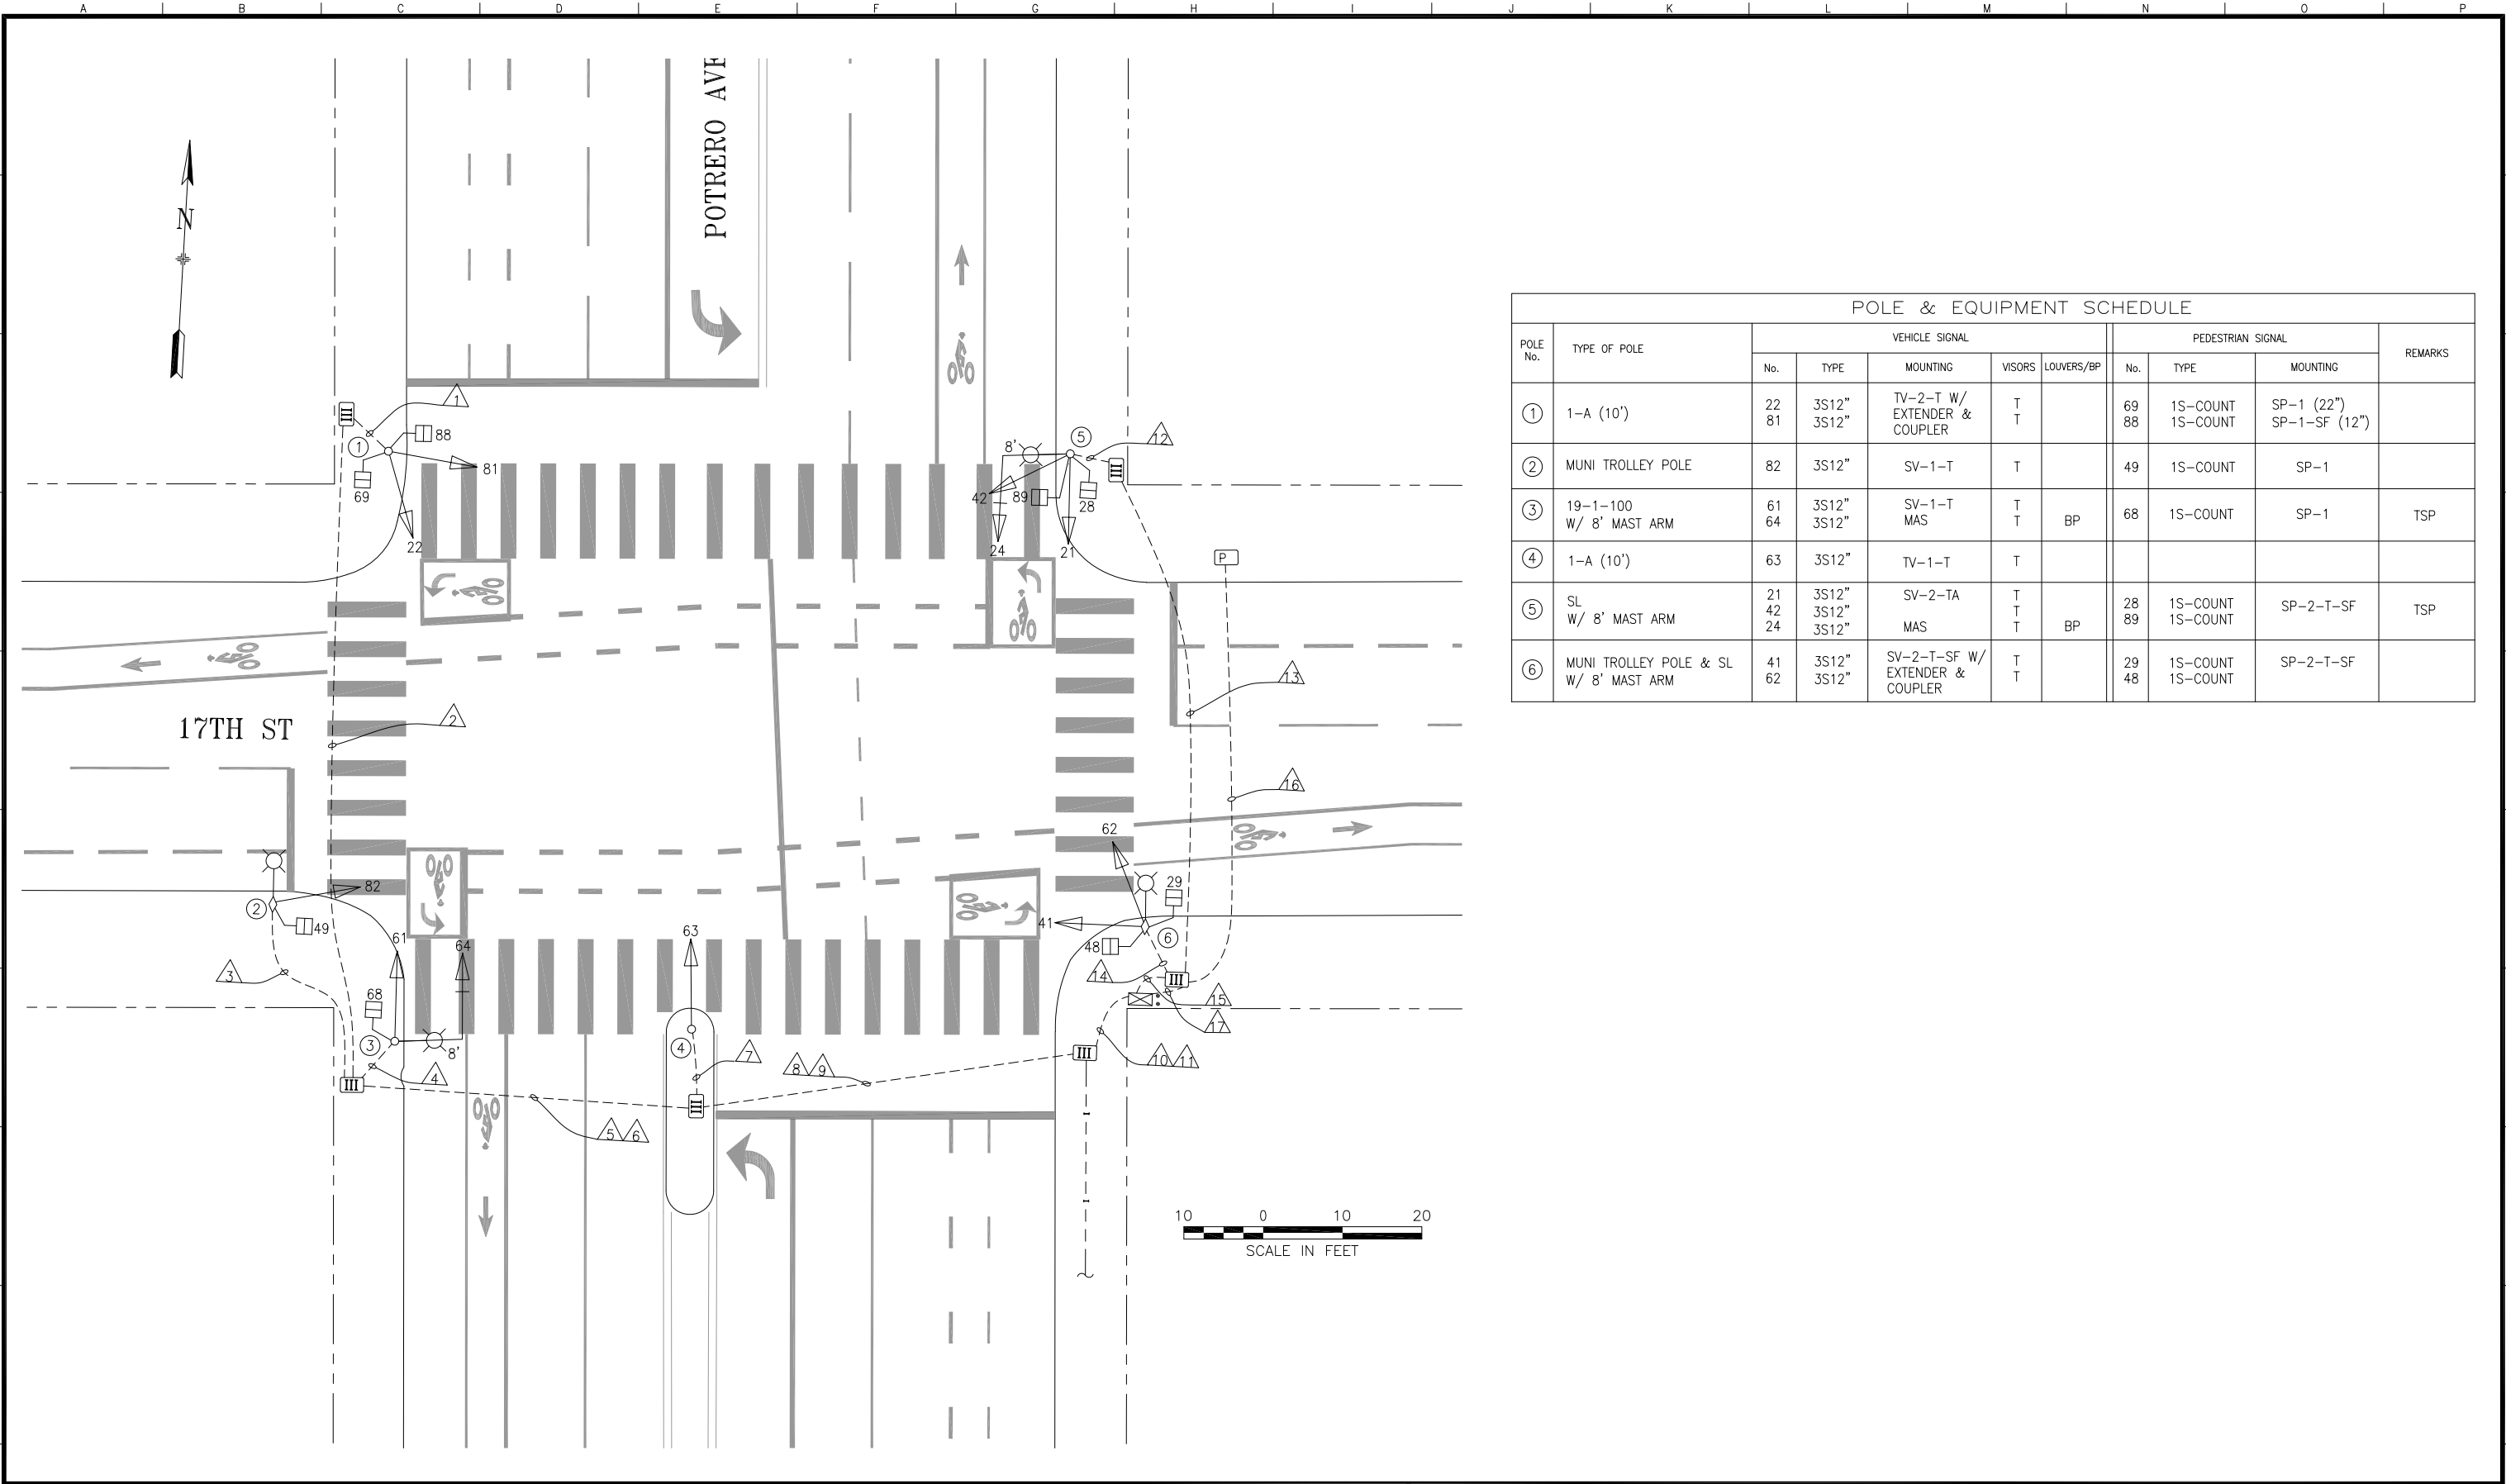

POLE & EQUIPMENT SCHEDULE										
POLE No.	TYPE OF POLE	VEHICLE SIGNAL					PEDESTRIAN SIGNAL			REMARKS
		No.	TYPE	MOUNTING	VISORS	LOUVERS/BP	No.	TYPE	MOUNTING	
①	1-A (10')	22 81	3S12" 3S12"	TV-2-T W/ EXTENDER & COUPLER	T T		69 88	1S-COUNT 1S-COUNT	SP-1 (22") SP-1-SF (12")	
②	MUNI TROLLEY POLE	82	3S12"	SV-1-T	T		49	1S-COUNT	SP-1	
③	19-1-100 W/ 8' MAST ARM	61 64	3S12" 3S12"	SV-1-T MAS	T T	BP	68	1S-COUNT	SP-1	TSP
④	1-A (10')	63	3S12"	TV-1-T	T					
⑤	SL W/ 8' MAST ARM	21 42 24	3S12" 3S12" 3S12"	SV-2-TA MAS	T T T	BP	28 89	1S-COUNT 1S-COUNT	SP-2-T-SF	TSP
⑥	MUNI TROLLEY POLE & SL W/ 8' MAST ARM	41 62	3S12" 3S12"	SV-2-T-SF W/ EXTENDER & COUPLER	T T		29 48	1S-COUNT 1S-COUNT	SP-2-T-SF	

0	03/07/18	UPGRADED BY 2127J; CONVERTED FROM AS-BUILTS	Hfu	Vventura
NO.	DATE	DESCRIPTION	BY	APP.

TABLE OF REVISIONS
CHECK WITH TRACING TO SEE IF YOU HAVE LATEST REVISION

REFERENCE INFORMATION
& FILE NO. OF SURVEYS



SAN FRANCISCO MUNICIPAL TRANSPORTATION AGENCY
CITY AND COUNTY OF SAN FRANCISCO

DRAWN:	DATE:
H.YU	07/2019
CHECKED:	DATE:
L.VENTURA	09/2020

SCALE:
AS SHOWN

SHEET OF SHEETS
1 OF 2

TRAFFIC SIGNAL INVENTORY DIAGRAM

17TH STREET AND POTRERO AVENUE

CNN NO.
24020000

REV NO.
0

CONDUIT & WIRING SCHEDULE																			
CONDUIT RUN NUMBER		△1	△2	△3	△4	△5	△6	△7	△8	△9	△10	△11	△12	△13	△14	△15	△16	△17	
CONDUIT SIZE (INCH) & TYPE		2"	2"	2"	2"	2"	2"	2"	2"	2"	3"	2"	2"	2"	2"	3"	2"	2"	
NOTES / REMARKS							SP			SP		SP							
#14 AWG WIRES	POLE 1	VEH SIGNAL 22	3	3			3			3		3							
	POLE 1	VEH SIGNAL 81	3	3			3			3		3							
	POLE 1	PED SIGNAL 69	2	2			2			2		2							
	POLE 1	PED SIGNAL 88	2	2			2			2		2							
	POLE 2	VEH SIGNAL 82			3		3			3		3							
	POLE 2	PED SIGNAL 49			2		2			2		2							
	POLE 3	VEH SIGNAL 61				3	3			3		3							
	POLE 3	VEH SIGNAL 64				3	3			3		3							
	POLE 3	PED SIGNAL 68				2	2			2		2							
	POLE 4	VEH SIGNAL 63						3	3		3								
	POLE 5	VEH SIGNAL 21											3	3		3			
	POLE 5	VEH SIGNAL 24											3	3		3			
	POLE 5	VEH SIGNAL 42											3	3		3			
	POLE 5	PED SIGNAL 28											2	2		2			
	POLE 5	PED SIGNAL 89											2	2		2			
	POLE 6	VEH SIGNAL 41														3	3		
	POLE 6	VEH SIGNAL 62														3	3		
	POLE 6	PED SIGNAL 29														2	2		
	POLE 6	PED SIGNAL 48														2	2		
		NEUTRAL	3		2	3			1					3		2			
		SPARE		3			3			3		3			3		3		
	WIRE TOTALS	TOTAL #14 AWG	13	13	7	11	26		4	29		29		16	16	12	26		
		TOTAL #10 NEUTRAL		1			2			3		3			1		2		
		TOTAL #8 WIRES (120V SERVICE)																2	2
	CONDUIT RUN NUMBER	△1	△2	△3	△4	△5	△6	△7	△8	△9	△10	△11	△12	△13	△14	△15	△16	△17	