


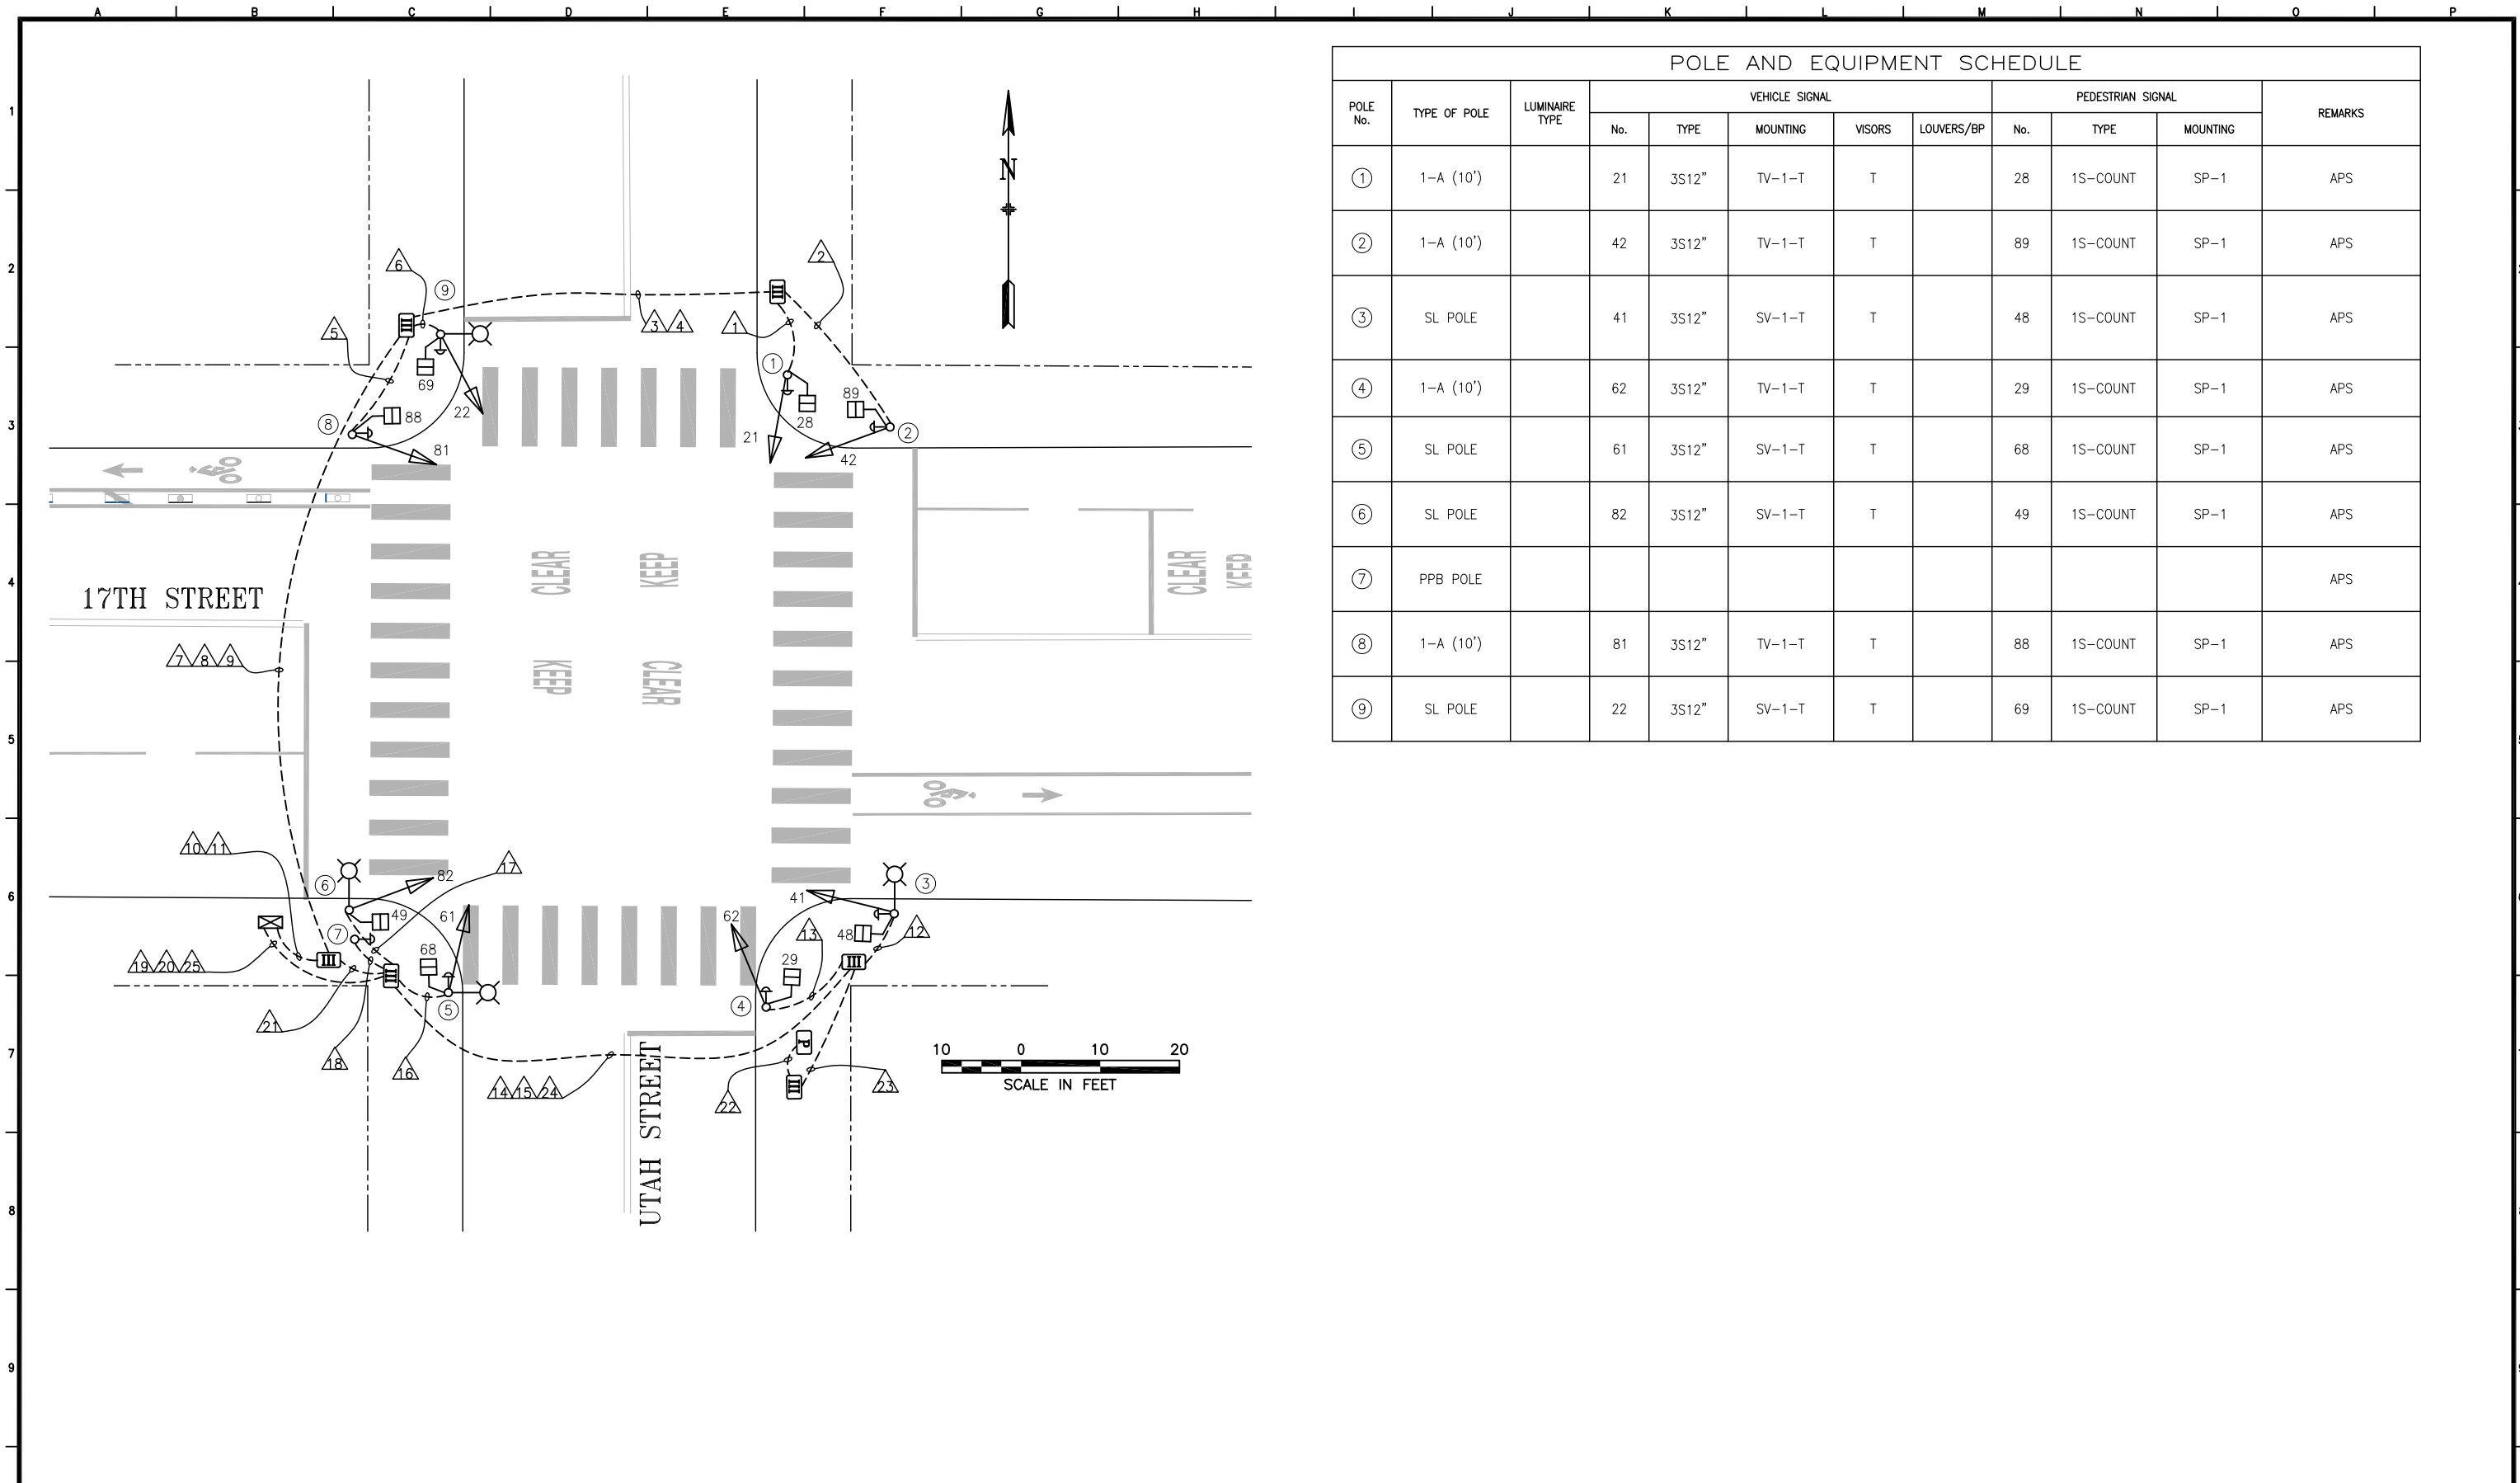

POLE AND EQUIPMENT SCHEDULE											
POLE No.	TYPE OF POLE	LUMINAIRE TYPE	VEHICLE SIGNAL					PEDESTRIAN SIGNAL			REMARKS
			No.	TYPE	MOUNTING	VISORS	LOUVERS/BP	No.	TYPE	MOUNTING	
①	1-A (10')		21	3S12"	TV-1-T	T		28	1S-COUNT	SP-1	APS
②	1-A (10')		42	3S12"	TV-1-T	T		89	1S-COUNT	SP-1	APS
③	SL POLE		41	3S12"	SV-1-T	T		48	1S-COUNT	SP-1	APS
④	1-A (10')		62	3S12"	TV-1-T	T		29	1S-COUNT	SP-1	APS
⑤	SL POLE		61	3S12"	SV-1-T	T		68	1S-COUNT	SP-1	APS
⑥	SL POLE		82	3S12"	SV-1-T	T		49	1S-COUNT	SP-1	APS
⑦	PPB POLE										APS
⑧	1-A (10')		81	3S12"	TV-1-T	T		88	1S-COUNT	SP-1	APS
⑨	SL POLE		22	3S12"	SV-1-T	T		69	1S-COUNT	SP-1	APS

0	06/04/20	CONVERTED FROM CONTRACT: NEW SIGNAL ACTIVATED THROUGH 1303R	S. ARIAS	D. ALABA
NO.	DATE	DESCRIPTION	BY	APPROVED

TABLE OF REVISIONS
CHECKOUT DRAWING THROUGH THE SID CUSTODIAN FOR THE LATEST REVISION



DRAWN BY: S. ARIAS	DATE: 8/25/21
CHECKED BY: D. ALABA	DATE: 6/6/23

SCALE AS SHOWN
SHEET OF SHEETS 01 OF 02

TRAFFIC SIGNAL INVENTORY DIAGRAM

17TH STREET AND UTAH STREET

CNN NO: 24017000
REV NO: 0

