


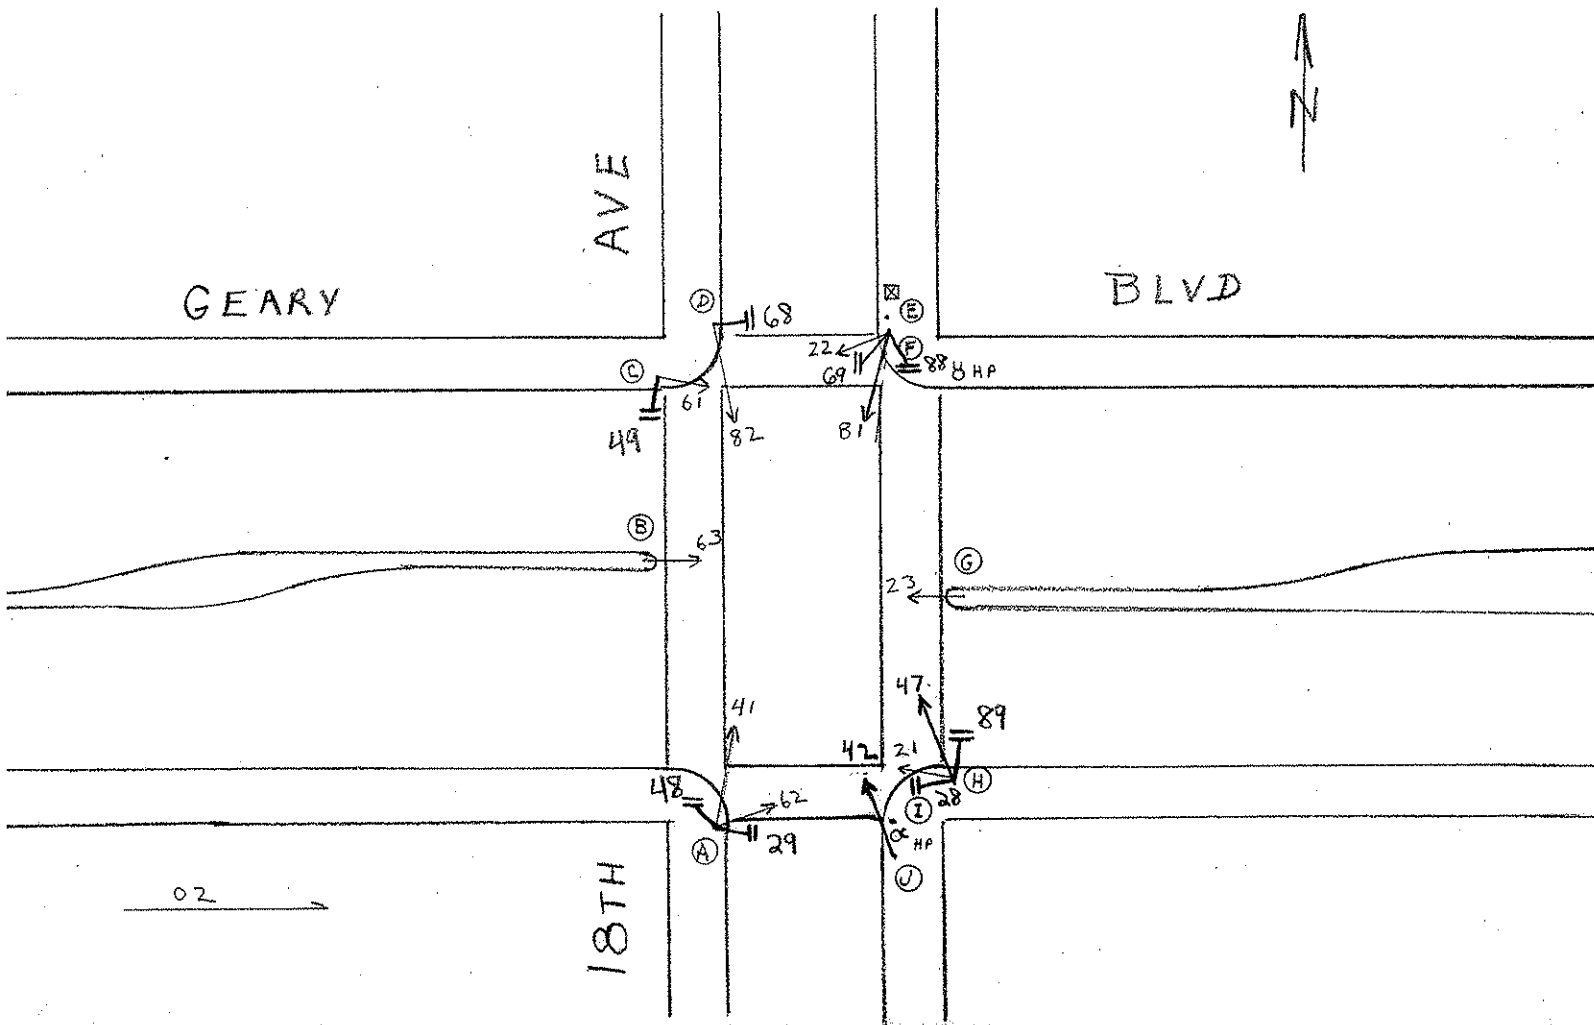

7-06-09

POLE	FUNC.	MAT'L	SIGNAL NO.	MAKE	NO. OF SECT.	SIZE	VISOR	B.P. OR LOUVERS	MOUN'T	PED SIGNAL NO.	LEGEND	MESSAGE		MAKE	MOUN'T
												ELEMENT	COLOR		
A	S	S	62	EC	3	8"	FC	No	T	28	COUNT	LED	WH/OR	DAUGHT	S
B	L	C	41	EC	3	8"	FC	No	T	29	COUNT	LED	WH/OR	DAUGHT	S
C	S	S	61	EC	3	8"	FC	No	T	48	COUNT	LED	WH/OR	DAUGHT	S
D	S	S	82	EC	3	8"	FC	No	T	49	COUNT	LED	WH/OR	DAUGHT	S
E	U	W	22	EC	3	8"	FC	No	T	68	COUNT	LED	WH/OR	DAUGHT	S
F	S	S	81	EC	3	8"	FC	No	T	69	COUNT	LED	WH/OR	DAUGHT	S
G	L	C	21	EC	3	8"	FC	No	T	88	COUNT	LED	WH/OR	DAUGHT	S
H	S	S	42	EC	3	8"	FC	No	T	89	COUNT	LED	WH/OR	DAUGHT	S
I	U	W	63		3	8"		No	S						
J	S	S	23		3	8"		No	S						
			47	EC	3	8"	FC	No	T						

CONTROLLER CABINET SIZE : ORDINARY BASE CABINET: YES

COMMENTS: ADDED COUNTDOWN PED SIGNALS IN ALL DIRECTIONS