


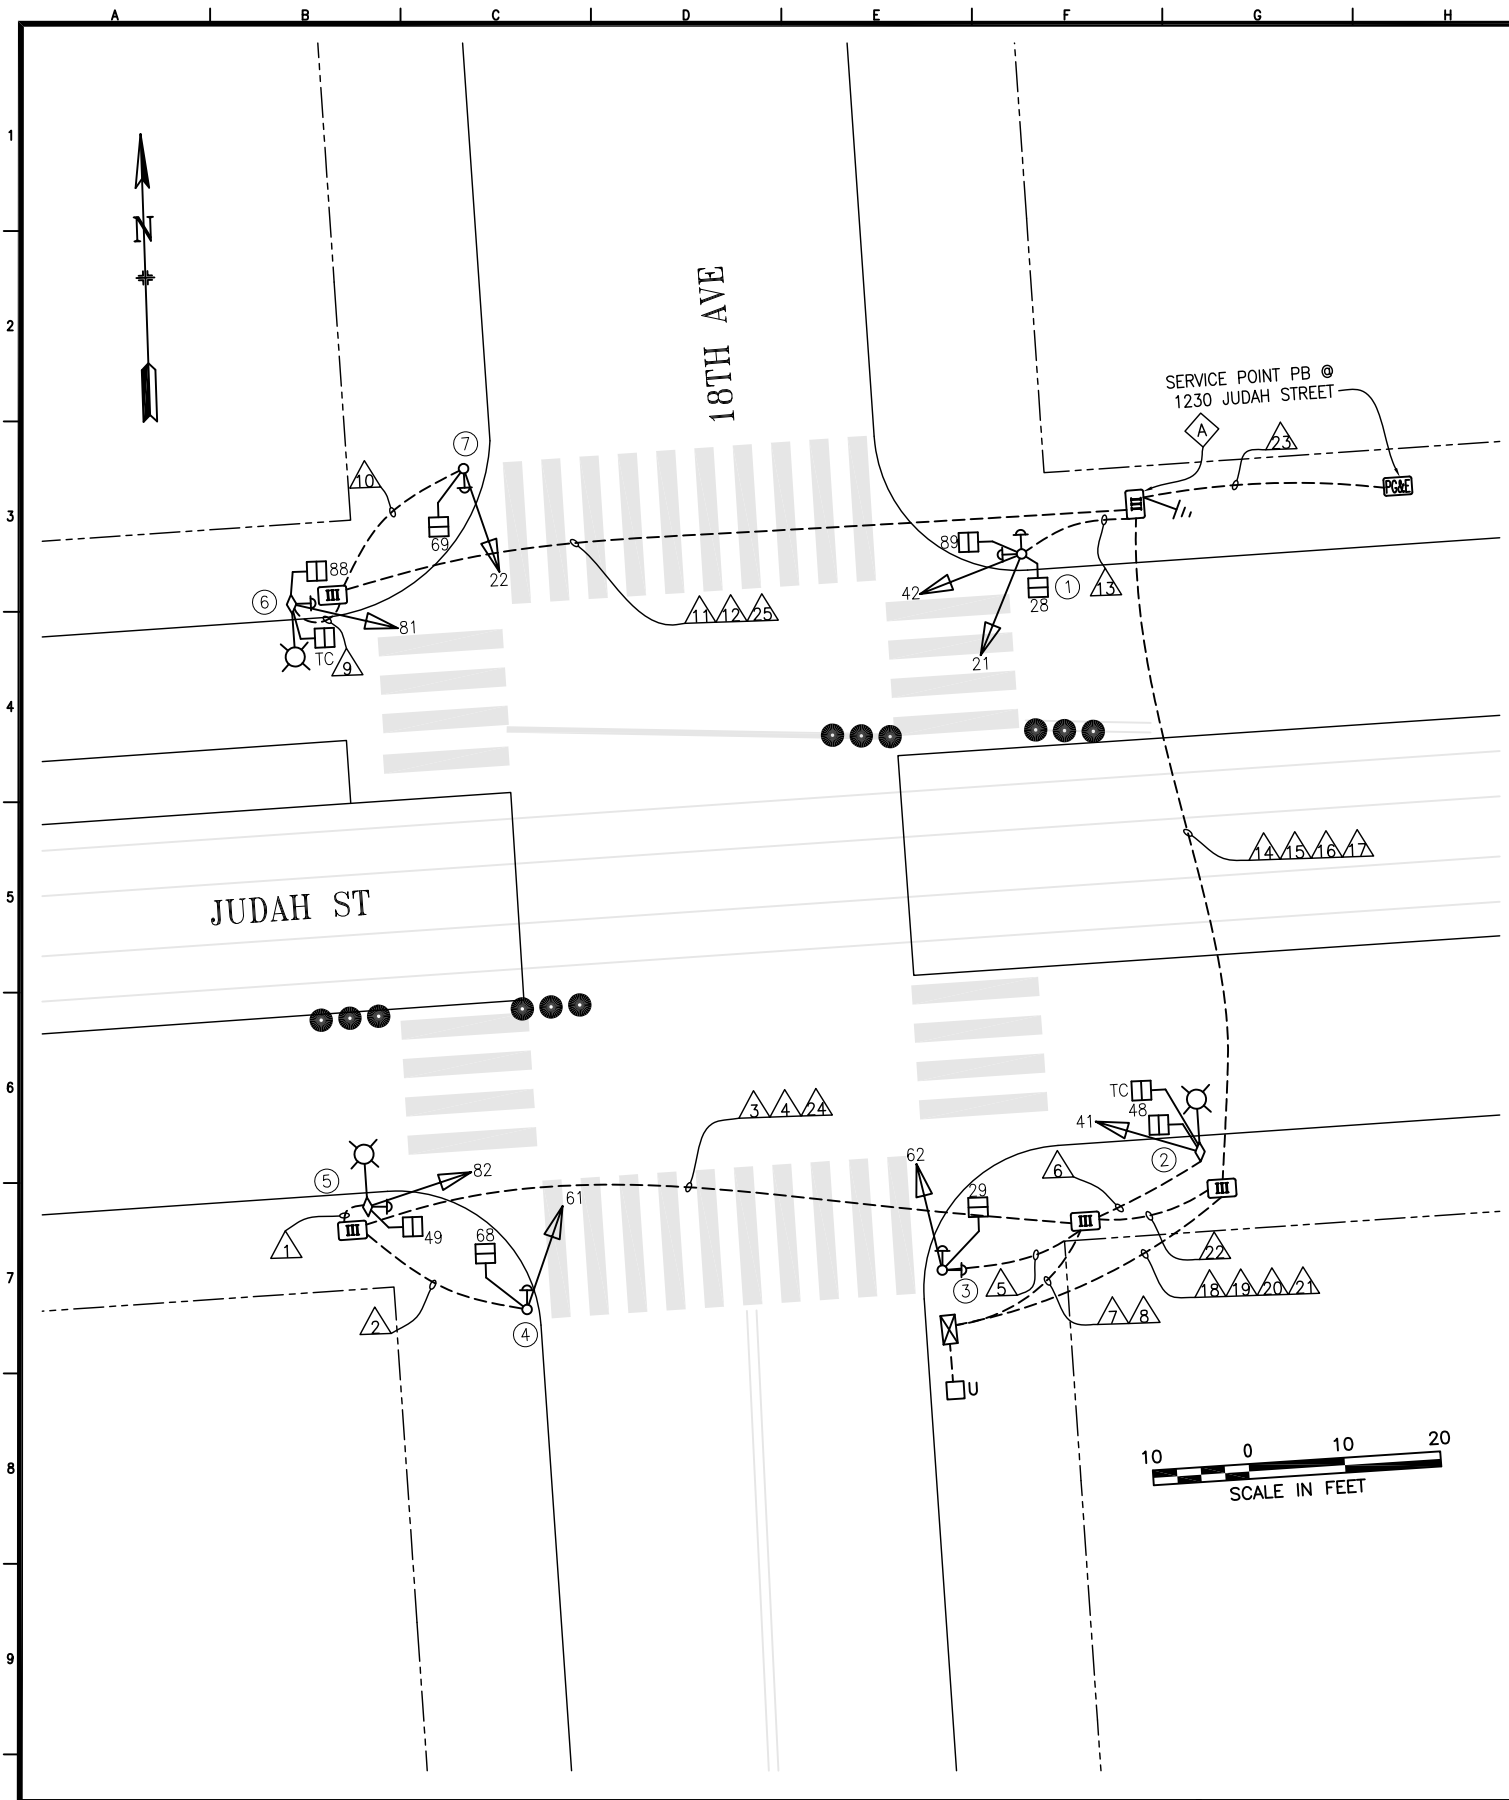

POLE AND EQUIPMENT SCHEDULE											
POLE No.	TYPE OF POLE	LUMINAIRE TYPE	VEHICLE SIGNAL					PEDESTRIAN SIGNAL			REMARKS
			No.	TYPE	MOUNTING	VISORS	LOUVERS/BP	No.	TYPE	MOUNTING	
①	1-A (10')		21 42	3S12" 3S12"	TV-2-T	T T		28 89	1S-COUNT	SP-1 SP-1	APS-2W
②	MUNI COMBO POLE		41 TC	3S12" 1S 24"x24"	SV-1-T SV-1	T T		48	1S-COUNT	SP-1	
③	1-A (10')		62	3S12"	TV-1-T	T		29	1S-COUNT	SP-1	APS-2W (2)
④	1-A (10')		61	3S12"	TV-1-T	T		68	1S-COUNT	SP-1	APS-2W
⑤	MUNI COMBO POLE		82	3S12"	SV-1-T	T		49	1S-COUNT	SP-1	APS-2W
⑥	MUNI COMBO POLE		81 TC	3S12" 1S 24"x24"	SV-1-T SV-1	T T		88	1S-COUNT	SP-1	APS-2W
⑦	1-A (10')		22	3S12"	TV-1-T	T		69	1S-COUNT	SP-1	APS-2W

GENERAL NOTES:

1. TC = TRAIN COMING

SHEET NOTES:

- △ 40A INLINE FUSE

TABLE OF REVISIONS		CHECKOUT DRAWING THROUGH THE SID CUSTODIAN FOR THE LATEST REVISION	
NO.	DATE	DESCRIPTION	BY
1	11/1/20	2019-404: INSTALLED TC ON POLES 2 & 6	T. YOUNG
2	8/27/19	CONVERTED FROM CONTRACT 2419J	C. LEUNG



SFMTA

DRAWN BY: C. LEUNG	DATE: 8/2019
CHECKED BY: M. VELASCO	DATE: 8/2019

SCALE AS SHOWN
SHEET OF SHEETS 1 OF 2

TRAFFIC SIGNAL INVENTORY DIAGRAM
18TH AVENUE & JUDAH STREET TRAFFIC SIGNAL LAYOUT

CNN NO: 27365000
REV NO: 2

[illegible]

SHEET NOTES:

										CNN NO:	
											27365000
A	11/1/20	2019-404: INSTALLED TC ON POLE 2 & 6	C. LEUNG	M. VELASCO			DRAWN BY: C. LEUNG	DATE: 8/2019	SCALE N/A	TRAFFIC SIGNAL INVENTORY DIAGRAM	
A	8/27/19	CONVERTED FROM CONTRACT 2419J	C. LEUNG	M. VELASCO			CHECKED BY: M. VELASCO	DATE: 8/2019	SHEET OF SHEETS 2 OF 2	18TH AVENUE & JUDAH STREET CONDUIT & WIRING SCHEDULE	REV NO: 2
NO.	DATE	DESCRIPTION	BY	APPROVED							
TABLE OF REVISIONS CHECKOUT DRAWING THROUGH THE SID CUSTODIAN FOR THE LATEST REVISION											