


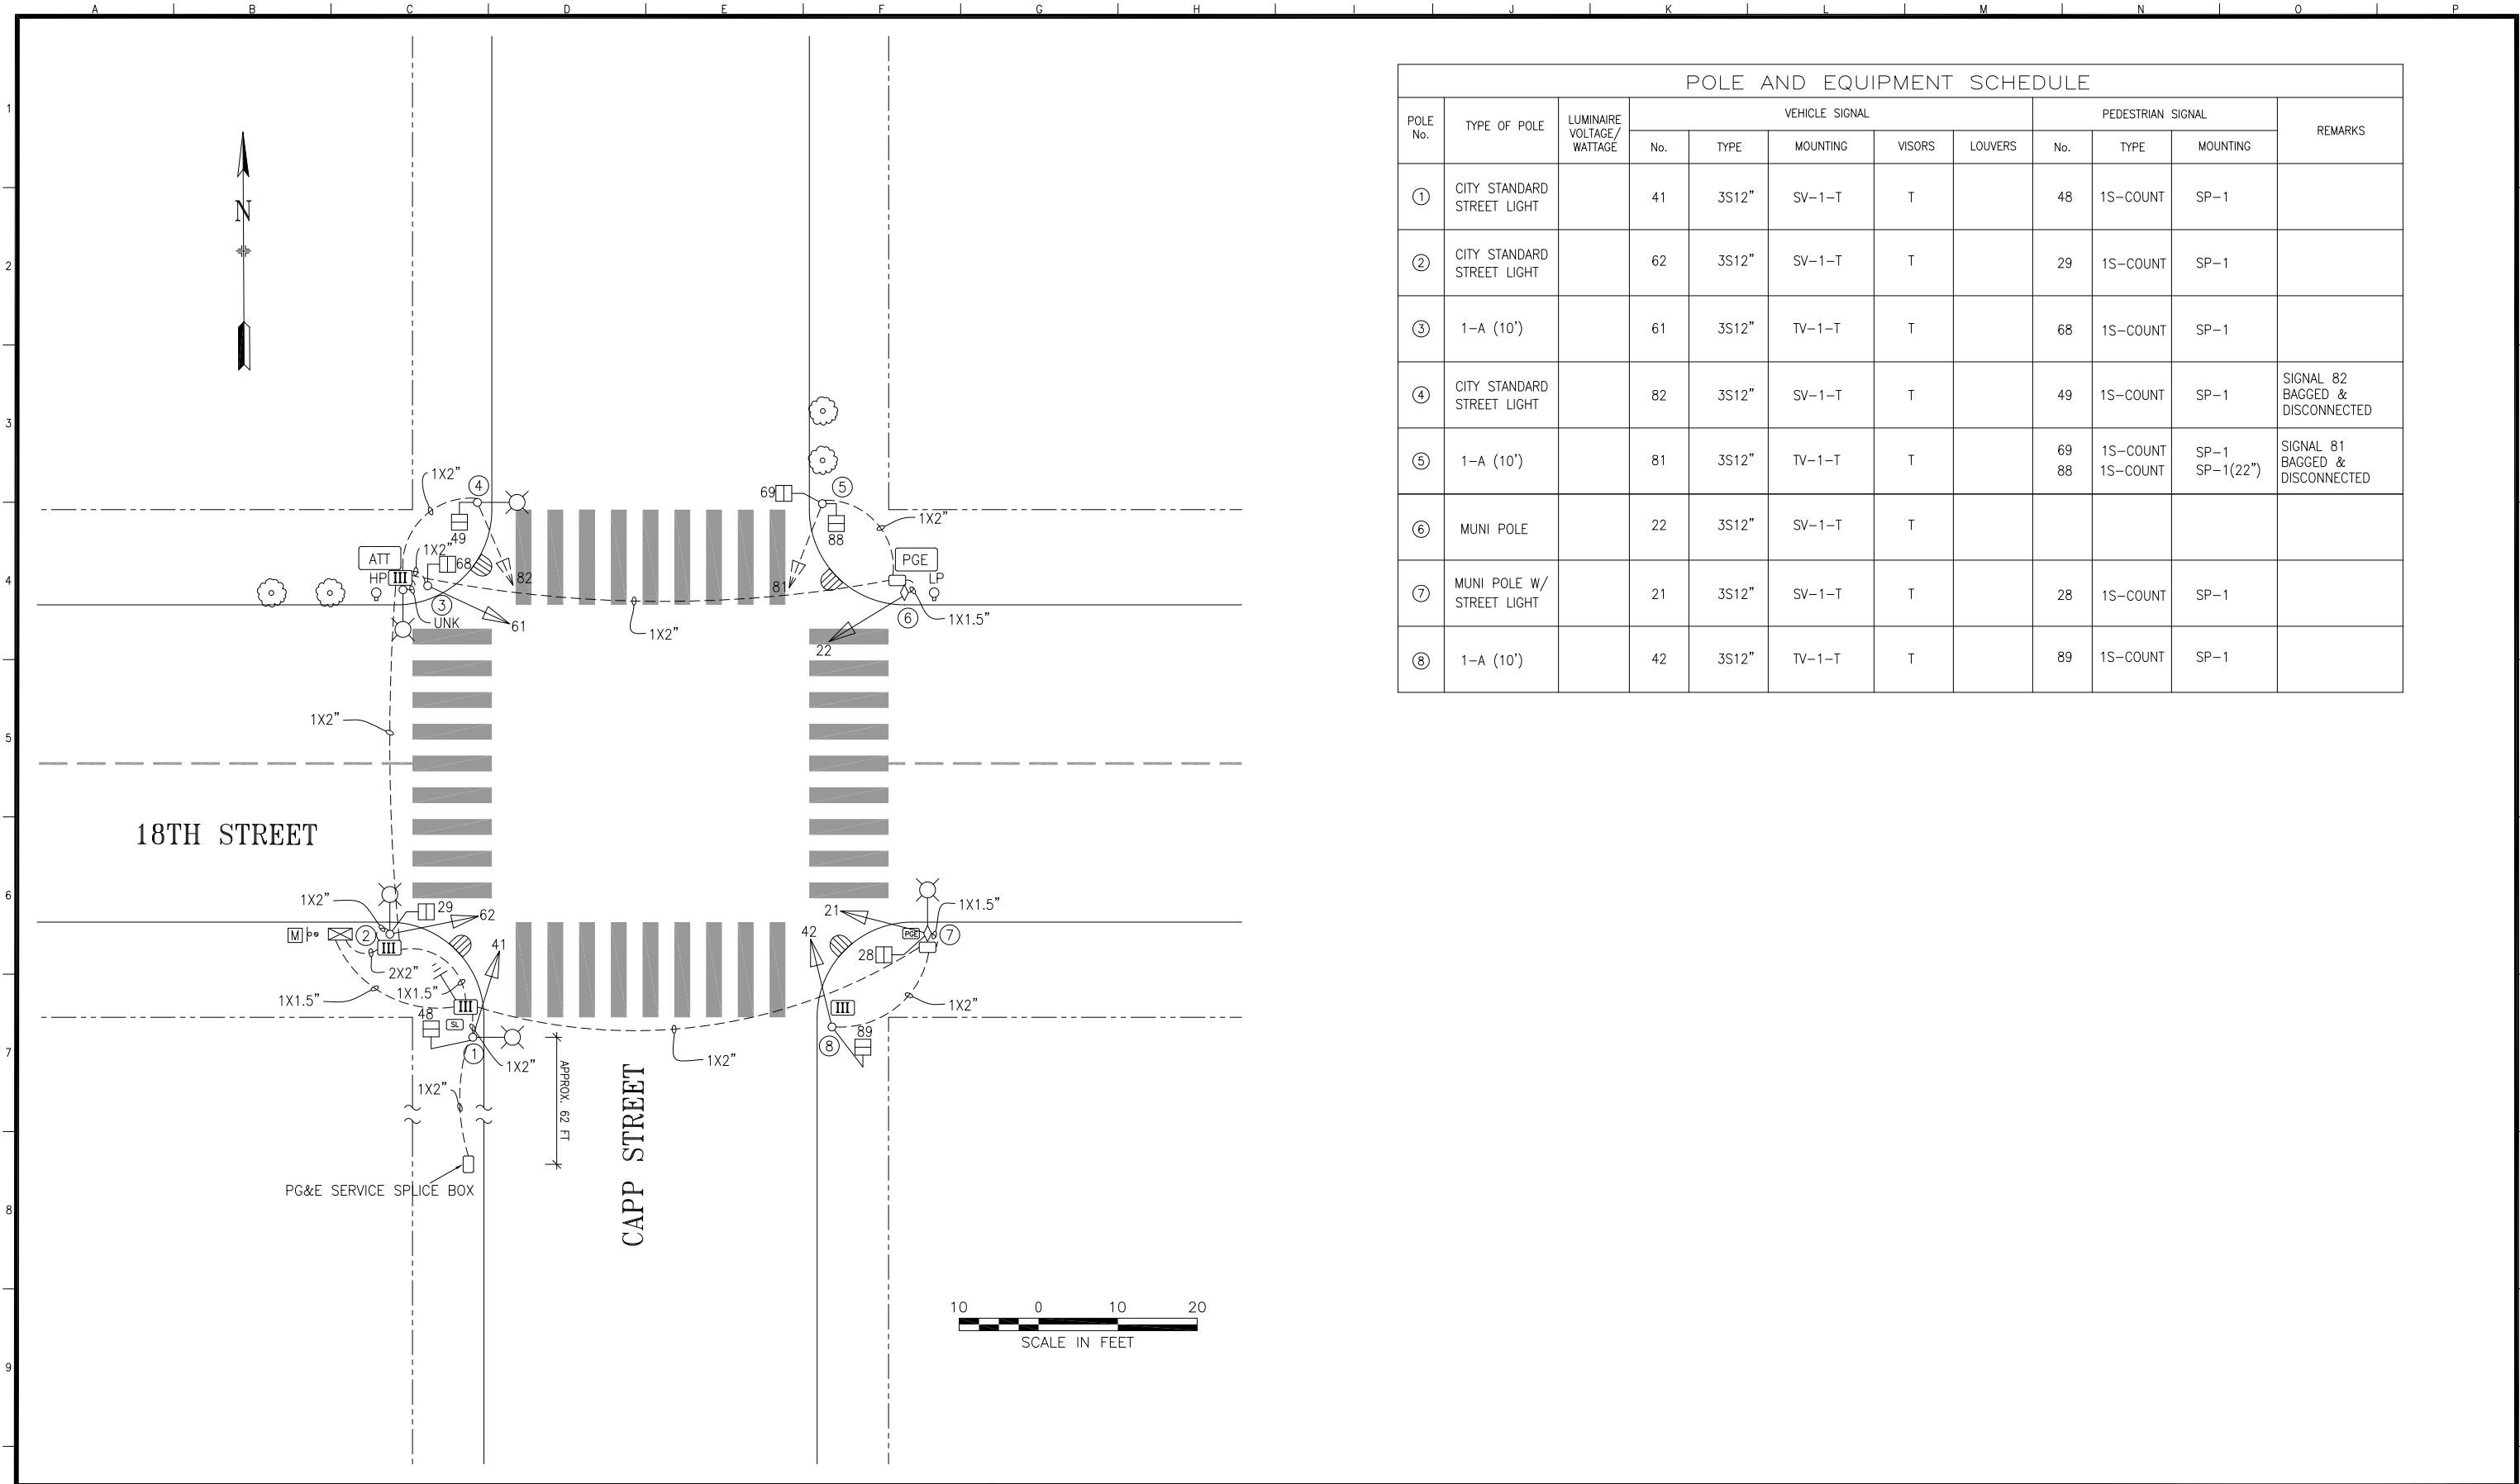

POLE AND EQUIPMENT SCHEDULE											
POLE No.	TYPE OF POLE	LUMINAIRE VOLTAGE/ WATTAGE	VEHICLE SIGNAL					PEDESTRIAN SIGNAL			REMARKS
			No.	TYPE	MOUNTING	VISORS	LOUVERS	No.	TYPE	MOUNTING	
①	CITY STANDARD STREET LIGHT		41	3S12"	SV-1-T	T		48	1S-COUNT	SP-1	
②	CITY STANDARD STREET LIGHT		62	3S12"	SV-1-T	T		29	1S-COUNT	SP-1	
③	1-A (10')		61	3S12"	TV-1-T	T		68	1S-COUNT	SP-1	
④	CITY STANDARD STREET LIGHT		82	3S12"	SV-1-T	T		49	1S-COUNT	SP-1	SIGNAL 82 BAGGED & DISCONNECTED
⑤	1-A (10')		81	3S12"	TV-1-T	T		69 88	1S-COUNT 1S-COUNT	SP-1 SP-1(22")	SIGNAL 81 BAGGED & DISCONNECTED
⑥	MUNI POLE		22	3S12"	SV-1-T	T					
⑦	MUNI POLE W/ STREET LIGHT		21	3S12"	SV-1-T	T		28	1S-COUNT	SP-1	
⑧	1-A (10')		42	3S12"	TV-1-T	T		89	1S-COUNT	SP-1	

2	2/21/23	2023-046: BAG & DISCONNECT SIGNALS 81,82 IN COORD W/ TEMP ST CLOSURE	J. HORNOSTEL	B. WOO
1	8/4/15	2543J PUNCHLIST WALKTHROUGH 12" HEADS AND PCS	D. YEUNG	M. VELASCO
0	3/18/99	NEW SIGNAL ACTIVATED THRU 1428N; CONVERTED FROM AS-BUILTS	D. YEUNG	M. VELASCO
NO.	DATE	DESCRIPTION	BY	APPROVED
TABLE OF REVISIONS CHECKOUT DRAWING THROUGH THE SID CUSTODIAN FOR THE LATEST REVISION				



SFMTA

DRAWN BY: A. SCALES	DATE: 9/2015
CHECKED BY: M. VELASCO	DATE: 9/2015

SCALE AS SHOWN
SHEET OF SHEETS 01 OF 01

TRAFFIC SIGNAL INVENTORY DIAGRAM
18TH STREET & CAPP STREET

CNN NO: 24133000
REV NO: 2