


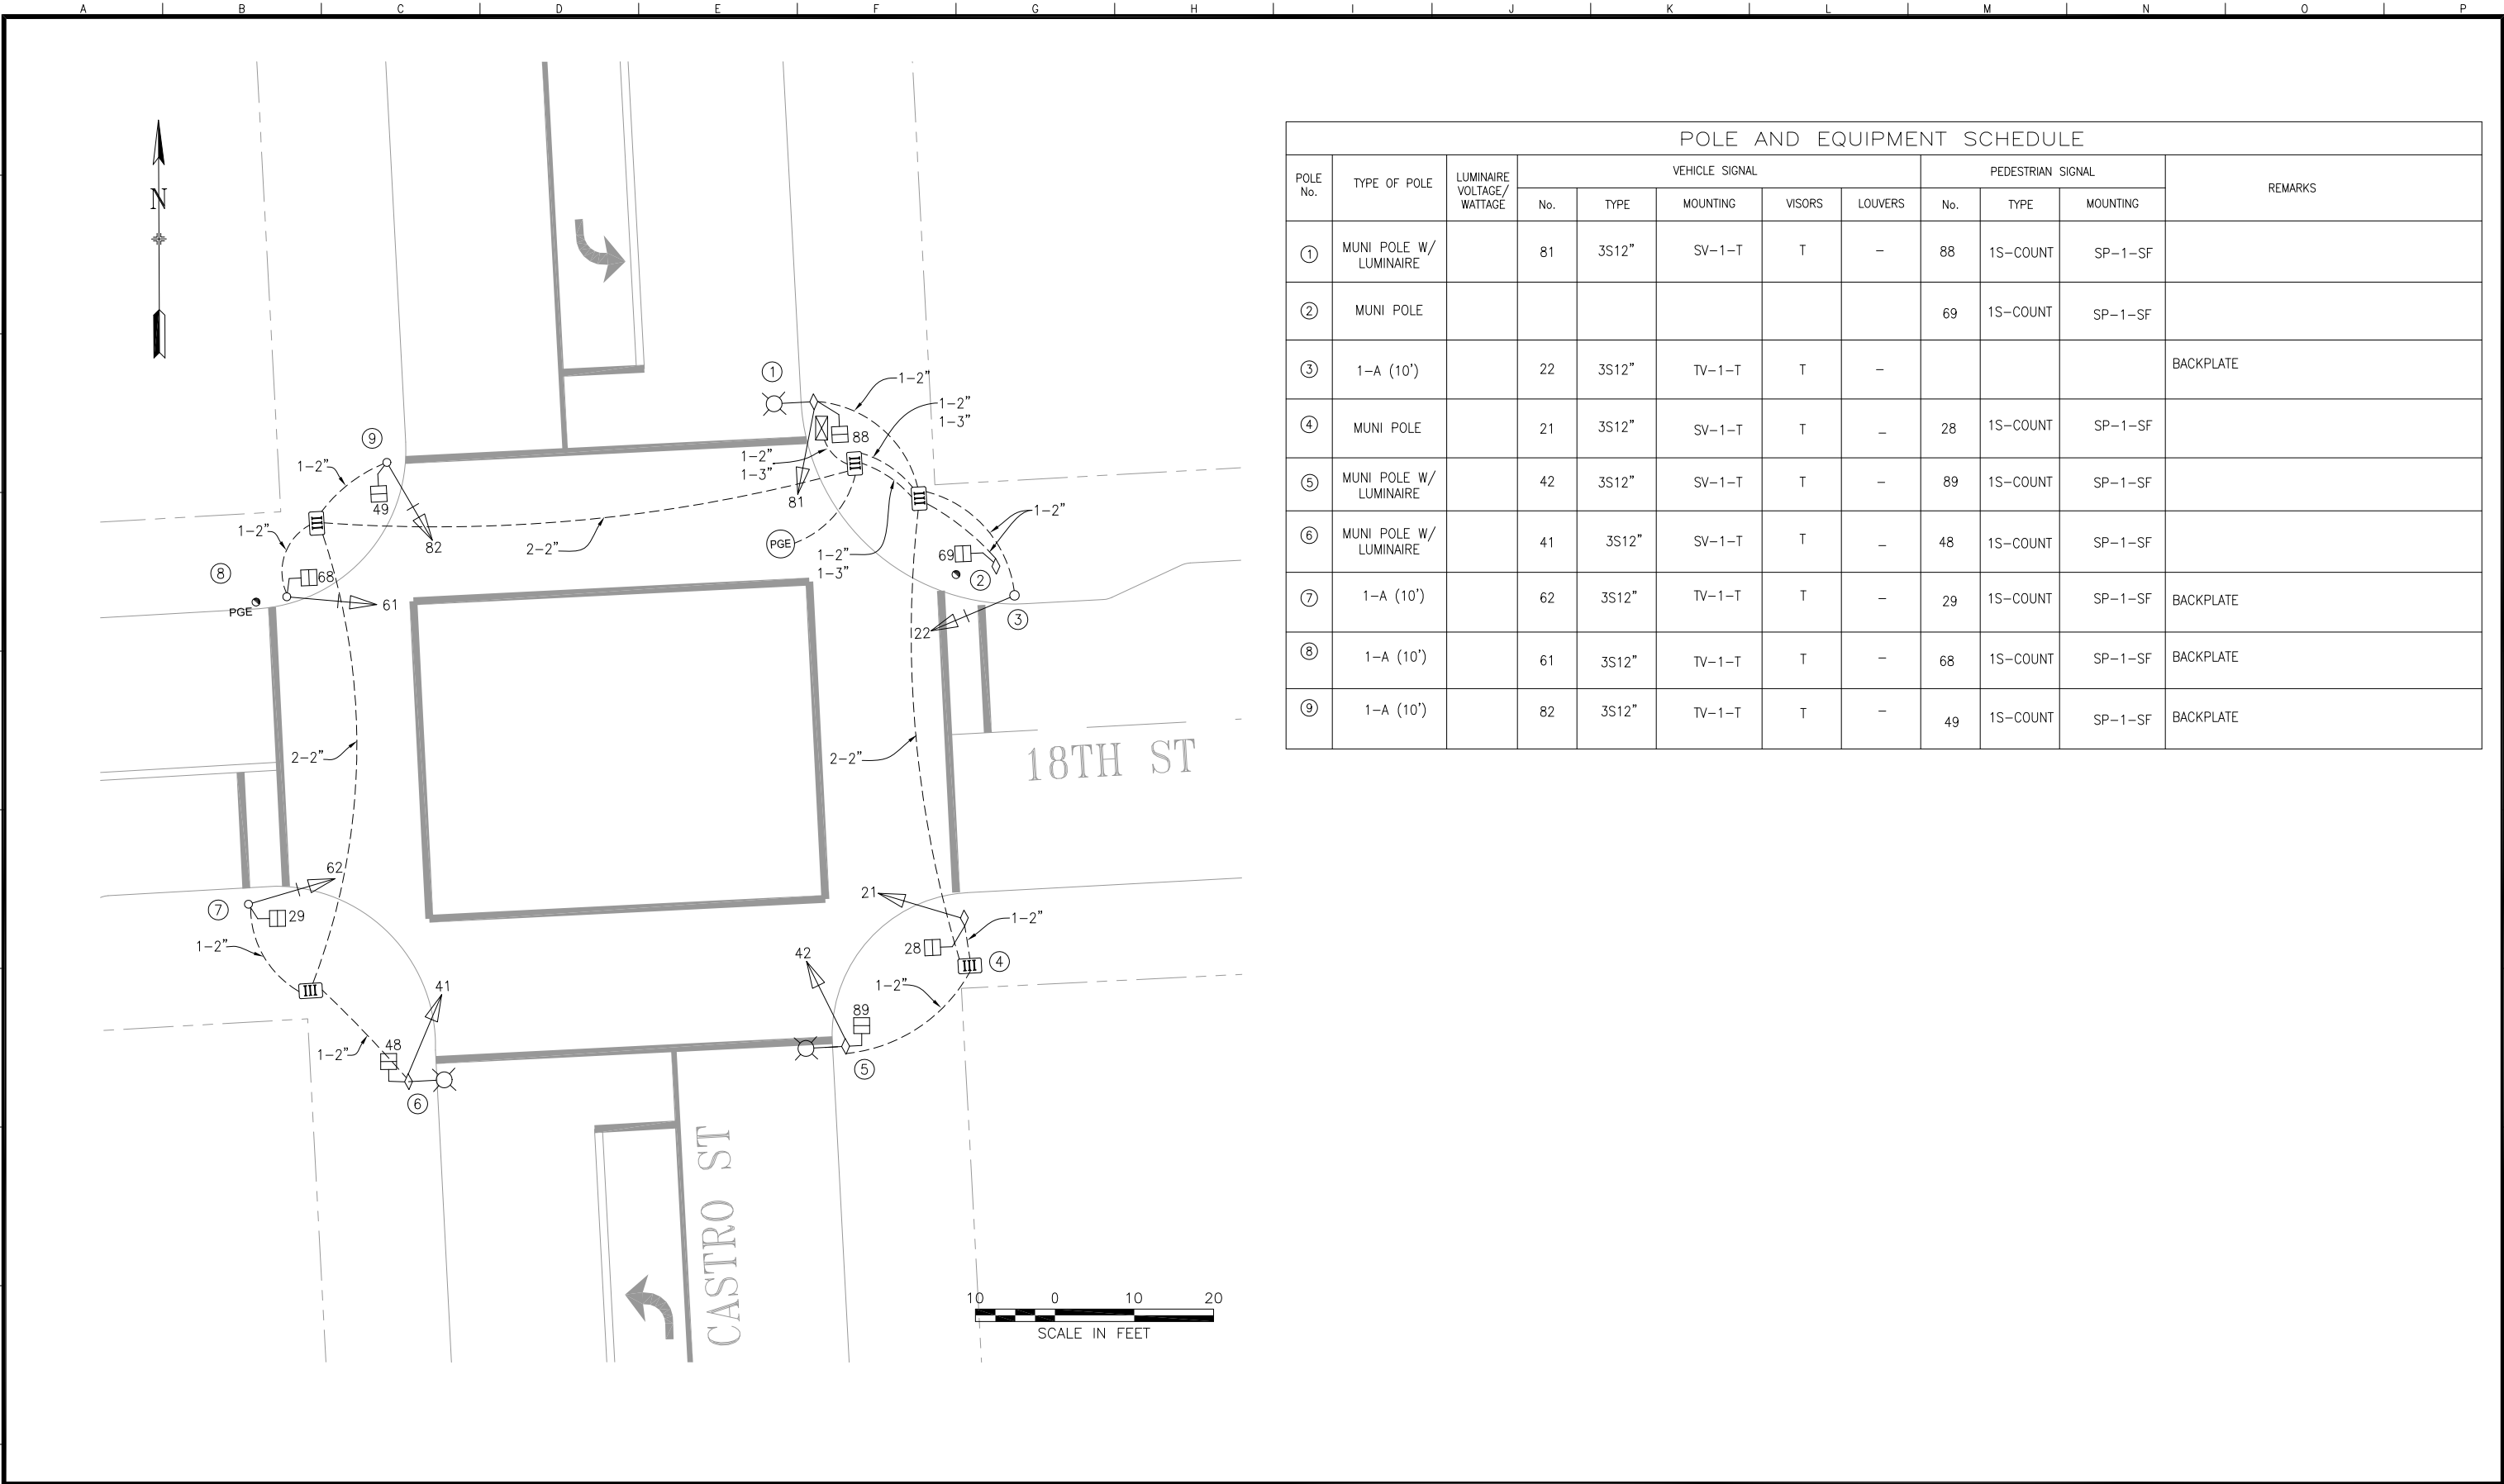

POLE AND EQUIPMENT SCHEDULE											
POLE No.	TYPE OF POLE	LUMINAIRE VOLTAGE/WATTAGE	VEHICLE SIGNAL					PEDESTRIAN SIGNAL			REMARKS
			No.	TYPE	MOUNTING	VISORS	LOUVERS	No.	TYPE	MOUNTING	
①	MUNI POLE W/ LUMINAIRE		81	3S12"	SV-1-T	T	-	88	1S-COUNT	SP-1-SF	
②	MUNI POLE							69	1S-COUNT	SP-1-SF	
③	1-A (10')		22	3S12"	TV-1-T	T	-				BACKPLATE
④	MUNI POLE		21	3S12"	SV-1-T	T	-	28	1S-COUNT	SP-1-SF	
⑤	MUNI POLE W/ LUMINAIRE		42	3S12"	SV-1-T	T	-	89	1S-COUNT	SP-1-SF	
⑥	MUNI POLE W/ LUMINAIRE		41	3S12"	SV-1-T	T	-	48	1S-COUNT	SP-1-SF	
⑦	1-A (10')		62	3S12"	TV-1-T	T	-	29	1S-COUNT	SP-1-SF	BACKPLATE
⑧	1-A (10')		61	3S12"	TV-1-T	T	-	68	1S-COUNT	SP-1-SF	BACKPLATE
⑨	1-A (10')		82	3S12"	TV-1-T	T	-	49	1S-COUNT	SP-1-SF	BACKPLATE

				REFERENCE INFORMATION & FILE NO. OF SURVEYS			SAN FRANCISCO MUNICIPAL TRANSPORTATION AGENCY CITY AND COUNTY OF SAN FRANCISCO			SCALE:	TRAFFIC SIGNAL INVENTORY DIAGRAM		CNN NO.				
										AS SHOWN			25813000				
										SHEET OF SHEETS	CASTRO ST. AT 18TH ST.		REV NO.				
										1 OF 1			0				
TABLE OF REVISIONS CHECK WITH TRACING TO SEE IF YOU HAVE LATEST REVISION																	
NO.	DATE	DESCRIPTION		BY	APP.												
10-21-14 SIGNAL MODS BY 2124J; CONVERTED FROM AS-BUILTS TO SID				LV/EO	MV												