


FOLSOM & 18th ST

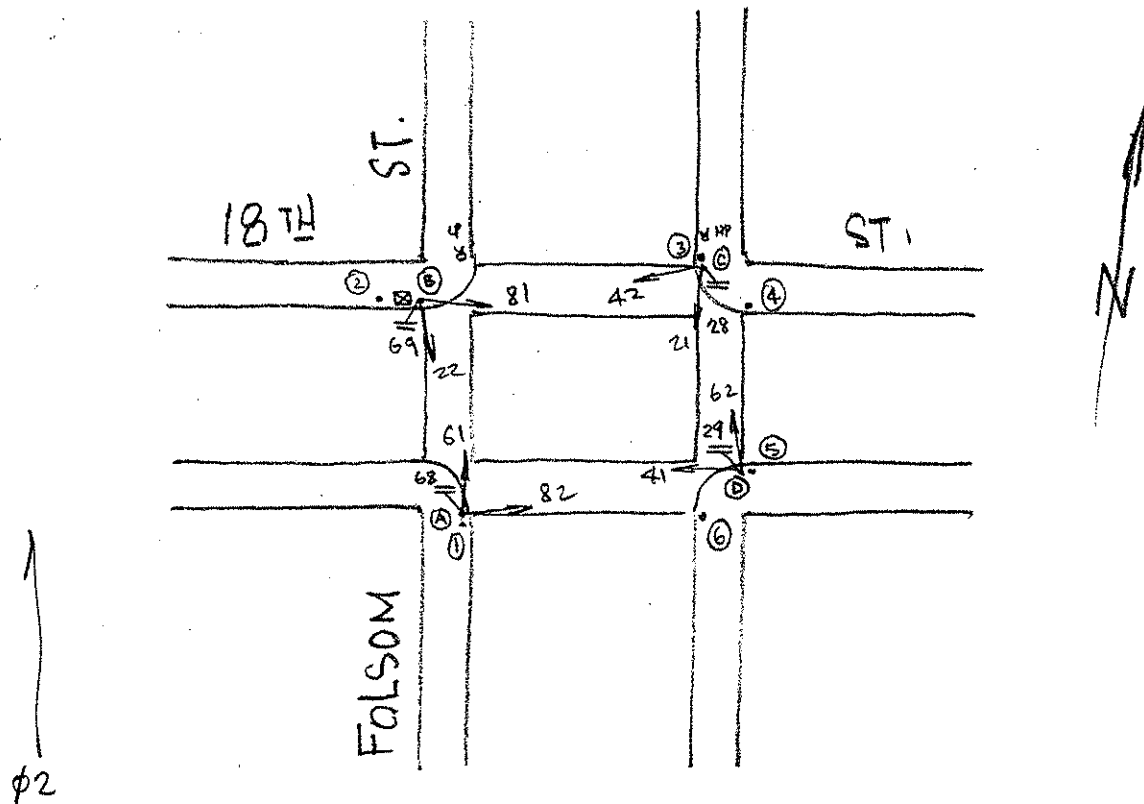

9-17-91

POLE	FUNC.	MAT'L	SIGNAL NO.	MAKE	NO. OF SECT.	SIZE	VISOR	B.P. OR LOUVERS	MOUN'T	PED SIGNAL NO.	LEGEND	MESSAGE		MAKE	MOUN'T
												ELEMENT	COLOR		
A	S	S	82	GA	3	8"	FL 8"	NO	T	68	W	15-1	W/OR	FCC	S
B	S	S	61	GA	3	8"	FL 8"	NO	T	69	W	15-1	W/OR	ICC	S
C	S	S	22	GA	3	8"	FL 8"	NO	T	28	W	15-1	W/OR	ICC	S
D	S	S	81	GA	3	8"	FL 8"	NO	T	29	W	15-1	W/OR	ICC	S
			42	GA	3	8"	FL 8"	NO	T						
			21	GA	3	8"	FL 8"	NO	T						
1	U	W	62	GA	3	8"	FL 8"	NO	T						
2	M	S	41	GA	3	8"	FL 8"	NO	T						
3	U	W													
4	M	S													
5	U	W													
6	U	W													

CONTROLLER CABINET SIZE : ORDINARY BASE CABINET: NO

COMMENTS: Replaced all ped. Signals with ICC