


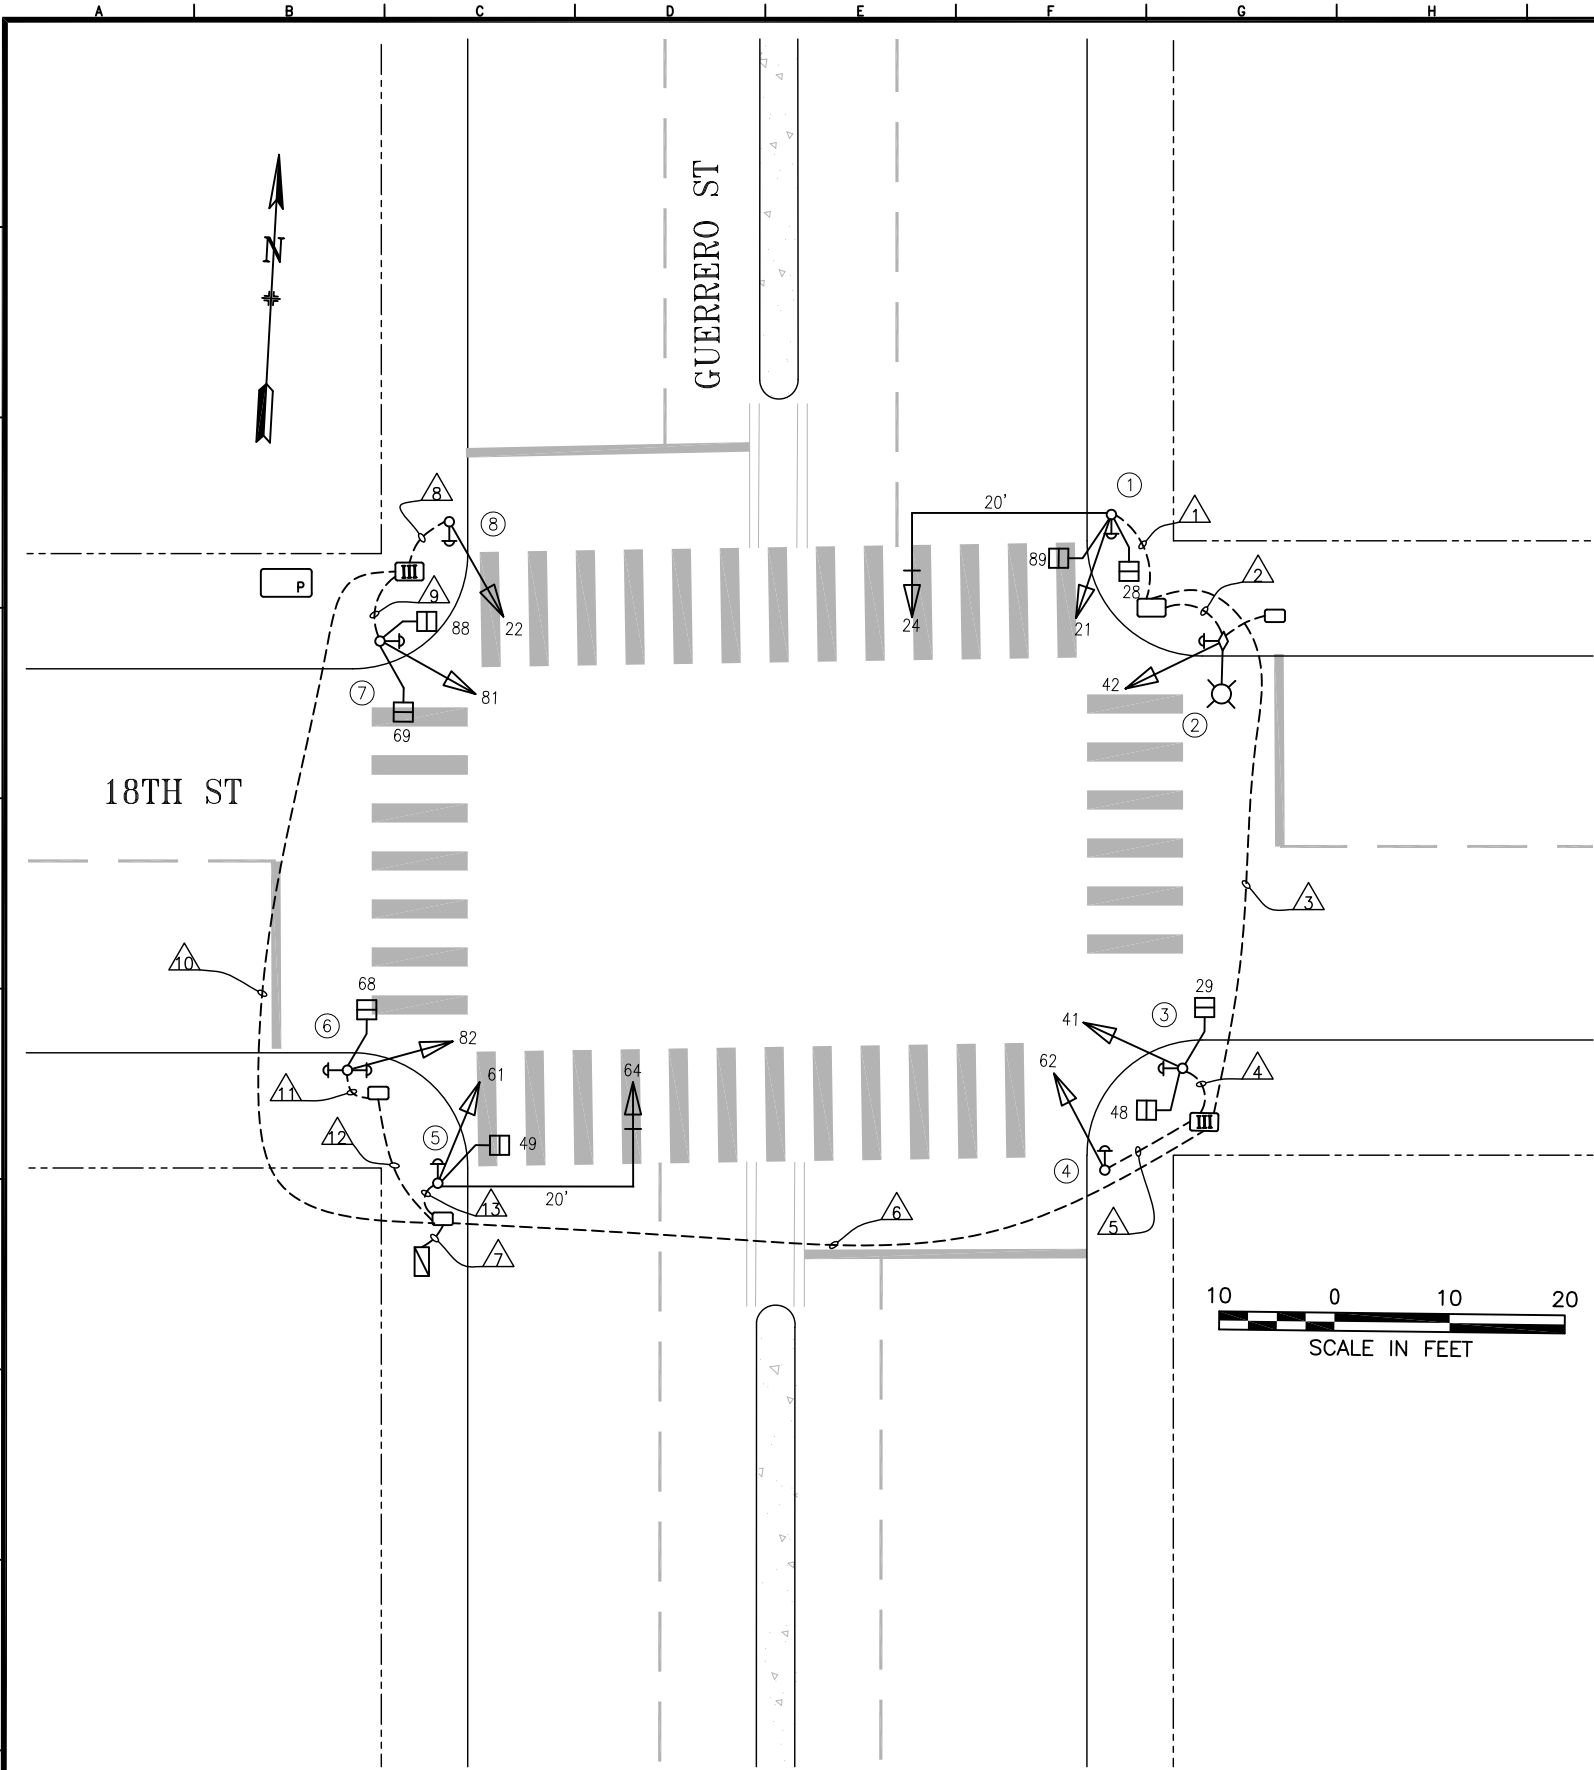

POLE AND EQUIPMENT SCHEDULE										
POLE No.	TYPE OF POLE	VEHICLE SIGNAL					PEDESTRIAN SIGNAL			REMARKS
		No.	TYPE	MOUNTING	VISORS	LOUVERS/BP	No.	TYPE	MOUNTING	
①	16-1-70 20' MAST ARM	21 24	3S12" 3S12"	SV-1-T MAS	T T	BP	89 28	1S-COUNT 1S-COUNT	SP-1 SP-1	APS-3W
②	MUNI 6' LUMINAIRE ARM	42	3S12"	SV-1-T	T					APS-3W
③	PEDESTAL SIGNAL POLE (10')	41	3S12"	TV-1-T	T T		48 29	1S-COUNT 1S-COUNT	SP-1 SP-1	APS-3W
④	1-A (10')	62	3S12"	TV-1-T						APS-3W
⑤	16-1-70 20' MAST ARM	61 64	3S12" 3S12"	SV-1-T MAS	T T	BP	49	1S-COUNT	SP-1	APS-3W
⑥	1-A (10')	82	3S12"	TV-1-T	T		68	1S-COUNT	SP-1	APS-3W x 2
⑦	1-A (10')	81	3S12"	TV-1-T	T		88 69	1S-COUNT 1S-COUNT	SP-1 SP-1	APS-3W
⑧	1-A (10')	22	3S12"	TV-1-T	T					APS-3W

Δ	5/24/23	INSTALL APS (2023-026)	E. LUU	G. DE LEON	
Δ	5/18/23	21, 41, 61, 62 (MOVE TO POLE 4), & 82 TO 3S12" (2023-030)	E. LUU	G. DE LEON	
Δ	5/13/17	CONVERTED FROM CONTRACTS 1292, 21 (7058E)	E. TRAN	D. VALLE-SCHWENK	
NO.	DATE	DESCRIPTION	BY	APPROVED	
TABLE OF REVISIONS CHECKOUT DRAWING THROUGH THE SID CUSTODIAN FOR THE LATEST REVISION					



SFMTA

DRAWN BY: E. TRAN	DATE: 5/12/2022
CHECKED BY: D. VALLE-SCHWENK	DATE: 5/12/2022

SCALE AS SHOWN
SHEET OF SHEETS 1 OF 2

TRAFFIC SIGNAL INVENTORY DIAGRAM
18TH STREET & GUERRERO STREET

CNN NO: 25677000
REV NO: 2

