


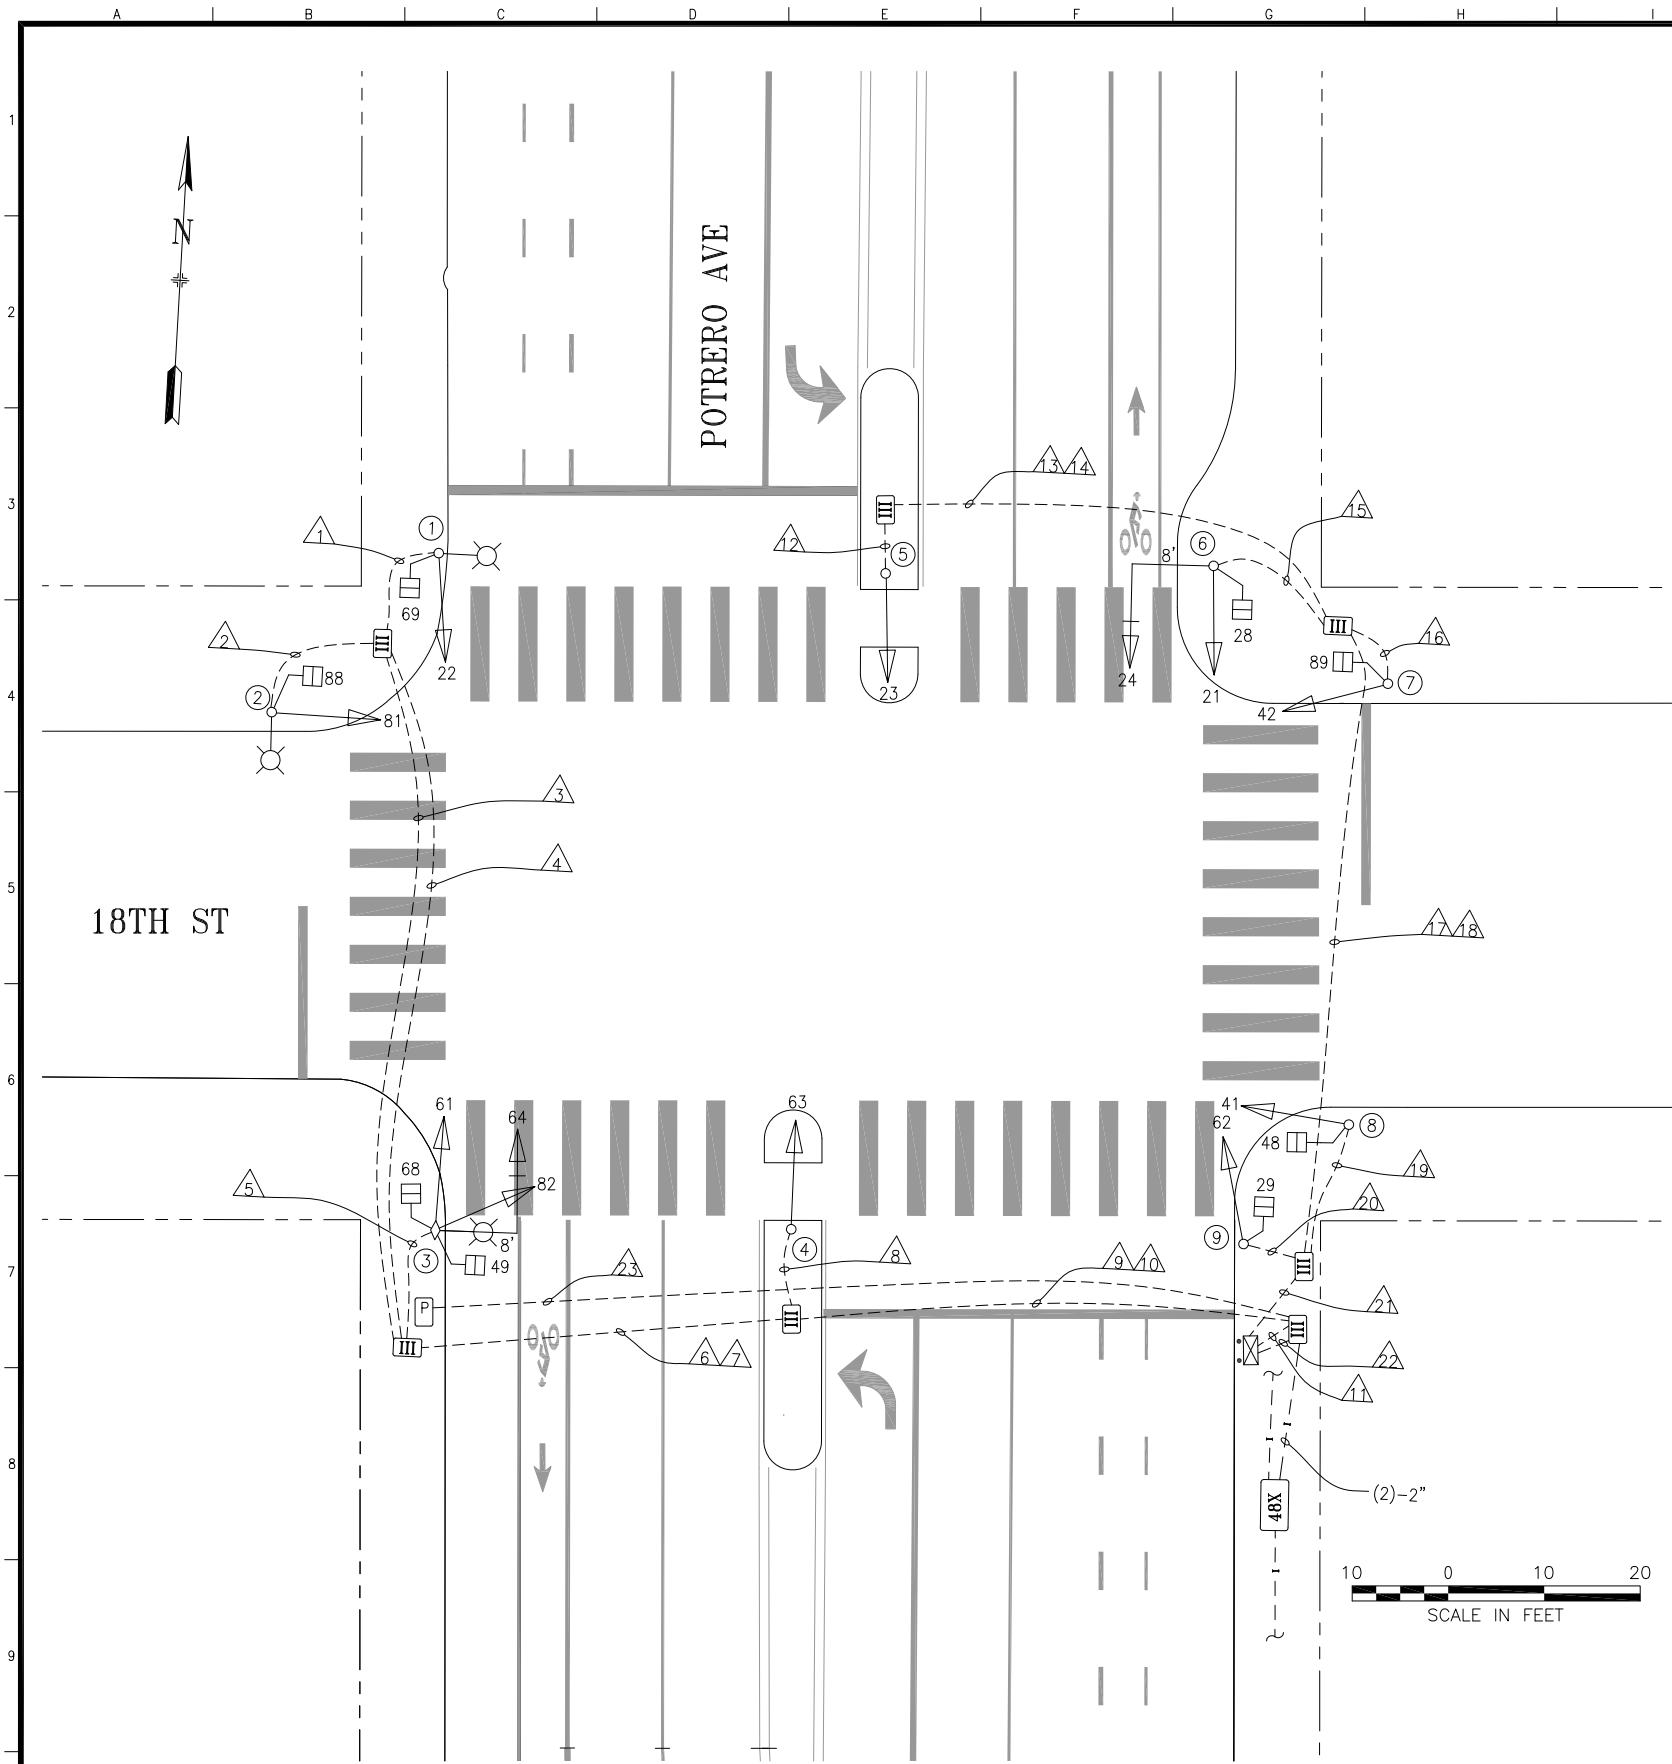

POLE & EQUIPMENT SCHEDULE										
POLE No.	TYPE OF POLE	VEHICLE SIGNAL					PEDESTRIAN SIGNAL			REMARKS
		No.	TYPE	MOUNTING	VISORS	LOUVERS/BP	No.	TYPE	MOUNTING	
①	STREETLIGHT POLE	22	3S12"	SV-1-T	T		69	1S-COUNT	SP-1	
②	STREETLIGHT POLE	81	3S12"	SV-1-T	T		88	1S-COUNT	SP-1	
③	MUNI TROLLEY POLE & SL W/ 8' MAST ARM	61 82 64	3S12" 3S12" 3S12"	SV-2-TC W/ EXTENDER & COUPLER MAS	T T T	BP	49 68	1S-COUNT 1S-COUNT	SP-2-T-SF	TSP
④	1-A (10')	63	3S12"	TV-1-T	T					
⑤	1-A (10')	23	3S12"	TV-1-T	T					
⑥	16-1-70 W/ 8' MAST ARM	21 24	3S12" 3S12"	TV-1-T MAS	T T	BP	28	1S-COUNT	SP-1	TSP
⑦	1-A (10')	42	3S12"	TV-1-T	T		89	1S-COUNT	SP-1	
⑧	1-A (10')	41	3S12"	TV-1-T	T		48	1S-COUNT	SP-1	
⑨	1-A (10')	62	3S12"	TV-1-T	T		29	1S-COUNT	SP-1	

0	03/07/18	UPGRADED BY 2127J; CONVERTED FROM AS-BUILTS	Hfu	Vventura	
NO.	DATE	DESCRIPTION	BY	APP.	
TABLE OF REVISIONS					
CHECK WITH TRACING TO SEE IF YOU HAVE LATEST REVISION					

REFERENCE INFORMATION
& FILE NO. OF SURVEYS



SAN FRANCISCO MUNICIPAL TRANSPORTATION AGENCY
CITY AND COUNTY OF SAN FRANCISCO

DRAWN: DATE:
H.YU 07/2019
CHECKED: DATE:
L.VENTURA 09/2020

SCALE:

AS SHOWN

SHEET OF SHEETS

1 OF 2

TRAFFIC SIGNAL INVENTORY DIAGRAM

18TH STREET AND POTRERO AVENUE

CNN NO.

24004000

REV NO.

0

CONDUIT & WIRING SCHEDULE																										
CONDUIT RUN NUMBER			△1	△2	△3	△4	△5	△6	△7	△8	△9	△10	△11	△12	△13	△14	△15	△16	△17	△18	△19	△20	△21	△22	△23	
CONDUIT SIZE (INCH) & TYPE			2"	2"	2"	2"	2"	2"	2"	2"	2"	3"	2"	2"	2"	2"	2"	2"	2"	2"	2"	2"	3"	2"	2"	
	NOTES / REMARKS					SP			SP			SP				SP				SP						
#14 AWG WIRES	POLE 1	VEH SIGNAL 22	3		3			3			3		3													
	POLE 1	PED SIGNAL 69	2		2			2			2		2													
	POLE 2	VEH SIGNAL 81		3	3			3			3		3													
	POLE 2	PED SIGNAL 88		2	2			2			2		2													
	POLE 3	VEH SIGNAL 61					3	3			3		3													
	POLE 3	VEH SIGNAL 64					3	3			3		3													
	POLE 3	VEH SIGNAL 82					3	3			3		3													
	POLE 3	PED SIGNAL 49					2	2			2		2													
	POLE 3	PED SIGNAL 68					2	2			2		2													
	POLE 4	VEH SIGNAL 63								3	3		3													
	POLE 5	VEH SIGNAL 23												3	3				3				3			
	POLE 6	VEH SIGNAL 21															3		3				3			
	POLE 6	VEH SIGNAL 24															3		3				3			
	POLE 6	PED SIGNAL 28															2		2				2			
	POLE 7	VEH SIGNAL 42																3	3				3			
	POLE 7	PED SIGNAL 89																2	2				2			
	POLE 8	VEH SIGNAL 41																			3		3			
	POLE 8	PED SIGNAL 48																			2		2			
	POLE 9	VEH SIGNAL 62																					3	3		
	POLE 9	PED SIGNAL 29																					2	2		
		NEUTRAL		2	2			3			1				1			3	2			2	2			
		SPARE				3			3			3		3		3				3				3		
	WIRE TOTALS		TOTAL #14 AWG	7	7	13		16	26		4	29		29	4	6		11	7	19		7	7	29		
		TOTAL #10 NEUTRAL			1			2			3		3		1				2				3			
		TOTAL #8 WIRES (120 V SERVICE)																						2	2	
		TOTAL #6 BSCW																						1		
CONDUIT RUN NUMBER			△1	△2	△3	△4	△5	△6	△7	△8	△9	△10	△11	△12	△13	△14	△15	△16	△17	△18	△19	△20	△21	△22	△23	

[illegible][illegible]

0	03/07/18	UPGRADED BY 2127J; CONVERTED FROM AS-BUILTS	HYU	LVentur
NO.	DATE	DESCRIPTION	BY	APP.
TABLE OF REVISIONS				
CHECK WITH TRACING TO SEE IF YOU HAVE LATEST REVISION				

REFERENCE INFORMATION & FILE NO. OF SURVEYS



SAN FRANCISCO MUNICIPAL TRANSPORTATION AGENCY
CITY AND COUNTY OF SAN FRANCISCO

DRAWN:	DATE:
H.YU	07/2019
CHECKED:	DATE:
L.VENTURA	09/2020

CHECKED: DATE:
L.VENTURA 09/2020

SCALE:
SHEET OF SHEETS
2 OF 2

SHEET OF SHEETS
2 OF 2

TRAFFIC SIGNAL INVENTORY DIAGRAM
18TH STREET AND POTRERO AVENUE

18TH STREET AND POTRERO AVENUE

CNN NO.	24004000
REV NO.	0

24004000
REV NO.
0