


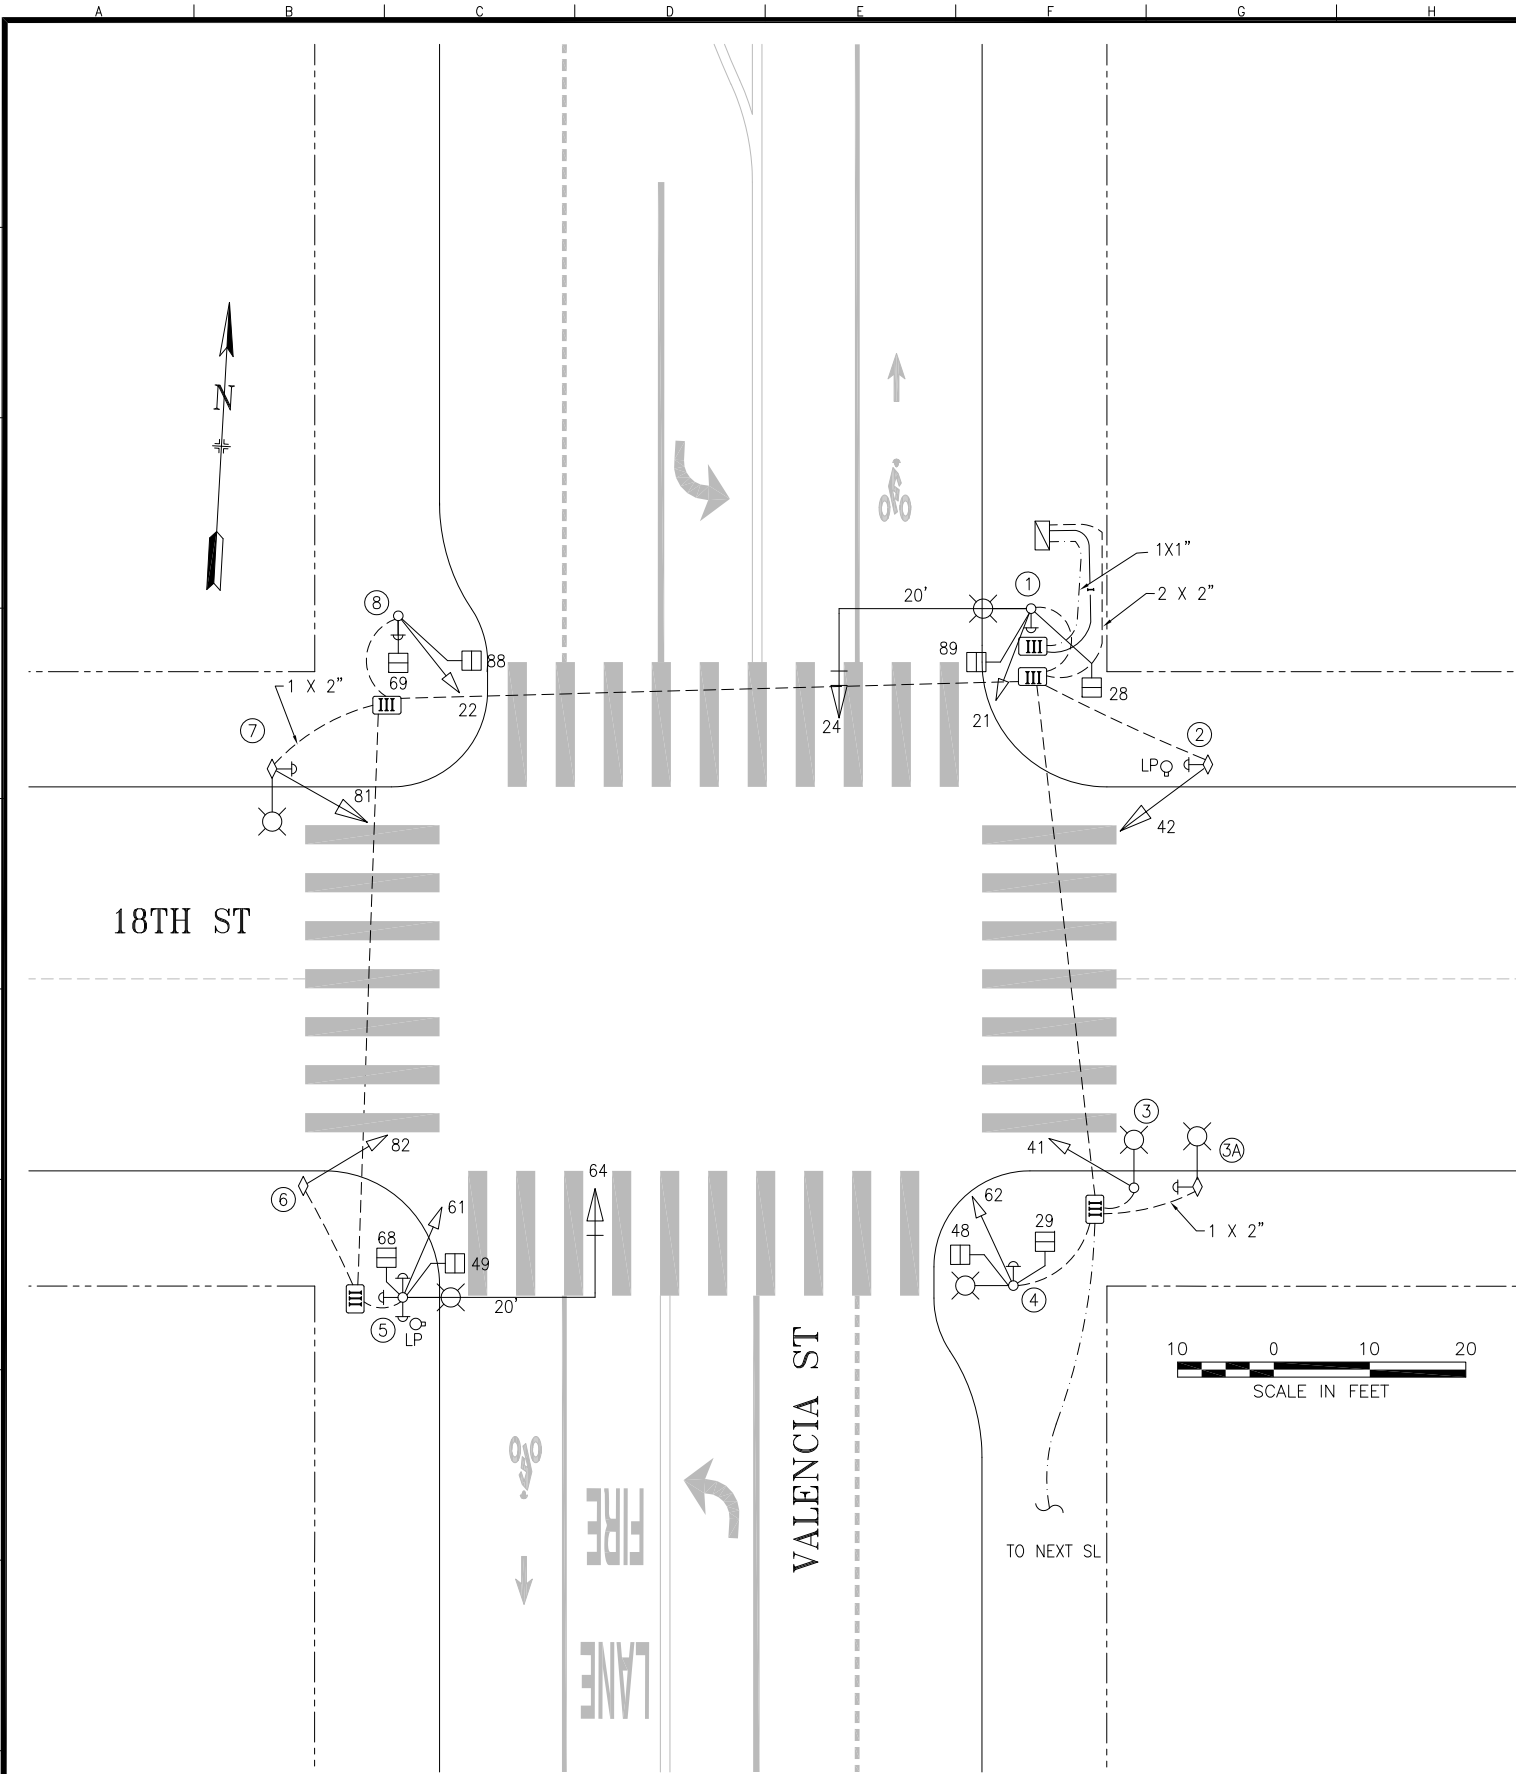

POLE AND EQUIPMENT SCHEDULE										
POLE No.	TYPE OF POLE	VEHICLE SIGNAL					PEDESTRIAN SIGNAL			REMARKS
		No.	TYPE	MOUNTING	VISORS	LOUVERS/BP	No.	TYPE	MOUNTING	
①	17B-1-70 WITH 20' MA AND 6' LA	24 21	3S12" 3S8"	MAS SV-1-T	T T	BP	28 89	1S-COUNT 1S-COUNT	SP-1 SP-1	APS - 3W
②	MUNI POLE	42	3S12"	SV-1-T	T					APS - 3W
③	WOOD POLE + SL	41	3S8"	SV-1	T					EXTERNAL CONDUIT
③A	MUNI POLE W/ 6' LA									APS - 3W
④	SL W/ 6' LA	62	3S8"	SV-1-T	T		29 48	1S-COUNT 1S-COUNT	SP-1 SP-1	APS - 3W
⑤	17B-1-70 WITH 20' MA AND 6' LA	64 61	3S12" 3S8"	MAS SV-1-T	T T	BP	68 49	1S-COUNT 1S-COUNT	SP-1 SP-1	APS - 3W APS - 3W APS - 3W
⑥	WP + MUNI	82	3S8"	SV-1	T					EXTERNAL CONDUIT
⑦	MUNI POLE W/ 6' LA	81	3S12"	SV-1-T	T					APS - 3W
⑧	1-A (10')	22	3S8"	TV-1	T		69 88	1S-COUNT 1S-COUNT	SP-1 SP-1	APS - 3W

3	4/14/23	INSTALL APS PER SRC 2022-199	D. Yeung	G. de Leon
2	3/21/22	UPDATED PER FIELD CHECK & MUNI CONTRACT 1292 AS-BUILT	D. Yeung	G. de Leon
1	07/05	ADD ADDITIONAL PED SIGNALS BY SIGNAL SHOP.	CXL	JK
NO.	DATE	DESCRIPTION	BY	APPROVED
TABLE OF REVISIONS CHECKOUT DRAWING THROUGH THE SID CUSTODIAN FOR THE LATEST REVISION				



SFMTA

DRAWN BY:		DATE:	
CXL		4/03	
CHECKED BY:		DATE:	
JK		5/06	

SCALE
1" = 20'
SHEET OF SHEETS
1 OF 1

TRAFFIC SIGNAL INVENTORY DIAGRAM
18TH ST AND VALENCIA ST

CNN NO:
24160000
REV NO:
3