



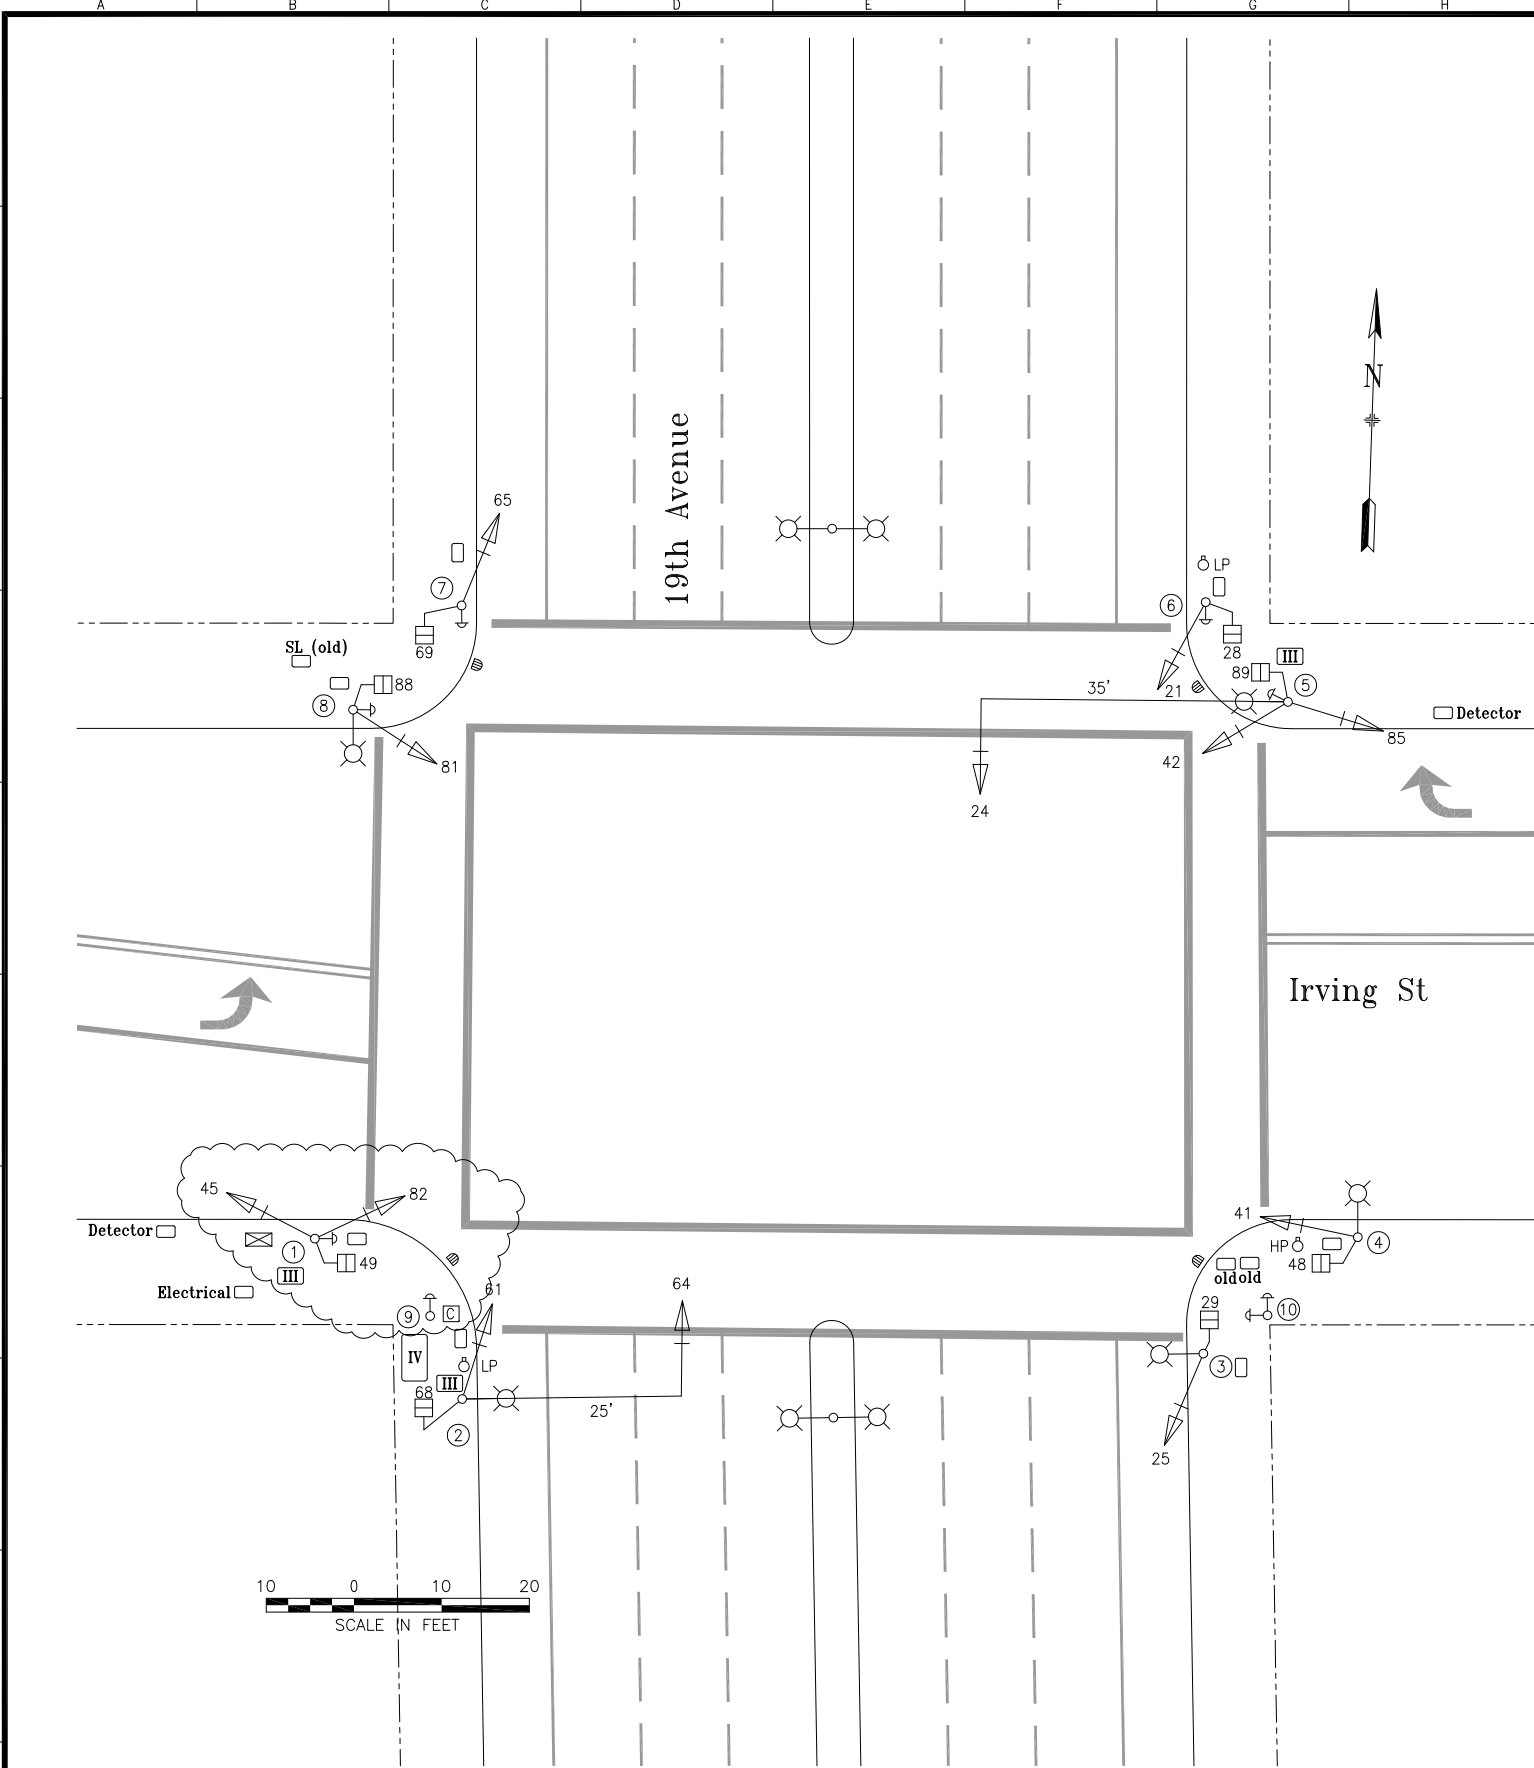

POLE AND EQUIPMENT SCHEDULE											
POLE No.	TYPE OF POLE	LUMINAIRE VOLTAGE/ WATTAGE	VEHICLE SIGNAL					PEDESTRIAN SIGNAL			REMARKS
			No.	TYPE	MOUNTING	VISORS	LOUVERS/BP	No.	TYPE	MOUNTING	
①	1-A (10')		45 82	3S12" 3S12"	TV-2-T	T T	BP BP	49	1S-COUNT	SP-1-T	PPB
②	19-2-100 WITH 25' MAST ARM AND 8' LUMINAIRE ARM	200	61 64	3S12" 3S12"	SV-1-T MAS	T T	BP BP	68	1S-COUNT	SP-1-T	
③	15TS WITH 8' LUMINAIRE ARM	200	25	3S12"	SV-1-T	T	BP	29	1S-COUNT	SP-1-T	
④	15TS WITH 8' LUMINAIRE ARM	200	41	3S12"	SV-1-T	T	BP	48	1S-COUNT	SP-1-T	
⑤	24-4-100 WITH 35' MAST ARM AND 8' LUMINAIRE ARM	200	24 42 85	3S12" 3S12" 3S12"	MAS SV-2-T	T T T	BP BP BP	89	1S-COUNT	SP-1-T	PPB
⑥	1-A (10')		21	3S12"	TV-1-T	T	BP	28	1S-COUNT	SP-1-T	PPB
⑦	1-A (10')		65	3S12"	TV-1-T	T	BP	69	1S-COUNT	SP-1-T	PPB
⑧	15TS WITH 8' LUMINAIRE ARM	200	81	3S12"	SV-1-T	T	BP	88	1S-COUNT	SP-1-T	PPB
⑨	PPB POST										PPB
⑩	PPB POST										PPB (2)

PHASE DIAGRAM

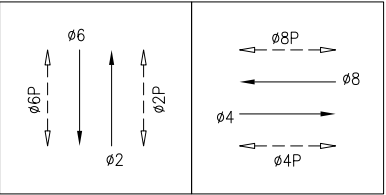

PHASE SEQUENCE

G	Y	R	19TH AVE (NB & SB) - 02 & 06		
R		G	Y	R	IRVING ST (EB & WB) - 04 & 08
WM	FRH	RH			PED XING IRVING ST (E/S & W/S) - 02P & 06P
RH		WM	FRH	RH	PED XING 19TH AVE (S/S & N/S) - 04P & 08P

1	9/2012	PER FIELD CHECK	GD	ET
0	3/5/2009	SIGNAL UPGRADE ACTIVATED THROUGH CONTRACT # 04-162514; CONVERTED FROM CONTRACT PLANS	GD	ET
NO.	DATE	DESCRIPTION	BY	APP.
TABLE OF REVISIONS CHECK WITH TRACING TO SEE IF YOU HAVE LATEST REVISION				

REFERENCE INFORMATION & FILE NO. OF SURVEYS	SIGNAL UPGRADE THROUGH CALTRANS 19TH AVE PHASE #1
--	---

SAN FRANCISCO MUNICIPAL TRANSPORTATION AGENCY

CITY AND COUNTY OF SAN FRANCISCO

DRAWN: GD	DATE: 9/5/2012	SCALE: AS SHOWN	TRAFFIC SIGNAL INVENTORY DIAGRAM	CNN NO. 27372000
CHECKED: ET	DATE: 9/5/2012	SHEET OF SHEETS 1 OF 1	19TH AVENUE AND IRVING ST	REV NO. 1