


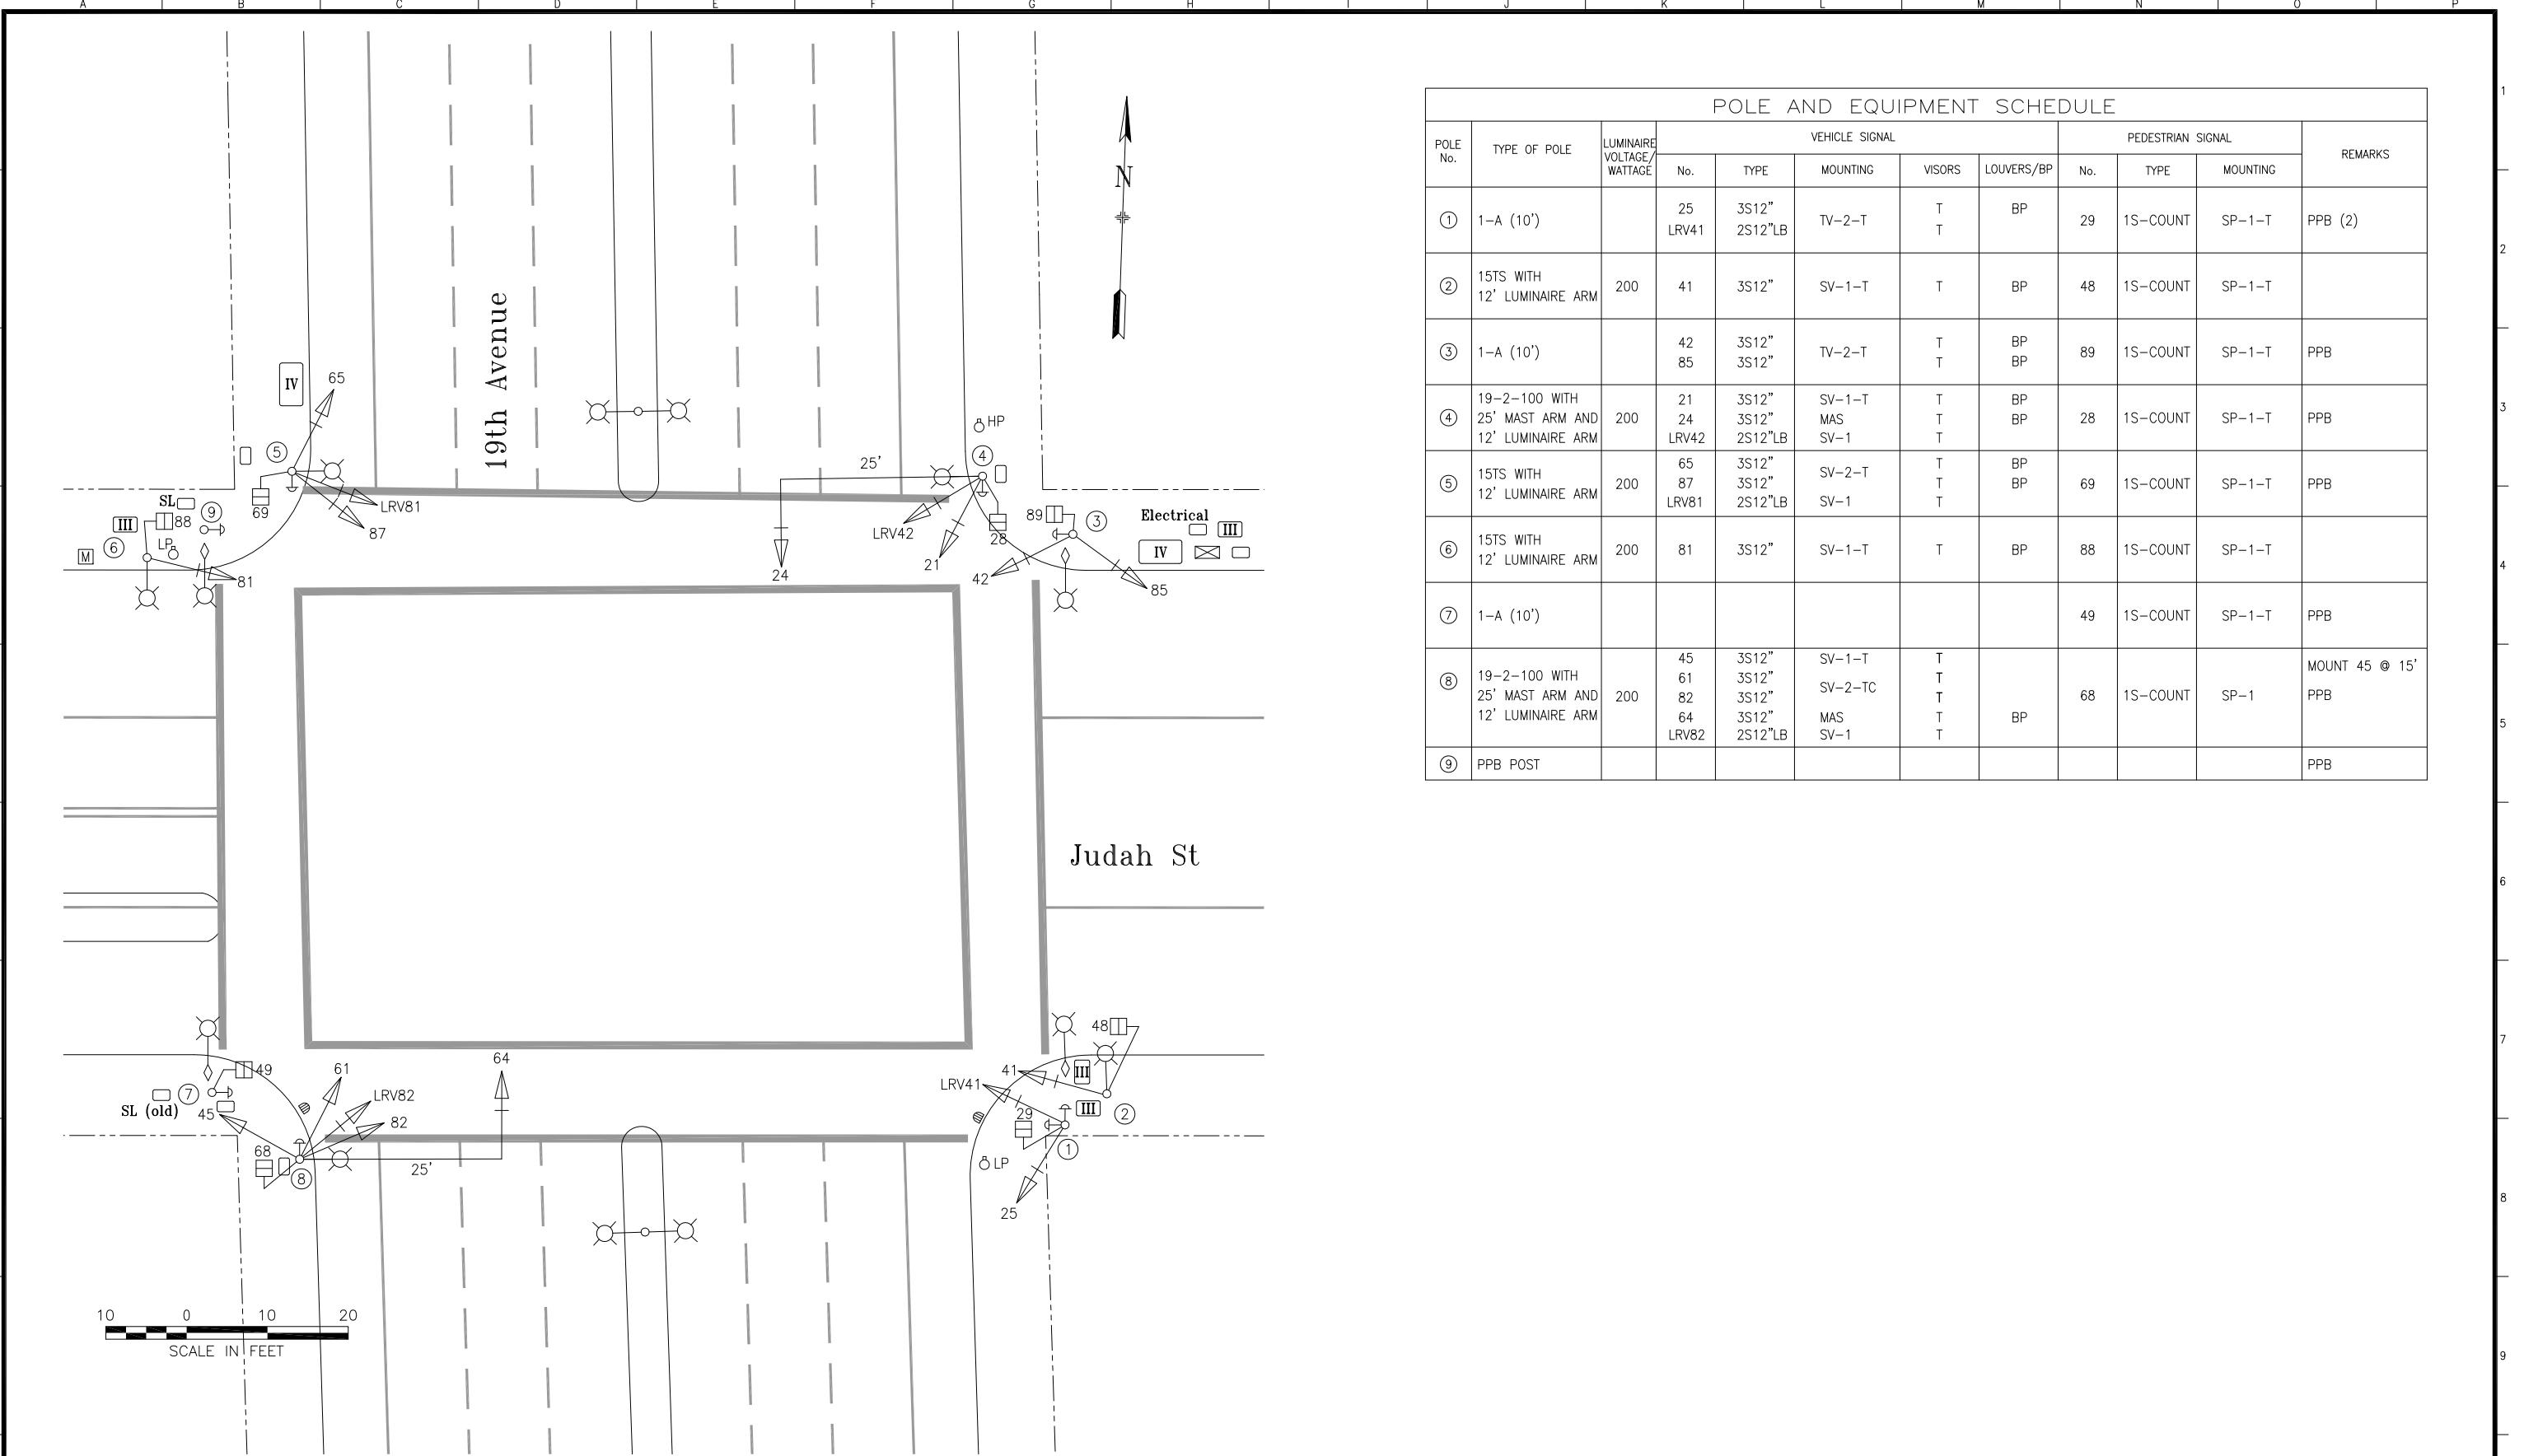

POLE AND EQUIPMENT SCHEDULE											
POLE No.	TYPE OF POLE	LUMINAIRE VOLTAGE/WATTAGE	VEHICLE SIGNAL					PEDESTRIAN SIGNAL			REMARKS
			No.	TYPE	MOUNTING	VISORS	LOUVERS/BP	No.	TYPE	MOUNTING	
①	1-A (10')		25 LRV41	3S12" 2S12"LB	TV-2-T	T T	BP	29	1S-COUNT	SP-1-T	PPB (2)
②	15TS WITH 12' LUMINAIRE ARM	200	41	3S12"	SV-1-T	T	BP	48	1S-COUNT	SP-1-T	
③	1-A (10')		42 85	3S12" 3S12"	TV-2-T	T T	BP BP	89	1S-COUNT	SP-1-T	PPB
④	19-2-100 WITH 25' MAST ARM AND 12' LUMINAIRE ARM	200	21 24 LRV42	3S12" 3S12" 2S12"LB	SV-1-T MAS SV-1	T T T	BP BP	28	1S-COUNT	SP-1-T	PPB
⑤	15TS WITH 12' LUMINAIRE ARM	200	65 87 LRV81	3S12" 3S12" 2S12"LB	SV-2-T SV-1	T T T	BP BP	69	1S-COUNT	SP-1-T	PPB
⑥	15TS WITH 12' LUMINAIRE ARM	200	81	3S12"	SV-1-T	T	BP	88	1S-COUNT	SP-1-T	
⑦	1-A (10')							49	1S-COUNT	SP-1-T	PPB
⑧	19-2-100 WITH 25' MAST ARM AND 12' LUMINAIRE ARM	200	45 61 82 64 LRV82	3S12" 3S12" 3S12" 2S12"LB	SV-1-T SV-2-TC MAS SV-1	T T T T	BP	68	1S-COUNT	SP-1	MOUNT 45 @ 15' PPB
⑨	PPB POST										PPB

3

1/24/19

REVISED MOUNTINGS ON POLE 8 AFTER DAMAGE

JH

GD

2

3/21/17

INSTALLED PHASE 4 AND 8 LRV SIGNALS

RML

MV

1

9/2012

PER FIELD CHECK

GD

ET

0

4/15/09

SIGNAL UPGRADE ACTIVATED BY CT# 04-162514; CONVERTED FROM CP

GD

ET

NO.

DATE

DESCRIPTION

BY

APP.

TABLE OF REVISIONS

CHECK WITH TRACING TO SEE IF YOU HAVE LATEST REVISION

REFERENCE INFORMATION & FILE NO. OF SURVEYS

SIGNAL UPGRADE THROUGH CALTRANS 19TH AVE PHASE #1



SAN FRANCISCO MUNICIPAL TRANSPORTATION AGENCY

CITY AND COUNTY OF SAN FRANCISCO

DRAWN: GD

DATE: 9/5/2012

CHECKED: ET

DATE: 9/5/2012

SCALE:

AS SHOWN

SHEET OF SHEETS

1 OF 1

TRAFFIC SIGNAL INVENTORY DIAGRAM

19TH AVENUE AND JUDAH ST

CNN NO.

27366000

REV NO.

3