



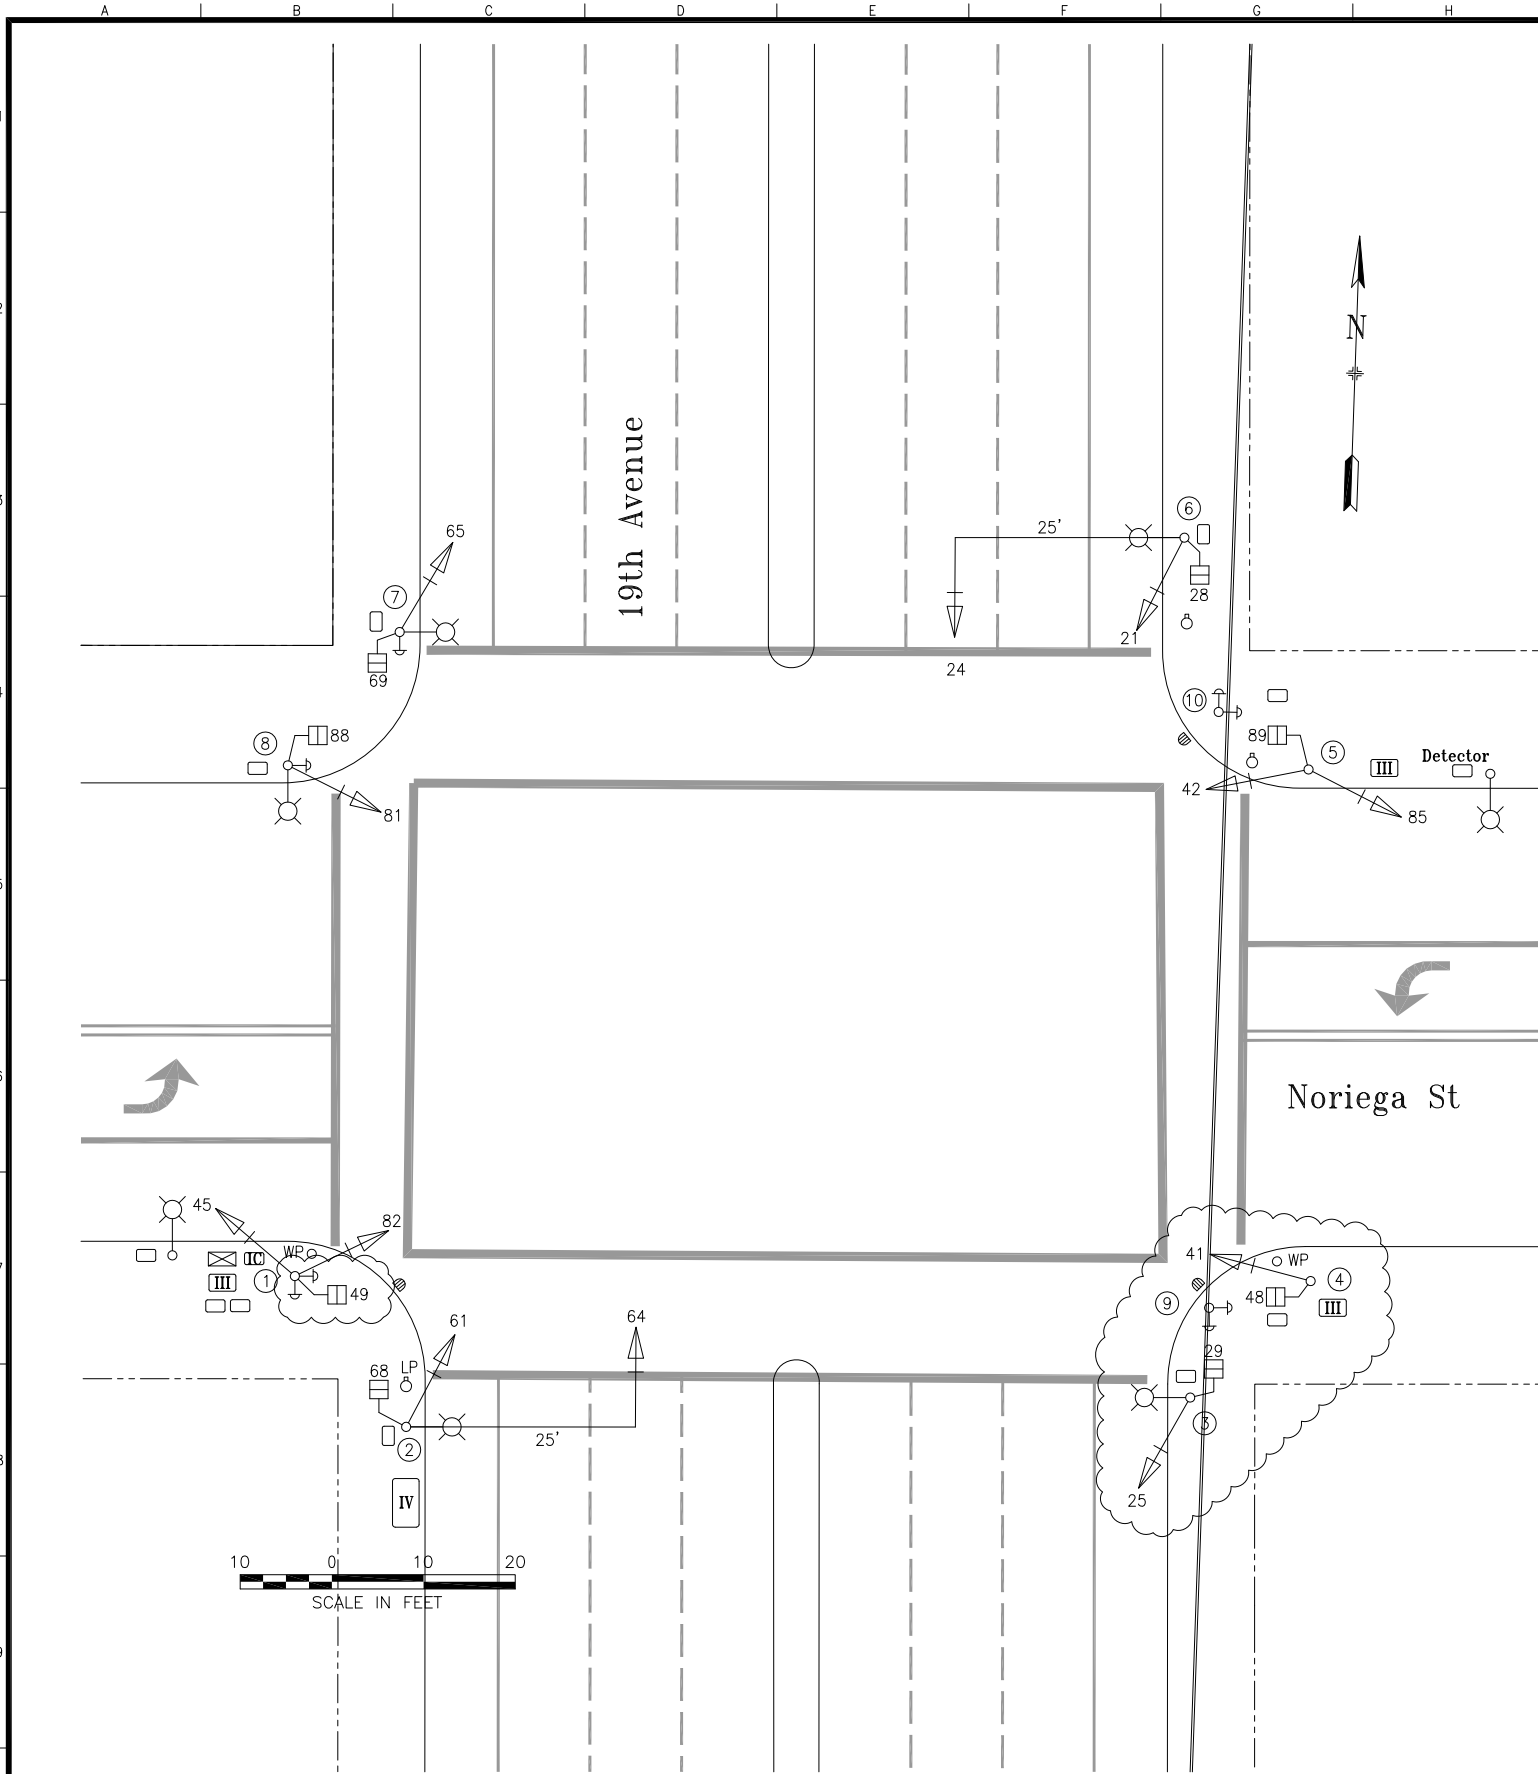

POLE AND EQUIPMENT SCHEDULE											
POLE No.	TYPE OF POLE	LUMINAIRE VOLTAGE/WATTAGE	VEHICLE SIGNAL					PEDESTRIAN SIGNAL			REMARKS
			No.	TYPE	MOUNTING	VISORS	LOUVERS/BP	No.	TYPE	MOUNTING	
①	1-A (10')		45 82	3S12" 3S12"	TV-2-T	T T	BP BP	49	1S-COUNT	SP-1-T	PPB (2)
②	19-4-100 WITH 25' MAST ARM AND 8' LUMINAIRE ARM	200	61 64	3S12" 3S12"	SV-1-T MAS	T T	BP BP	68	1S-COUNT	SP-1-T	
③	15TS WITH 8' LUMINAIRE ARM	200	25	3S12"	SV-1-T	T	BP	29	1S-COUNT	SP-1-T	
④	1-A (10')		41	3S12"	TV-1-T	T	BP	48	1S-COUNT	SP-1-T	
⑤	1-A (10')		42 85	3S12" 3S12"	TV-2-T	T T	BP BP	89	1S-COUNT	SP-1-T	
⑥	19-4-100 WITH 25' MAST ARM AND 8' LUMINAIRE ARM	200	21 24	3S12" 3S12"	SV-1-T MAS	T T	BP BP	28	1S-COUNT	SP-1-T	
⑦	15TS WITH 8' LUMINAIRE ARM	200	65	3S12"	SV-1-T	T	BP	69	1S-COUNT	SP-1-T	PPB
⑧	15TS WITH 8' LUMINAIRE ARM	200	81	3S12"	SV-1-T	T	BP	88	1S-COUNT	SP-1-T	PPB
⑨	PPB POST										PPB (2)
⑩	PPB POST										PPB (2)

PHASE DIAGRAM

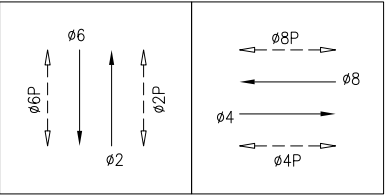

PHASE SEQUENCE

G	Y	R			19TH AVE (NB & SB) – 02 & 06
R		G		Y R	NORIEGA ST (EB & WB) – 04 & 08
WM	FRH	RH			PED XING NORIEGA ST (E/S & W/S) – 02P & 06P
RH		WM	FRH	RH	PED XING 19TH AVE (S/S & N/S) – 04P & 08P

1	9/2012	PER FIELD CHECK	GD	ET
0	3/12/2009	SIGNAL UPGRADE ACTIVATED THROUGH CONTRACT # 04-162514; CONVERTED FROM CONTRACT PLANS	GD	ET
NO.	DATE	DESCRIPTION	BY	APP.
TABLE OF REVISIONS CHECK WITH TRACING TO SEE IF YOU HAVE LATEST REVISION				

REFERENCE INFORMATION
& FILE NO. OF SURVEYS

SIGNAL UPGRADE
THROUGH CALTRANS
19TH AVE PHASE #1



SAN FRANCISCO MUNICIPAL TRANSPORTATION AGENCY
CITY AND COUNTY OF SAN FRANCISCO

DRAWN: DATE:
GD 9/5/2012

CHECKED: DATE:
ET 9/5/2012

SCALE:

AS SHOWN

SHEET OF SHEETS
1 OF 1

TRAFFIC SIGNAL INVENTORY DIAGRAM

19TH AVENUE AND NORIEGA ST

CNN NO.
27335000

REV NO.
1