



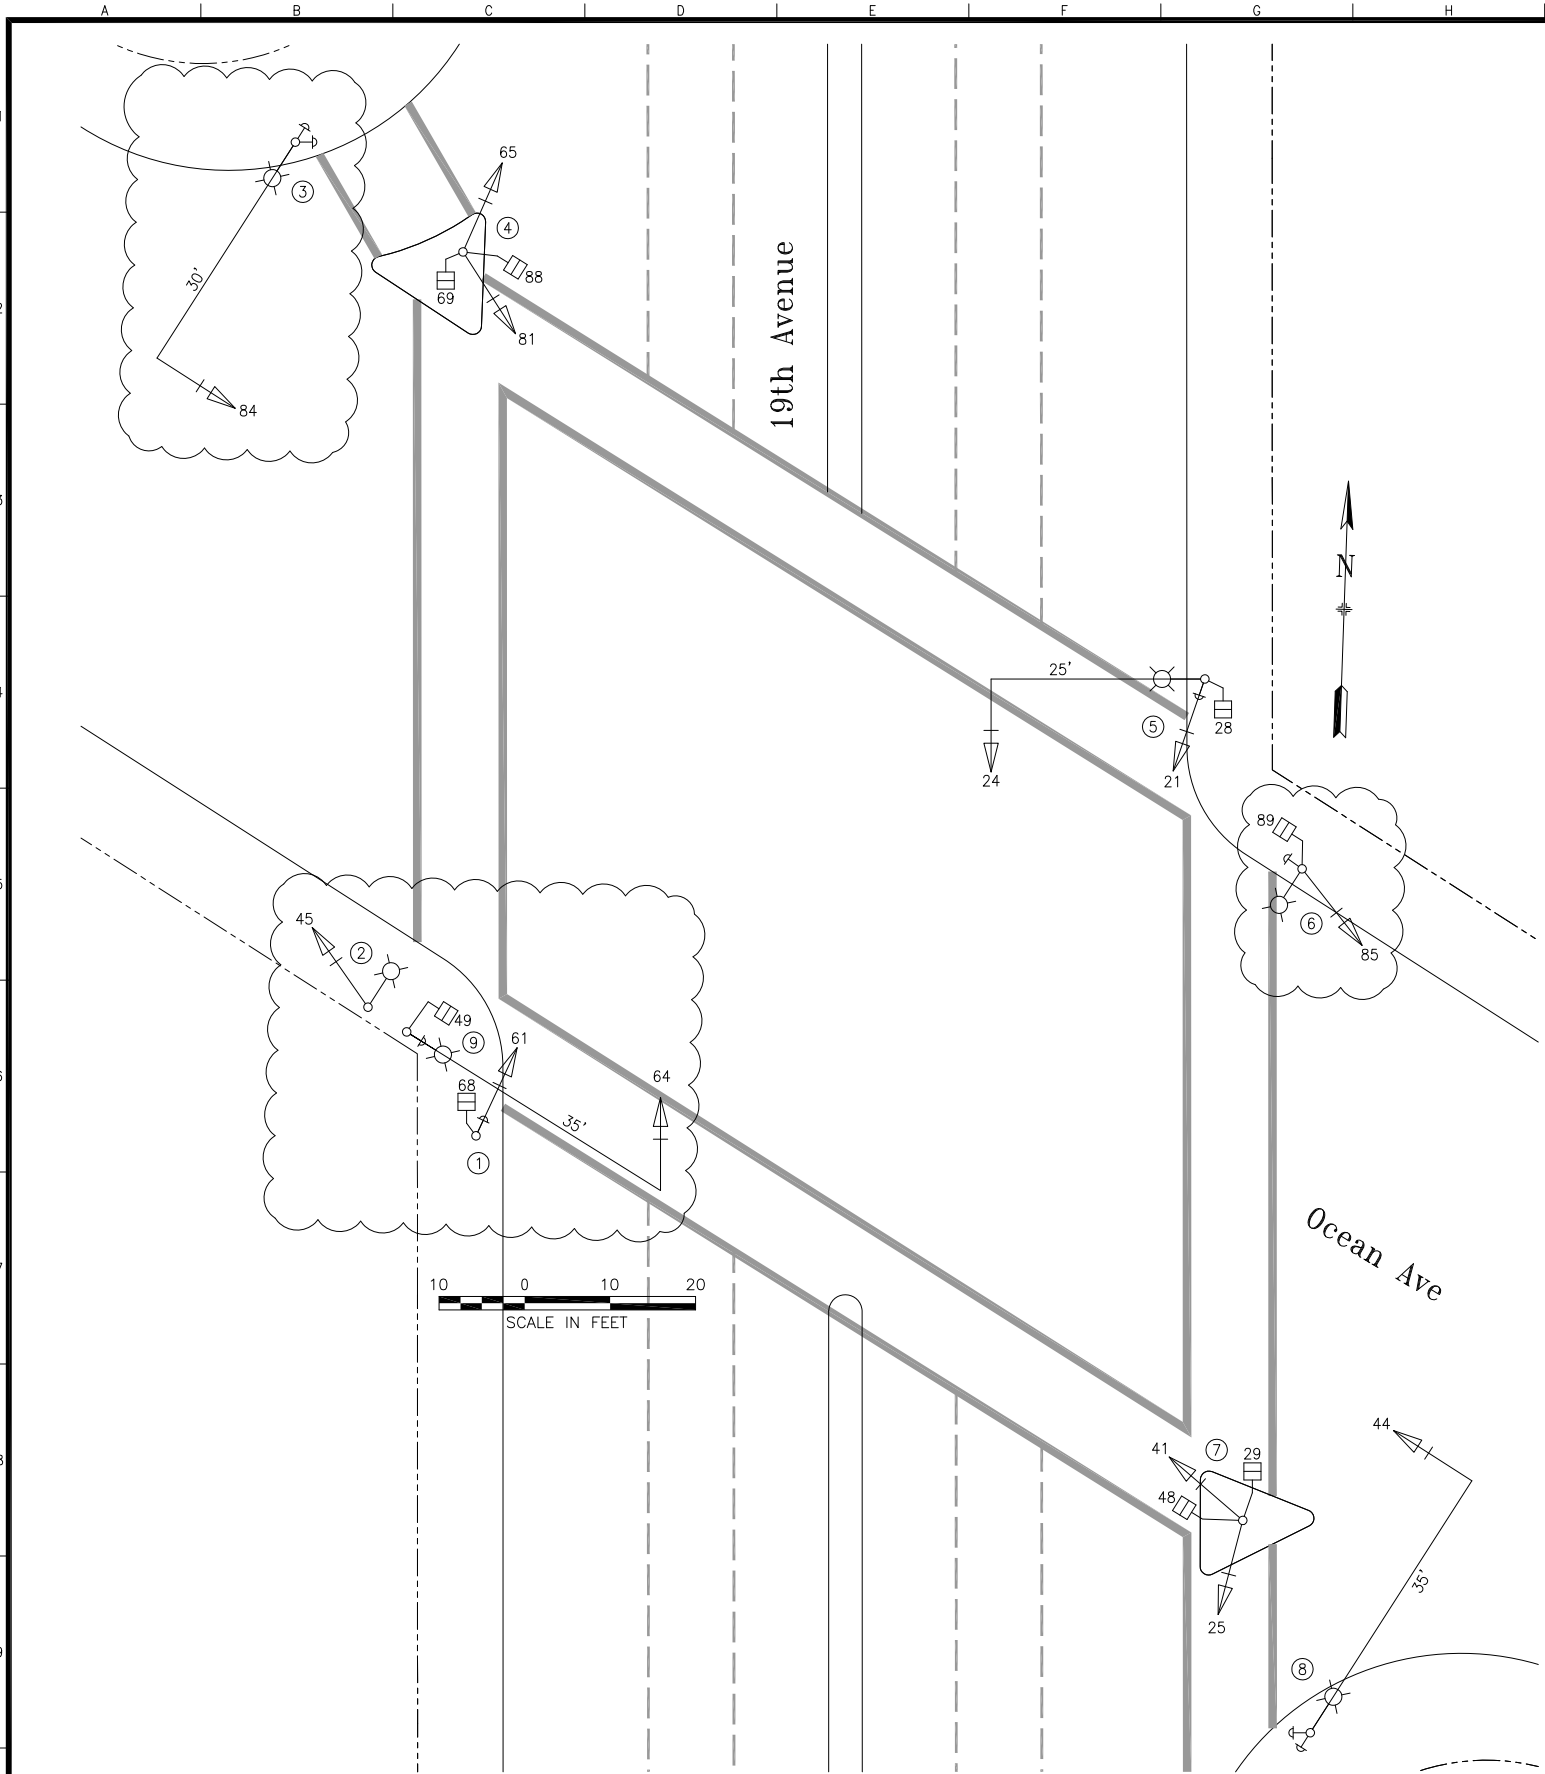

POLE AND EQUIPMENT SCHEDULE											
POLE No.	TYPE OF POLE	LUMINAIRE VOLTAGE/WATTAGE	VEHICLE SIGNAL					PEDESTRIAN SIGNAL			REMARKS
			No.	TYPE	MOUNTING	VISORS	LOUVERS/BP	No.	TYPE	MOUNTING	
①	1-A (10')		61	3S12"	TV-1-T	T	BP	68	1S-COUNT	SP-1-T	PPB
②	15TS WITH 8' LUMINAIRE ARM	200	45	3S12"	SV-1-T	T	BP				
③	19-2-100 WITH 30' MAST ARM AND 8' LUMINAIRE ARM	200	84	3S12"	MAS	T	BP				PPB (2)
④	1-A (10')		65 81	3S12" 3S12"	TV-2-T	T T	BP BP	69 88	1S-COUNT 1S-COUNT	SP-2-T	
⑤	19-2-100 WITH 25' MAST ARM AND 8' LUMINAIRE ARM	200	21 24	3S12" 3S12"	SV-1-T MAS	T T	BP BP	28	1S-COUNT	SP-1-T	PPB
⑥	15TS WITH 8' LUMINAIRE ARM	200	85	3S12"	SV-1-T	T	BP	89	1S-COUNT	SP-1-T	PPB
⑦	1-A (10')		25 41	3S12" 3S12"	TV-2-T	T T	BP BP	29 48	1S-COUNT 1S-COUNT	SP-2-T	
⑧	24-3-100 WITH 35' MAST ARM AND 8' LUMINAIRE ARM	200	44	3S12"	MAS	T	BP				PPB (2)
⑨	24-3-100 WITH 35' MAST ARM AND 8' LUMINAIRE ARM	200	64	3S12"	MAS	T	BP	49	1S-COUNT	SP-1-T	PPB

PHASE DIAGRAM

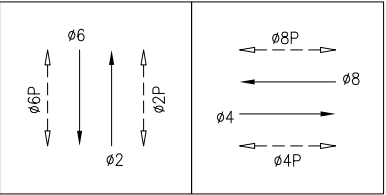

PHASE SEQUENCE

G	Y	R			19TH AVE (NB & SB) - 02 & 06
R		G		Y R	OCEAN AVE (EB & WB) - 04 & 08
WM	FRH	RH			PED XING OCEAN AVE (E/S & W/S) - 02P & 06P
RH		WM	FRH	RH	PED XING 19TH AVE (S/S & N/S) - 04P & 08P

NO.	DATE	DESCRIPTION	BY	APP.
1	9/2012	PER FIELD CHECK	GD	ET
0	8/6/2009	SIGNAL UPGRADE ACTIVATED THROUGH CONTRACT # 04-162524; CONVERTED FROM CONTRACT PLANS	GD	ET
TABLE OF REVISIONS CHECK WITH TRACING TO SEE IF YOU HAVE LATEST REVISION				

REFERENCE INFORMATION
& FILE NO. OF SURVEYS

SIGNAL UPGRADE
THROUGH CALTRANS
19TH AVE PHASE #2



SAN FRANCISCO MUNICIPAL TRANSPORTATION AGENCY
CITY AND COUNTY OF SAN FRANCISCO

DRAWN: DATE:
GD 10/23/2012
CHECKED: DATE:
ET 10/23/2012

SCALE:
AS SHOWN
SHEET OF SHEETS
1 OF 1

TRAFFIC SIGNAL INVENTORY DIAGRAM

19TH AVENUE AND OCEAN AVE

CNN NO.
23079000
REV NO.
1