



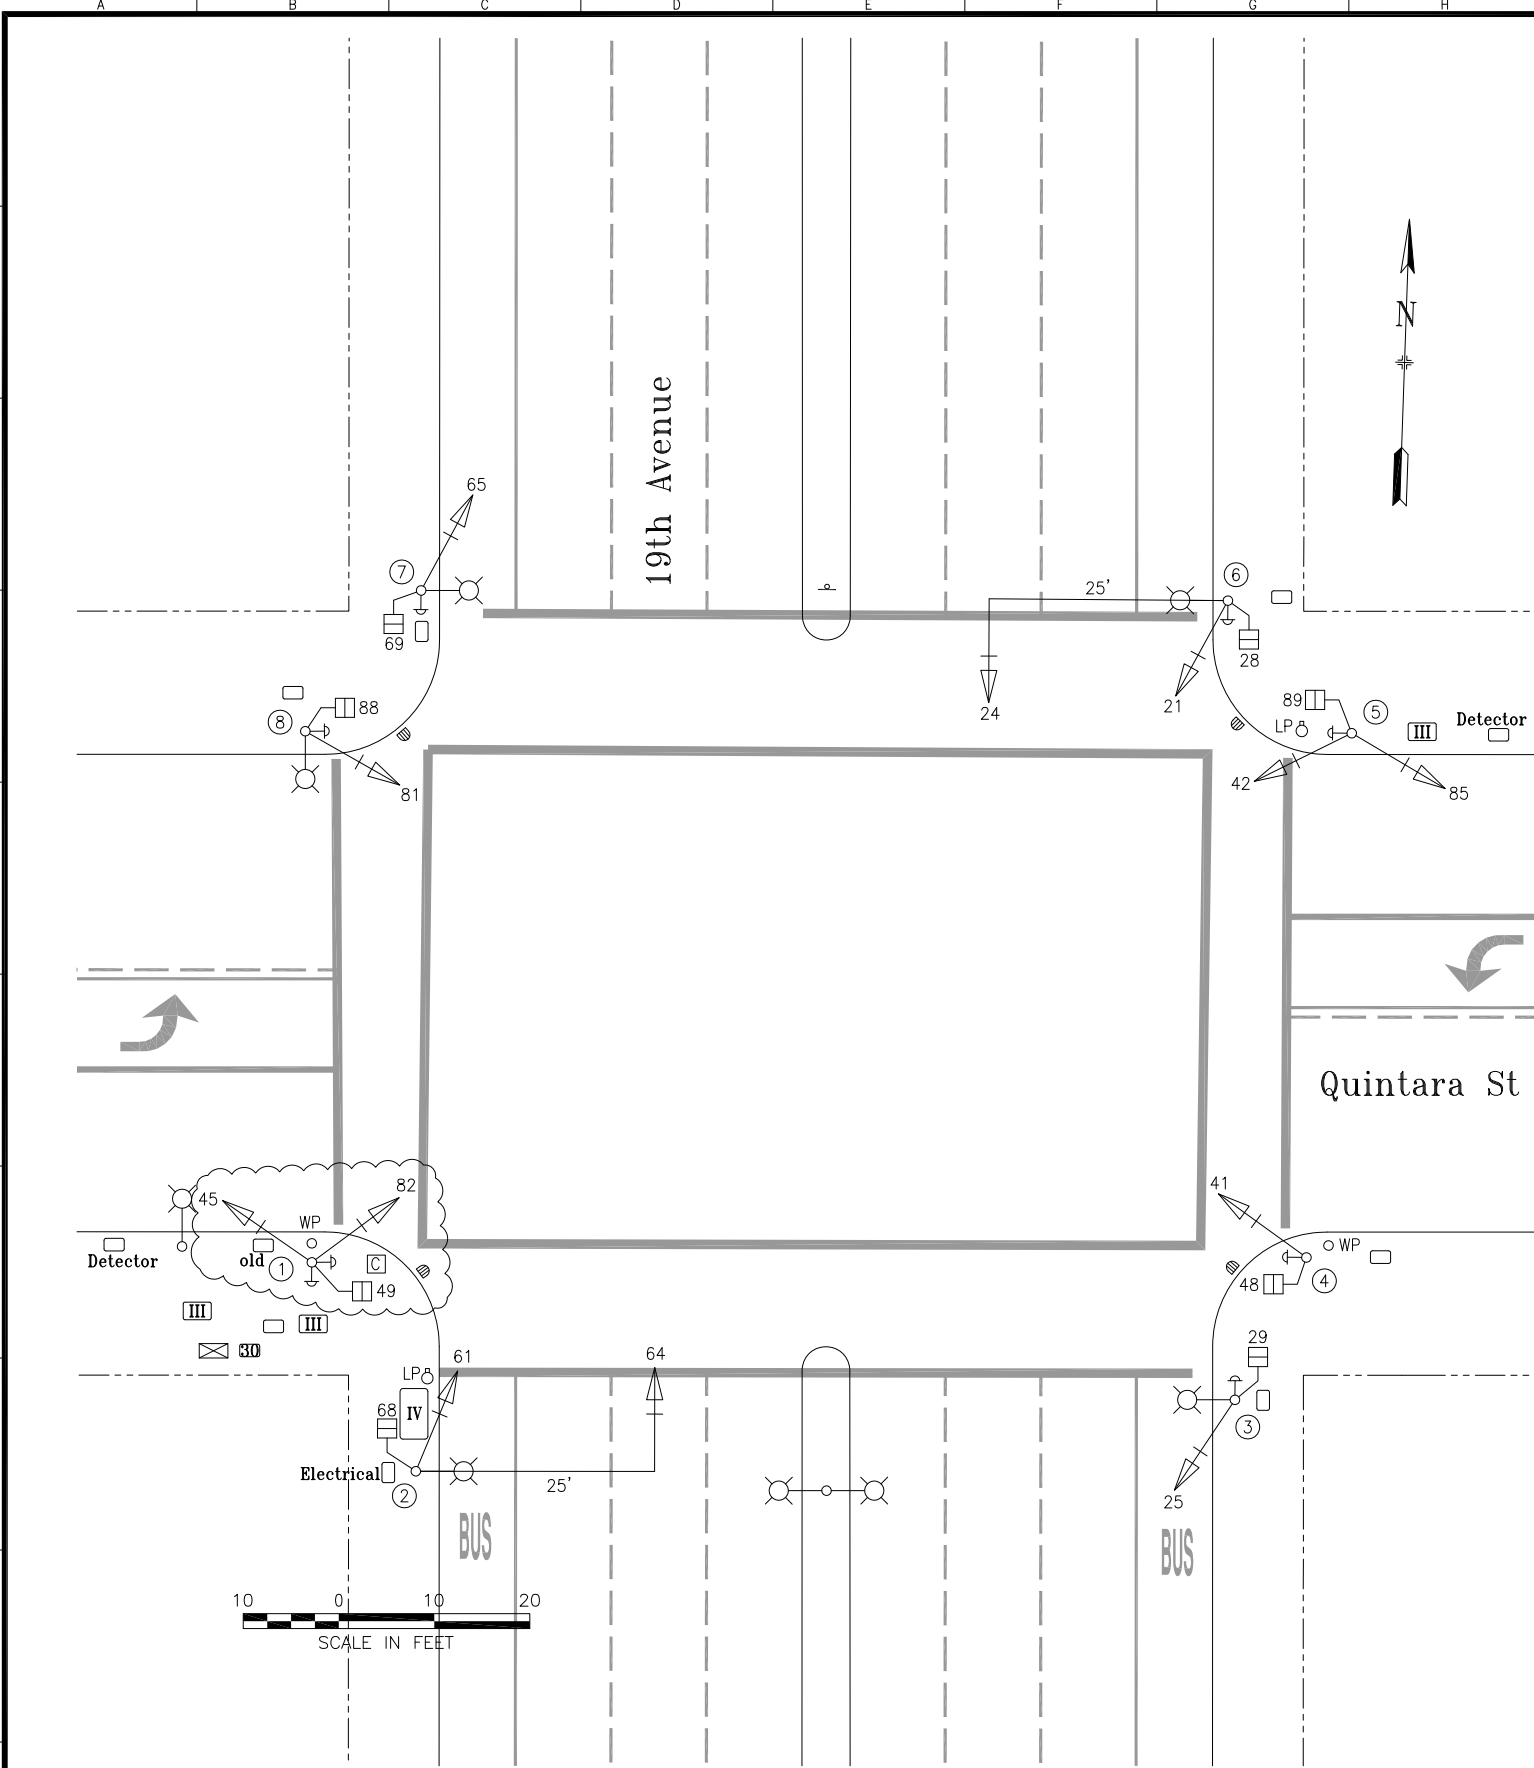

POLE AND EQUIPMENT SCHEDULE											
POLE No.	TYPE OF POLE	LUMINAIRE VOLTAGE/WATTAGE	VEHICLE SIGNAL					PEDESTRIAN SIGNAL			REMARKS
			No.	TYPE	MOUNTING	VISORS	LOUVERS/BP	No.	TYPE	MOUNTING	
①	1-A (10')		45 82	3S12" 3S12"	TV-2-T	T T	BP BP	49	1S-COUNT	SP-1-T	PPB (2)
②	19-2-100 WITH 25' MAST ARM AND 8' LUMINAIRE ARM	200	61 64	3S12" 3S12"	SV-1-T MAS	T T	BP BP	68	1S-COUNT	SP-1-T	
③	15TS WITH 8' LUMINAIRE ARM	200	25	3S12"	SV-1-T	T	BP	29	1S-COUNT	SP-1-T	PPB
④	1-A (10')		41	3S12"	TV-1-T	T	BP	48	1S-COUNT	SP-1-T	PPB
⑤	1-A (10')		42 85	3S12" 3S12"	TV-2-T	T T	BP BP	89	1S-COUNT	SP-1-T	PPB
⑥	19-2-100 WITH 25' MAST ARM AND 8' LUMINAIRE ARM	200	21 24	3S12" 3S12"	SV-1-T MAS	T T	BP BP	28	1S-COUNT	SP-1-T	PPB
⑦	15TS WITH 8' LUMINAIRE ARM	200	65	3S12"	SV-1-T	T	BP	69	1S-COUNT	SP-1-T	PPB
⑧	15TS WITH 8' LUMINAIRE ARM	200	81	3S12"	SV-1-T	T	BP	88	1S-COUNT	SP-1-T	PPB

PHASE DIAGRAM

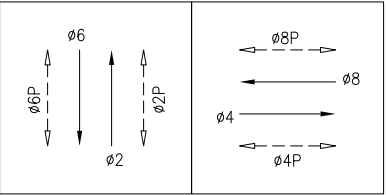

PHASE SEQUENCE

G	Y	R	19TH AVE (NB & SB) - ø2 & ø6		
R		G	Y	R	QUINTARA ST (EB & WB) - ø4 & ø8
WM	FRH	RH			PED XING QUINTARA ST (E/S & W/S) - ø2P & ø6P
RH		WM	FRH	RH	PED XING 19TH AVE (S/S & N/S) - ø4P & ø8P

1	9/2012	PER FIELD CHECK	GD	ET
0	2/25/2009	SIGNAL UPGRADE ACTIVATED THROUGH CONTRACT # 04-162514; CONVERTED FROM CONTRACT PLANS	GD	ET
NO.	DATE	DESCRIPTION	BY	APP.

TABLE OF REVISIONS
CHECK WITH TRACING TO SEE IF YOU HAVE LATEST REVISION

REFERENCE INFORMATION & FILE NO. OF SURVEYS

SIGNAL UPGRADE THROUGH CALTRANS 19TH AVE PHASE #1

SAN FRANCISCO MUNICIPAL TRANSPORTATION AGENCY
CITY AND COUNTY OF SAN FRANCISCO

DRAWN:	DATE:
GD	9/5/2012
CHECKED:	DATE:
ET	9/5/2012

SCALE:

AS SHOWN

SHEET OF SHEETS

1 OF 1

TRAFFIC SIGNAL INVENTORY DIAGRAM

19TH AVENUE AND QUINTARA ST

CNN NO.

23204000

REV NO.

1