



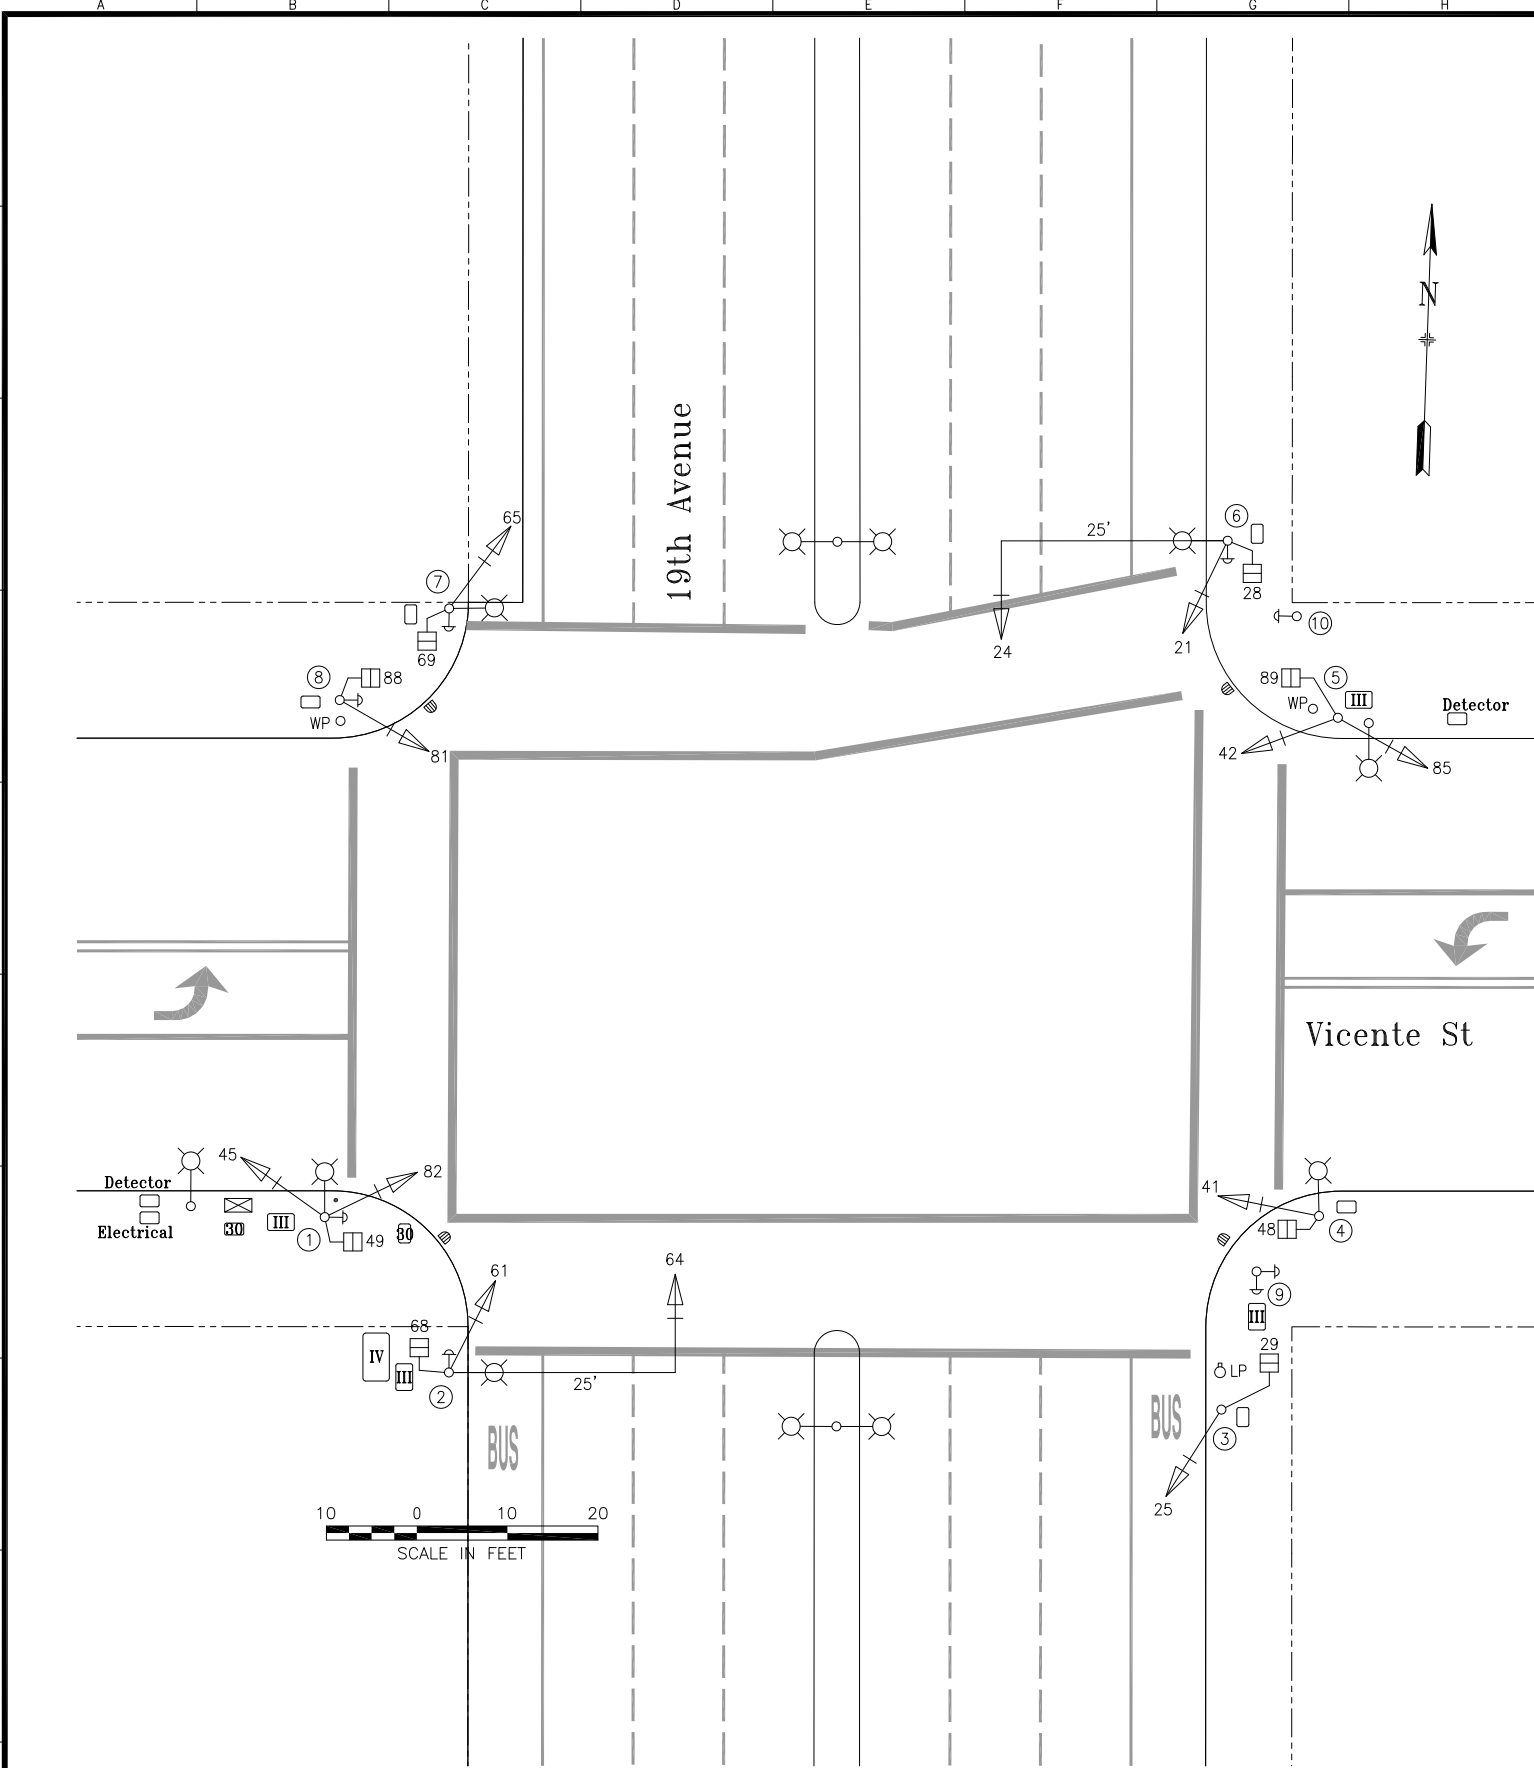

POLE AND EQUIPMENT SCHEDULE											
POLE No.	TYPE OF POLE	LUMINAIRE VOLTAGE/WATTAGE	VEHICLE SIGNAL					PEDESTRIAN SIGNAL			REMARKS
			No.	TYPE	MOUNTING	VISORS	LOUVERS/BP	No.	TYPE	MOUNTING	
①	15TS WITH 8' LUMINAIRE ARM	200	45 82	3S12" 3S12"	SV-2-T	T T	BP BP	49	1S-COUNT	SP-1-T	PPB
②	19-2-100 WITH 25' MAST ARM AND 8' LUMINAIRE ARM	200	61 64	3S12" 3S12"	SV-1-T MAS	T T	BP BP	68	1S-COUNT	SP-1-T	PPB
③	1-A (10')		25	3S12"	TV-1-T	T	BP	29	1S-COUNT	SP-1-T	
④	15TS WITH 8' LUMINAIRE ARM	200	41	3S12"	SV-1-T	T	BP	48	1S-COUNT	SP-1-T	
⑤	1-A (10')	200	42 85	3S12" 3S12"	TV-2-T	T T	BP BP	89	1S-COUNT	SP-1-T	
⑥	19-2-100 WITH 25' MAST ARM AND 8' LUMINAIRE ARM	200	21 24	3S12" 3S12"	SV-1-T MAS	T T	BP BP	28	1S-COUNT	SP-1-T	PPB
⑦	15TS WITH 8' LUMINAIRE ARM	200	65	3S12"	SV-1-T	T	BP	69	1S-COUNT	SP-1-T	PPB
⑧	1-A (10')		81	3S12"	TV-1-T	T	BP	88	1S-COUNT	SP-1-T	PPB
⑨	PPB POST										PPB (2)
⑩	PPB POST										PPB

PHASE DIAGRAM

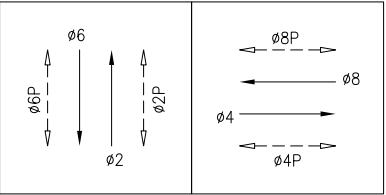

PHASE SEQUENCE

G	Y	R	19TH AVE (NB & SB) - ø2 & ø6		
R		G	Y	R	VICENTE ST (EB & WB) - ø4 & ø8
WM	FRH	RH			PED XING VICENTE ST (E/S & W/S) - ø2P & ø6P
RH		WM	FRH	RH	PED XING 19TH AVE (S/S & N/S) - ø4P & ø8P

1	9/2012	PER FIELD CHECK	GD	ET
0	12/4/2008	SIGNAL UPGRADE ACTIVATED THROUGH CONTRACT # 04-162514; CONVERTED FROM CONTRACT PLANS	GD	ET
NO.	DATE	DESCRIPTION	BY	APP.
TABLE OF REVISIONS CHECK WITH TRACING TO SEE IF YOU HAVE LATEST REVISION				

REFERENCE INFORMATION & FILE NO. OF SURVEYS	SIGNAL UPGRADE THROUGH CALTRANS 19TH AVE PHASE #1
---	---

SAN FRANCISCO MUNICIPAL TRANSPORTATION AGENCY
CITY AND COUNTY OF SAN FRANCISCO

DRAWN: GD	DATE: 9/5/2012
CHECKED: ET	DATE: 9/5/2012

SCALE:	AS SHOWN
SHEET OF SHEETS	1 OF 1

TRAFFIC SIGNAL INVENTORY DIAGRAM	CNN NO. 23159000
19TH AVENUE AND VICENTE ST	REV NO. 1