



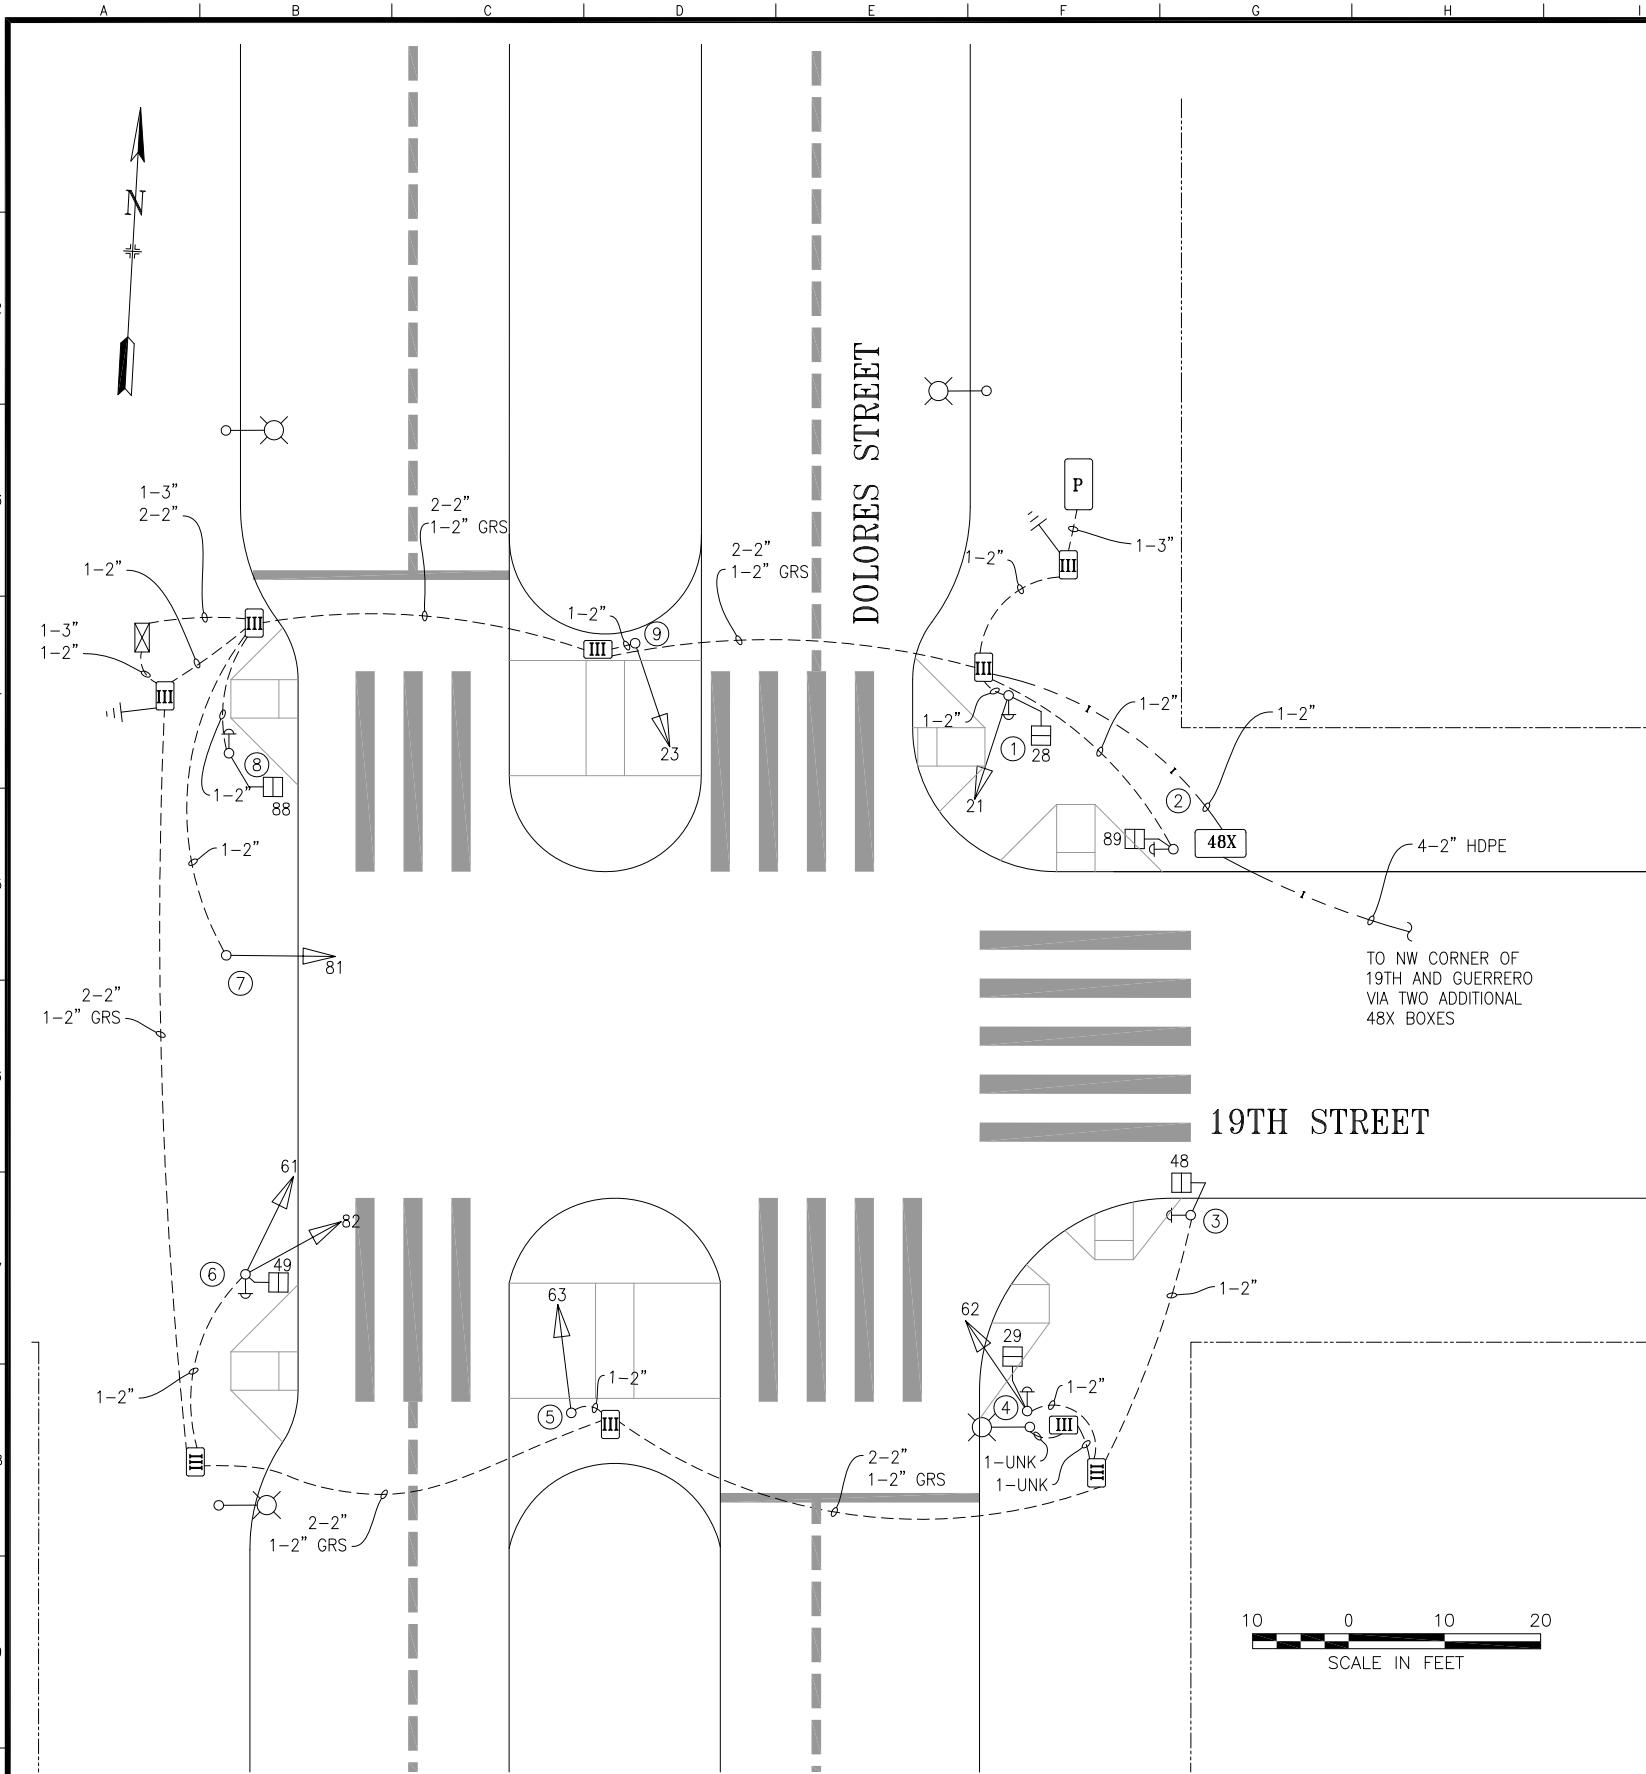

POLE AND EQUIPMENT SCHEDULE										
POLE No.	TYPE OF POLE	LUMINAIRE VOLTAGE/WATTAGE	VEHICLE SIGNAL					PEDESTRIAN SIGNAL		
			No.	TYPE	MOUNTING	VISORS	LOUVERS	No.	TYPE	MOUNTING
①	1-A (10')		21	3S12"	TV-1-T	T		28	1S-COUNT	SP-1
②	1-A (7')							89	1S-COUNT	TP-1
③	1-A (7')							48	1S-COUNT	TP-1
④	1-A (10')		62	3S12"	TV-1-T	T		29	1S-COUNT	SP-1
⑤	1-A (10')		63	3S12"	TV-1-T	T				
⑥	1-A (10')		61 82	3S12" 3S12"	TV-2-T-SFA	T T		49	1S-COUNT	SP-1
⑦	1-A (10')		81	3S12"	TV-1-T	T				
⑧	1-A (7')							88	1S-COUNT	TP-1
⑨	1-A (10')		23	3S12"	TV-1-T	T				

INTERCONNECT WIRING DETAIL
NOT TO SCALE

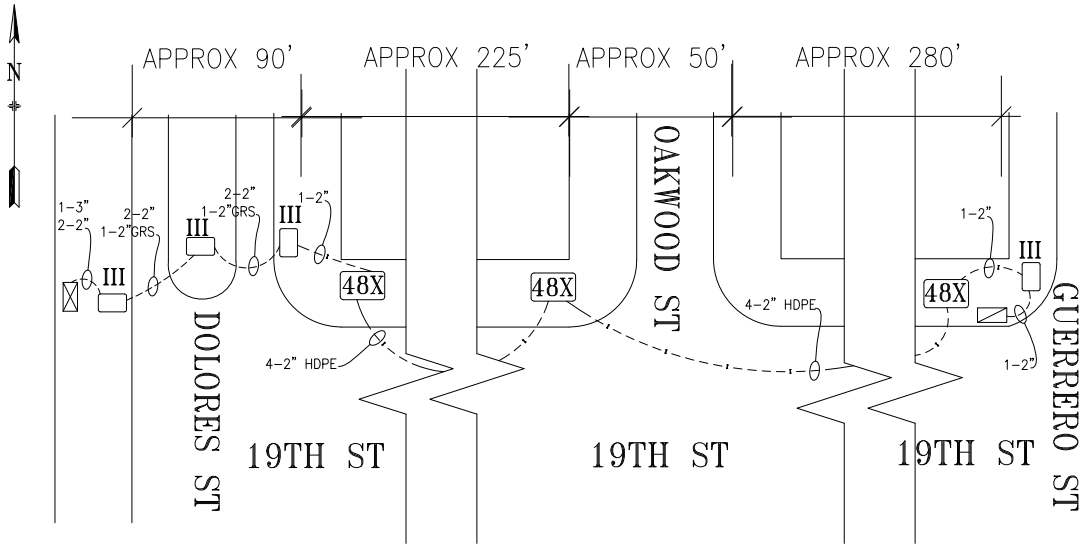

0	9/1/17	NEW SIGNAL ACTIVATED THROUGH #2772J					AScales	GDeLeon	
NO.	DATE	DESCRIPTION					BY	APP.	
TABLE OF REVISIONS									
CHECK WITH TRACING TO SEE IF YOU HAVE LATEST REVISION									

REFERENCE INFORMATION
& FILE NO. OF SURVEYS



SAN FRANCISCO MUNICIPAL TRANSPORTATION AGENCY
CITY AND COUNTY OF SAN FRANCISCO

DRAWN: DATE:
AScales 06/19/18
CHECKED: DATE:
GDeLeon 08/15/18

SCALE:

AS SHOWN

SHEET OF SHEETS

1 OF 1

TRAFFIC SIGNAL INVENTORY DIAGRAM

19TH STREET AND DOLORES STREET

CNN NO.

25683000

REV NO.

0