
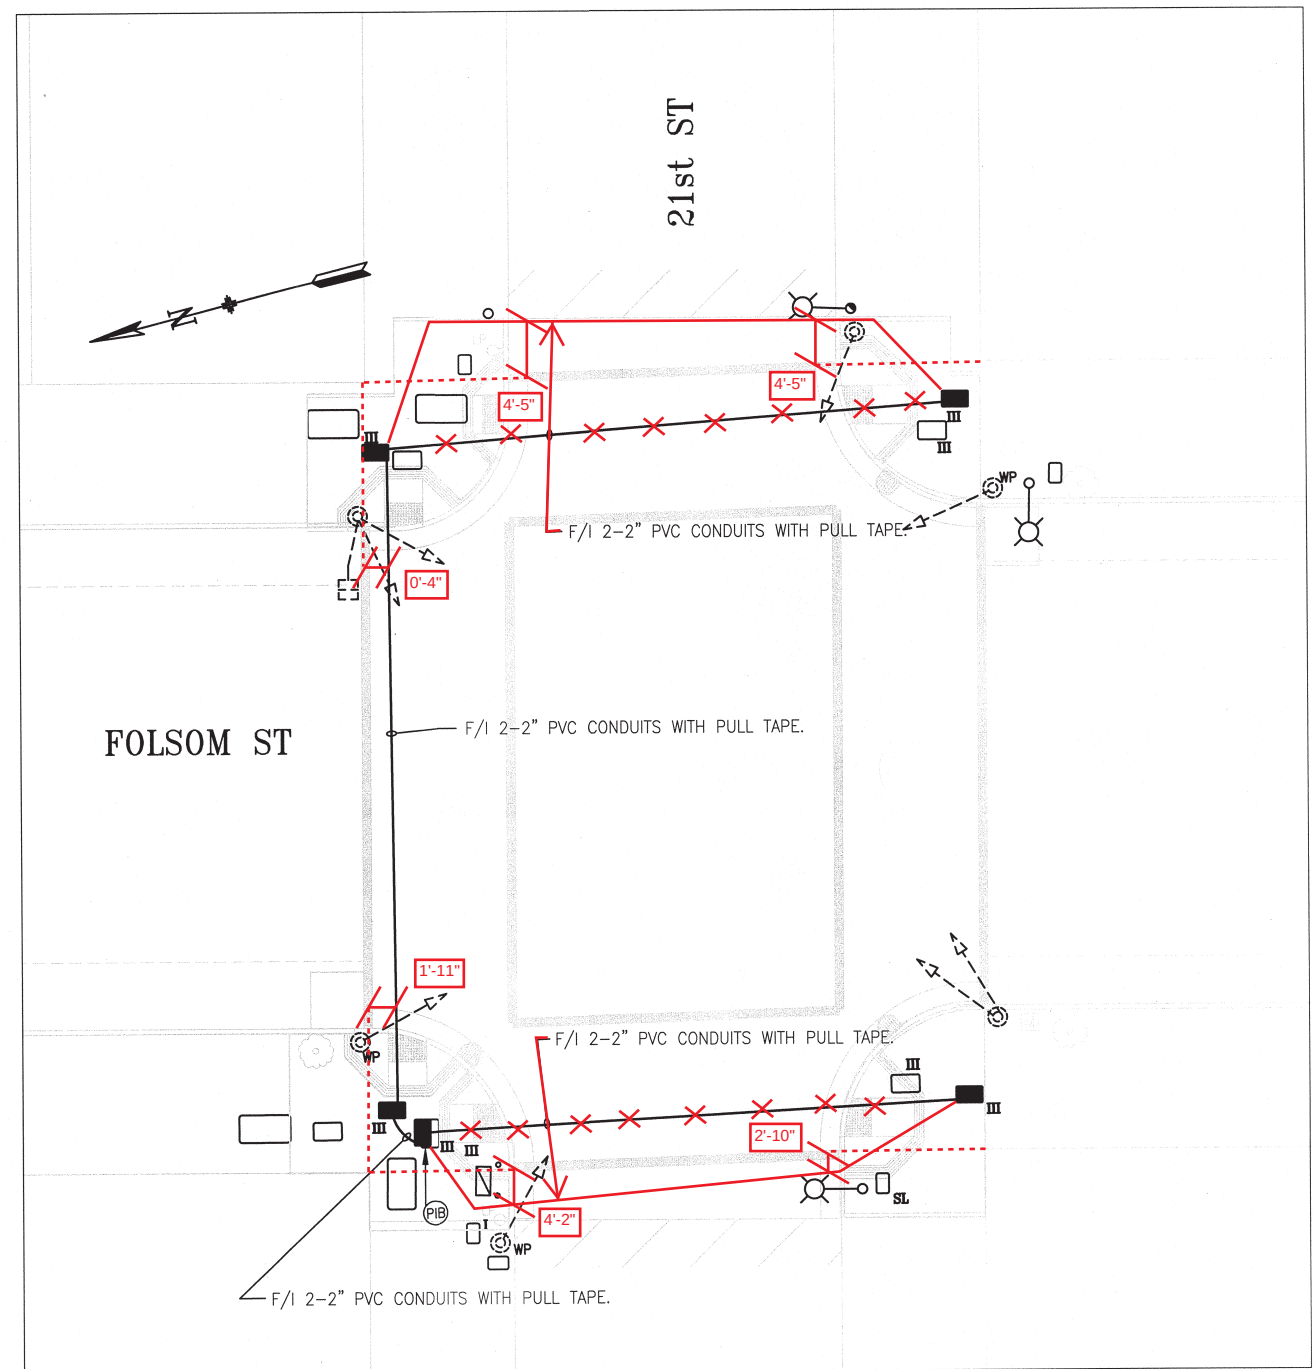


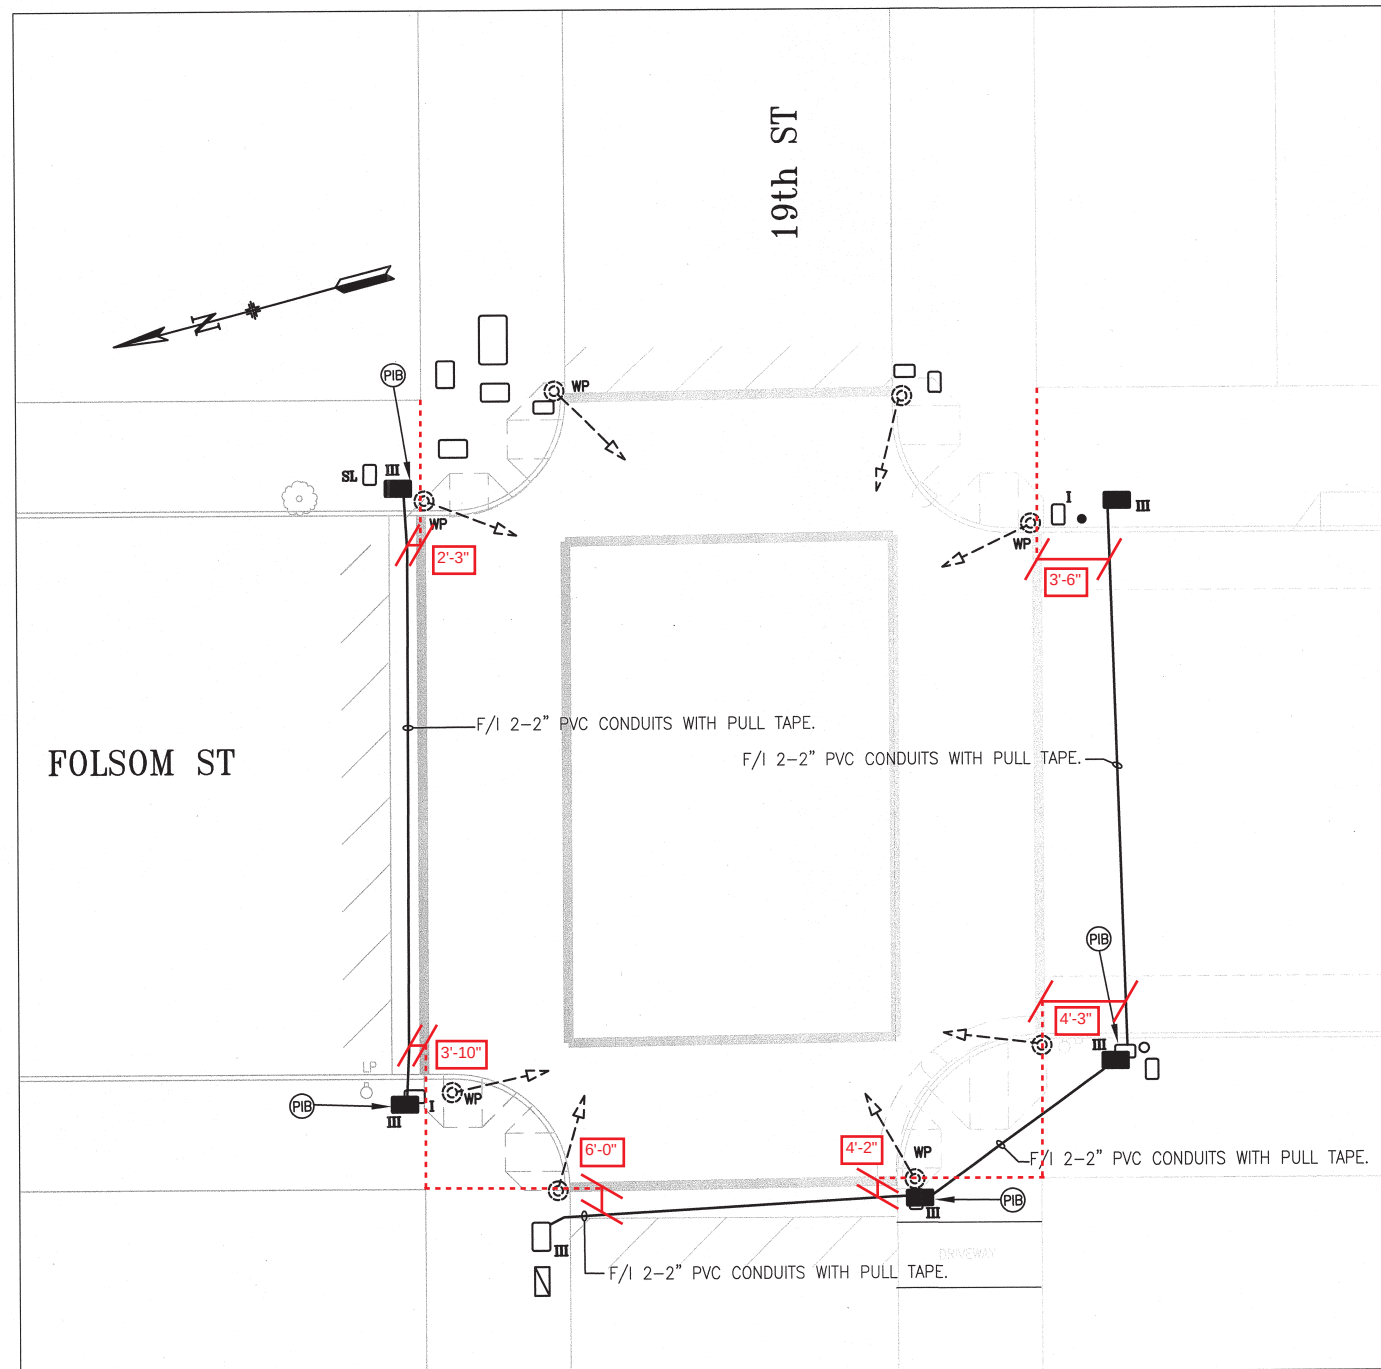


AS-BUILT
DATE: 9/30/13
BY: MIKE WONG
PHOENIX ELECTRIC
1350 VAN DYKE AVENUE
SAN FRANCISCO, CA 94124

BASE BID

NO.	DATE	DESCRIPTION	BY	APP.
TABLE OF REVISIONS				
CHECK WITH TRACING TO SEE IF YOU HAVE LATEST REVISION				

REFERENCE INFORMATION
& FILE NO. OF SURVEYS

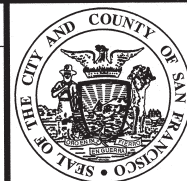

BUREAU OF ENGINEERING
DEPARTMENT OF PUBLIC WORKS
CITY AND COUNTY OF SAN FRANCISCO



DESIGNED KK	DATE 7/12	APPROVED [Signature]	DATE 9/19/12
DRAWN KK	DATE 7/12	SECTION MANAGER [Signature]	DATE 7/12/12
CHECKED SL	DATE 7/12	DEPUTY BUREAU MANAGER [Signature]	DATE 7/12/12
		BUREAU MANAGER [Signature]	DATE 7/12/12

SCALE 1"=20'
SHEET OF SHEETS 53 of 67

FOLSOM STREETSCAPE IMPROVEMENTS PROJECT
FOLSOM STREET 19TH STREET AND 21ST STREET INTERSECTIONS TRAFFIC SIGNAL WORK

CONTRACT NO. 1677J
DRAWING NO. E-1.0
FILE NO. 91598
REV. NO. 0