


POLE AND EQUIPMENT SCHEDULE											
POLE No.	TYPE OF POLE	LUMINAIRE VOLTAGE/ WATTAGE	VEHICLE SIGNAL					PEDESTRIAN SIGNAL			REMARKS
			No.	TYPE	MOUNTING	VISORS	LOUVERS	No.	TYPE	MOUNTING	
①	1-A (10')		61	3S12"	TV-1-T	T		68	1S-COUNT	SP-1	
②	CITY STANDARD STREET LIGHT	73W LED	82	3S12"	SV-1-T	T		49	1S-COUNT	SP-1	
③	1-A (10')		81	3S12"	TV-1-T	T		88	1S-COUNT	SP-1	
④	CITY STANDARD STREET LIGHT	73W LED	22 65	3S12" 3S12"	SV-2-TA	T T		69	1S-COUNT	SP-1	
⑤	17-2-100 W/ 8' MAST ARM AND 6' LUMINAIRE	73W LED	21 24	3S12" 3S12"	SV-1-T MAS	T T		28	1S-COUNT	SP-1	BACKPLATE
⑥	1-A (10')		42	3S12"	TV-1-T	T		89	1S-COUNT	SP-1	
⑦	CITY STANDARD STREET LIGHT	73W LED	41	3S12"	SV-1-T	T		48	1S-COUNT	SP-1	
⑧	1-A (10')		62	3S12"	TV-1-T	T		29	1S-COUNT	SP-1	

- SHEET NOTES:**
- ① CONTRACTOR SHALL CONTACT CARLA SHORT OF DPW BUREAU OF URBAN FORESTRY (415-554-5349) AND TRIM TREE UNDER HER DIRECTION.
 - ② CONTRACTOR SHALL NOT DAMAGE SURVEY MONUMENT.
 - ③ SPLICE NEW 12C INTERCONNECT CABLE TO EXISTING 12C INTERCONNECT CABLE.
 - ④ MAST ARM PLUMBIZER SHALL BE MOUNTED BETWEEN YELLOW AND GREEN SIGNAL HEAD
 - ⑤ R/C EX TRAFFIC SIGNAL EXTERNAL CONDUIT AT LEAST 1 FOOT BELOW GRADE
 - ⑥ PROVIDE 3" CONDUIT AND RISER PER PG&E GREEN BOOK REQUIREMENT. COORDINATE WITH PG&E THROUGH SFPUC FOR SERVICE CONNECTION.
 - ⑦ PRIOR TO ABANDONING CONDUIT AND WIRES IN PLACE. CONTRACTOR TO FIELD VERIFY ALL EXISTING CIRCUIT TO REMAIN. UNUSED WIRES SHALL BE CUT TO THE FACE OF PULLBOX.

PHASE DIAGRAM

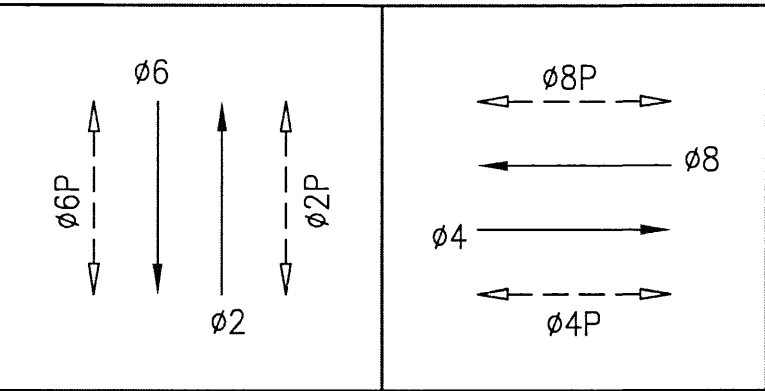

PHASE SEQUENCE

G	Y	R		SOUTH VAN NESS AVENUE (NB + SB) - 02 + 06
R		G	Y R	19TH STREET (EB + WB) - 04 + 08
WM	FRH		RH	PED XING 19TH STREET (ES + WS) - 02P + 06P
	RH	WM	FRH RH	PED XING SOUTH VAN NESS AVE (SS + NS) - 04P + 08P

SWITCHOVER 11/21/2017
DARK: 9:06 AM
3-COLOR: 9:45 AM
MIKE CHUE, RICHARD HO (SIGNAL SHOP)
SENTING KUANG (PEL)
DAN BRUGMANN (PW)
NIKKI KOBAYASHI (MTA)

NOTE:
THIS AUTOCAD DRAWING HAS BEEN REVISED AND REPLOTTED SUBSEQUENT TO INTERNAL ENGINEERING APPROVAL AND SIGN-OFF. FOR THOSE SIGNATURES, SEE THE DRAWING PLOTTED AND ISSUED PREVIOUSLY DURING BIDDING. THE SIGNED DRAWING REMAINS VALID EXCEPT FOR THE CHANGES ONLY AS CLEARLY MARKED ON THIS DRAWING AND ISSUED UNDER THIS LATEST REVISION NUMBER AS SHOWN IN THE TABLE OF REVISIONS LOCATED AT THE LOWER LEFT CORNER OF THE DRAWING. ALL ISSUED REVISIONS SUBSEQUENT TO PREVIOUSLY PLOTTED DRAWING DURING BIDDING REMAIN VALID UNLESS SUPERSEDED BY LATER ISSUED REVISIONS. CHECK ALL ISSUED REVISIONS OF THIS DRAWING.

NO.	DATE	DESCRIPTION	BY	APP.
4/10		PG&E SERVICE AND MISC POLE LAYOUT CHANGES	DG	SL
TABLE OF REVISIONS				

REFERENCE INFORMATION
& FILE NO. OF SURVEYS



INFRASTRUCTURE DIVISION
DEPARTMENT OF PUBLIC WORKS
CITY AND COUNTY OF SAN FRANCISCO



DESIGNED: DATE: **SS/DY/ZH 8/2015**
DRAWN: DATE: **SS/DY/ZH 8/2015**
CHECKED: DATE: **MV/SL**

APPROVED
SECTION MANAGER DATE:
DEPUTY DIVISION MANAGER DATE:
DIVISION MANAGER DATE:

SCALE:
AS SHOWN
SHEET OF SHEETS
19 OF 22

SOUTH VAN NESS AVE TRAFFIC SIGNAL UPGRADE
19TH STREET AND SOUTH VAN NESS AVENUE
TRAFFIC SIGNAL MODIFICATIONS

CONTRACT NO. **2569J**
DRAWING NO. **E-6.0**
FILE NO. **105,276**
REV. NO. **1**

