


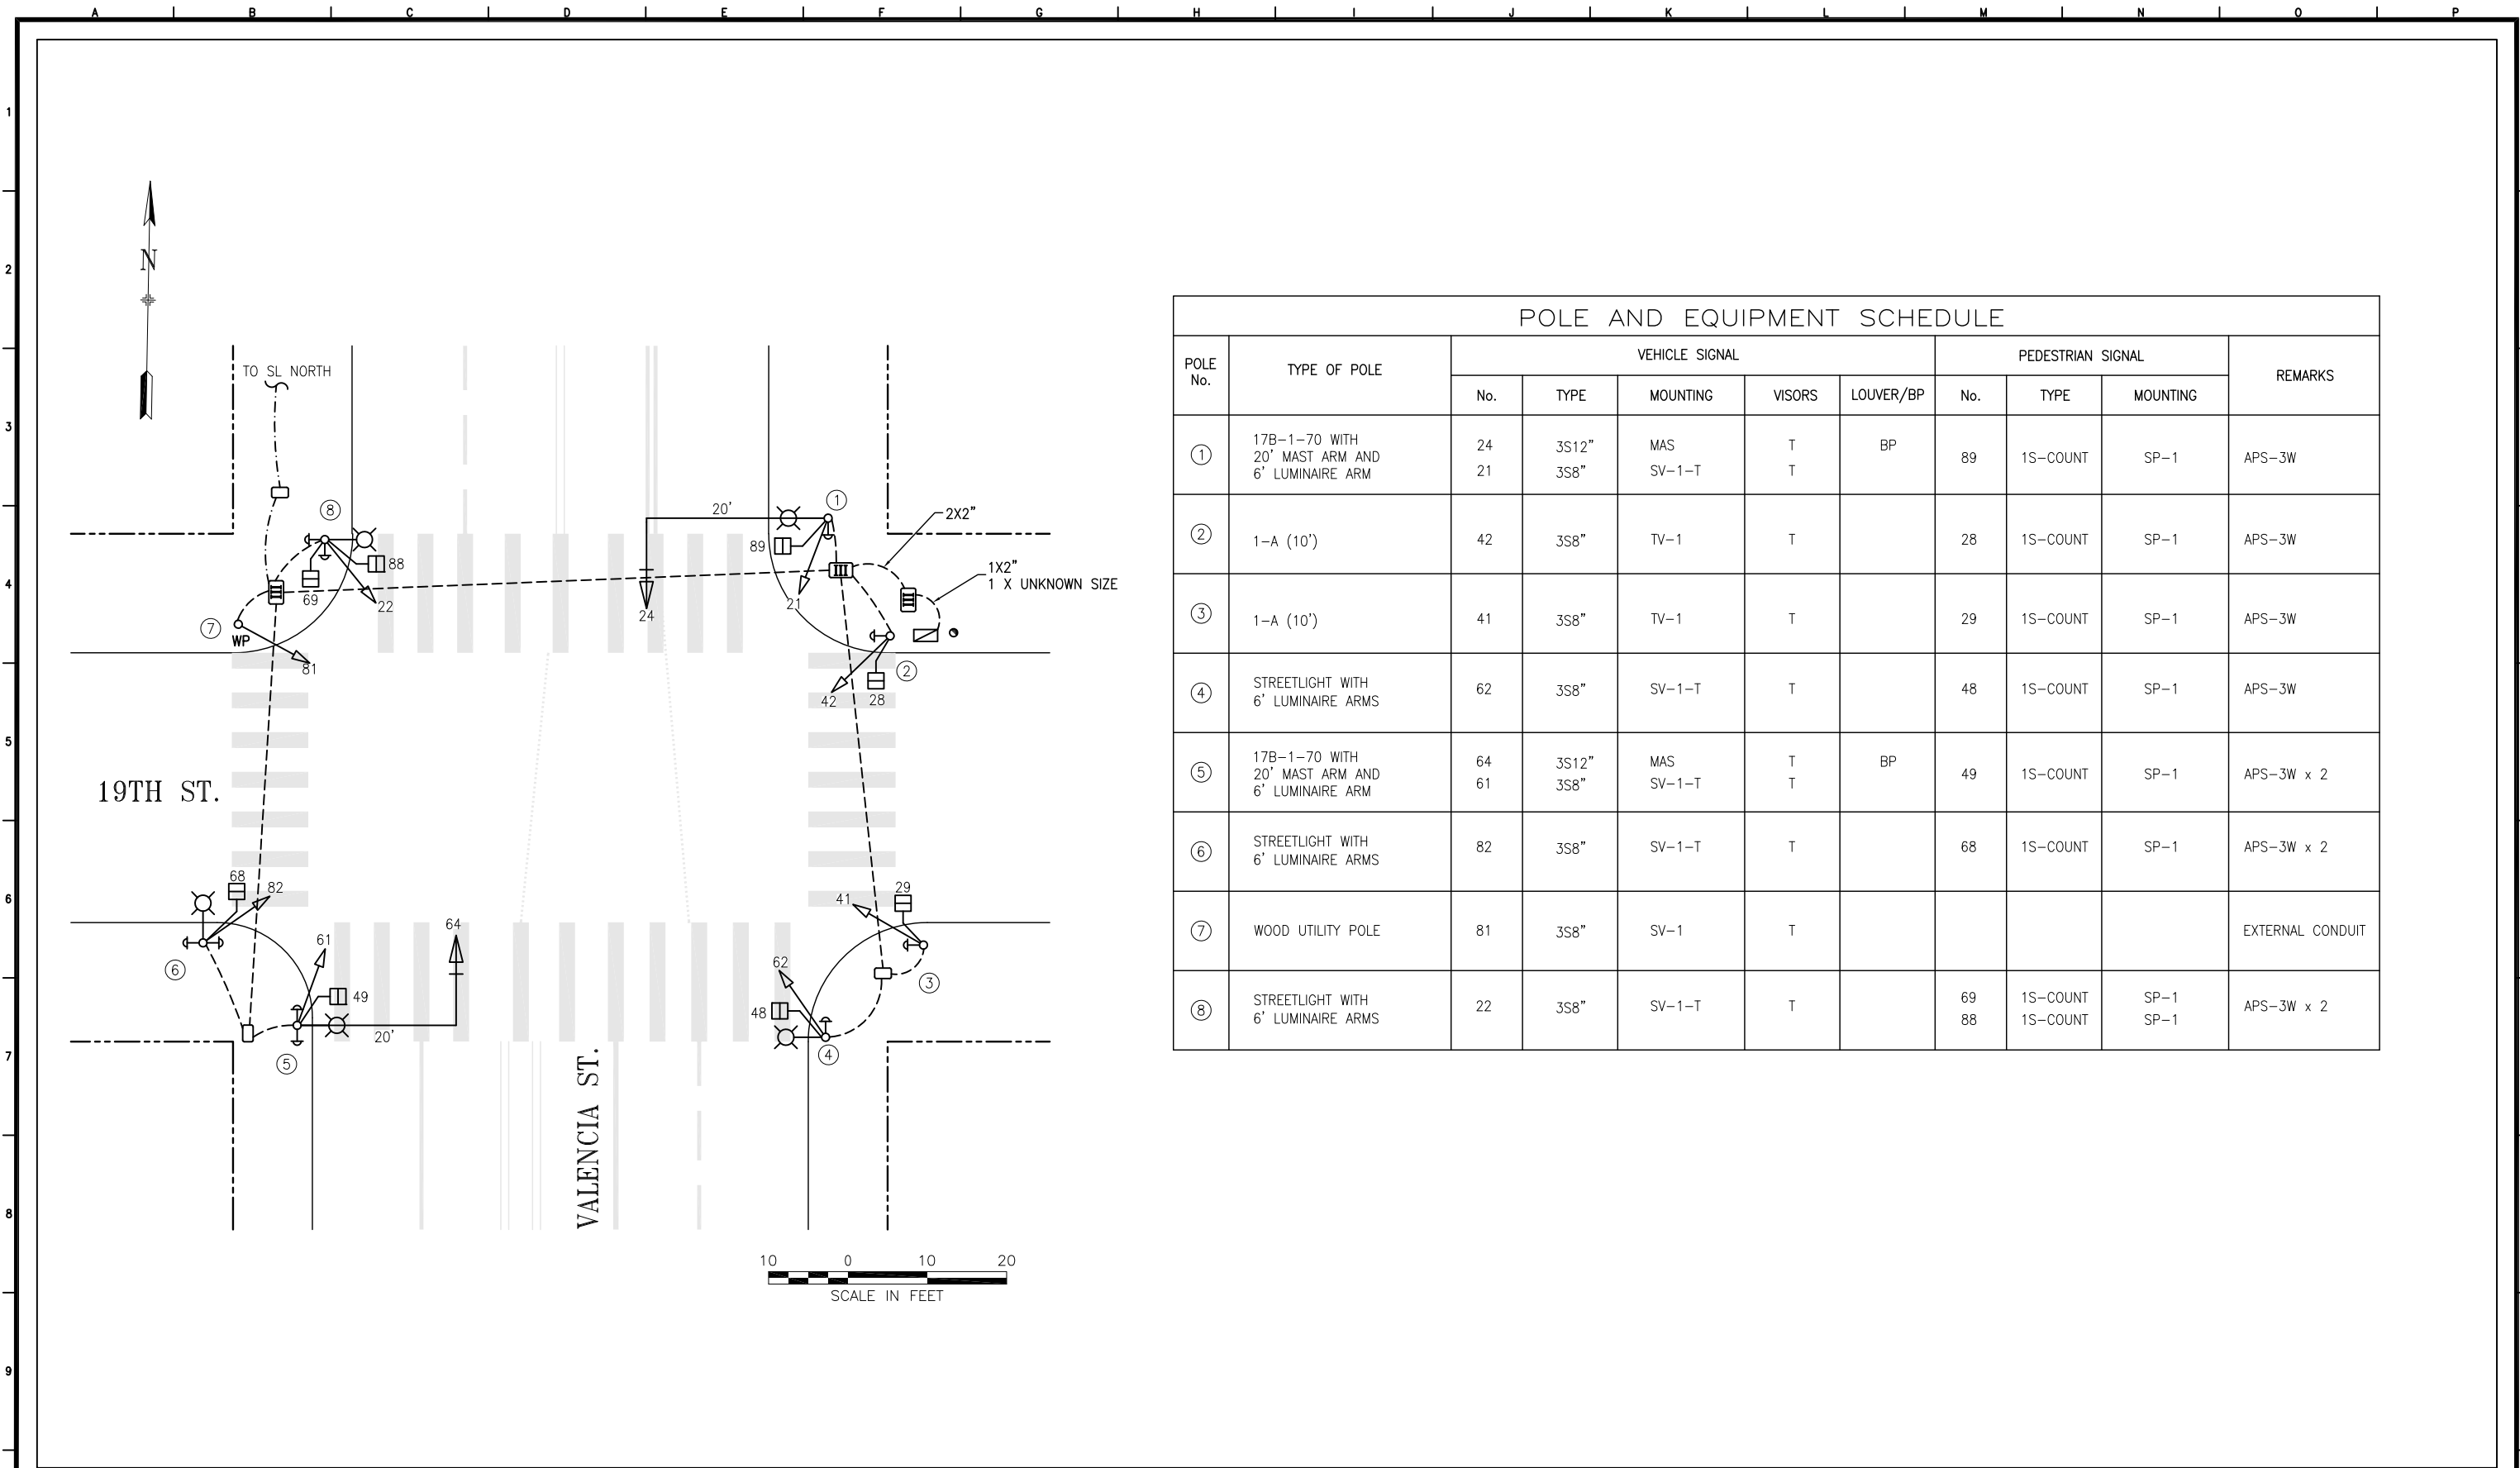

POLE AND EQUIPMENT SCHEDULE										
POLE No.	TYPE OF POLE	VEHICLE SIGNAL					PEDESTRIAN SIGNAL			REMARKS
		No.	TYPE	MOUNTING	VISORS	LOUVER/BP	No.	TYPE	MOUNTING	
①	17B-1-70 WITH 20' MAST ARM AND 6' LUMINAIRE ARM	24	3S12"	MAS	T	BP	89	1S-COUNT	SP-1	APS-3W
		21	3S8"	SV-1-T	T					
②	1-A (10')	42	3S8"	TV-1	T		28	1S-COUNT	SP-1	APS-3W
③	1-A (10')	41	3S8"	TV-1	T		29	1S-COUNT	SP-1	APS-3W
④	STREETLIGHT WITH 6' LUMINAIRE ARMS	62	3S8"	SV-1-T	T		48	1S-COUNT	SP-1	APS-3W
⑤	17B-1-70 WITH 20' MAST ARM AND 6' LUMINAIRE ARM	64	3S12"	MAS	T	BP	49	1S-COUNT	SP-1	APS-3W x 2
		61	3S8"	SV-1-T	T					
⑥	STREETLIGHT WITH 6' LUMINAIRE ARMS	82	3S8"	SV-1-T	T		68	1S-COUNT	SP-1	APS-3W x 2
⑦	WOOD UTILITY POLE	81	3S8"	SV-1	T					EXTERNAL CONDUIT
⑧	STREETLIGHT WITH 6' LUMINAIRE ARMS	22	3S8"	SV-1-T	T		69	1S-COUNT	SP-1	APS-3W x 2
							88	1S-COUNT	SP-1	

2	5/24/23	INSTALL APS (2023-026)	ELuu	GdeLeon	
1	07/05	ADD ADDITIONAL PED SIGNALS BY SIGNAL SHOP.	CLeung	JK	
NO.	DATE	DESCRIPTION	BY	APPROVED	
TABLE OF REVISIONS					
CHECKOUT DRAWING THROUGH THE SID CUSTODIAN FOR THE LATEST REVISION					



SFMTA

DRAWN BY:	DATE:
CLeung	04/03
CHECKED BY:	DATE:

SCALE
AS SHOWN
SHEET OF SHEETS
1 OF 1

TRAFFIC SIGNAL INVENTORY DIAGRAM
19TH ST & VALENCIA ST

CNN NO:	24158000
REV NO:	2