


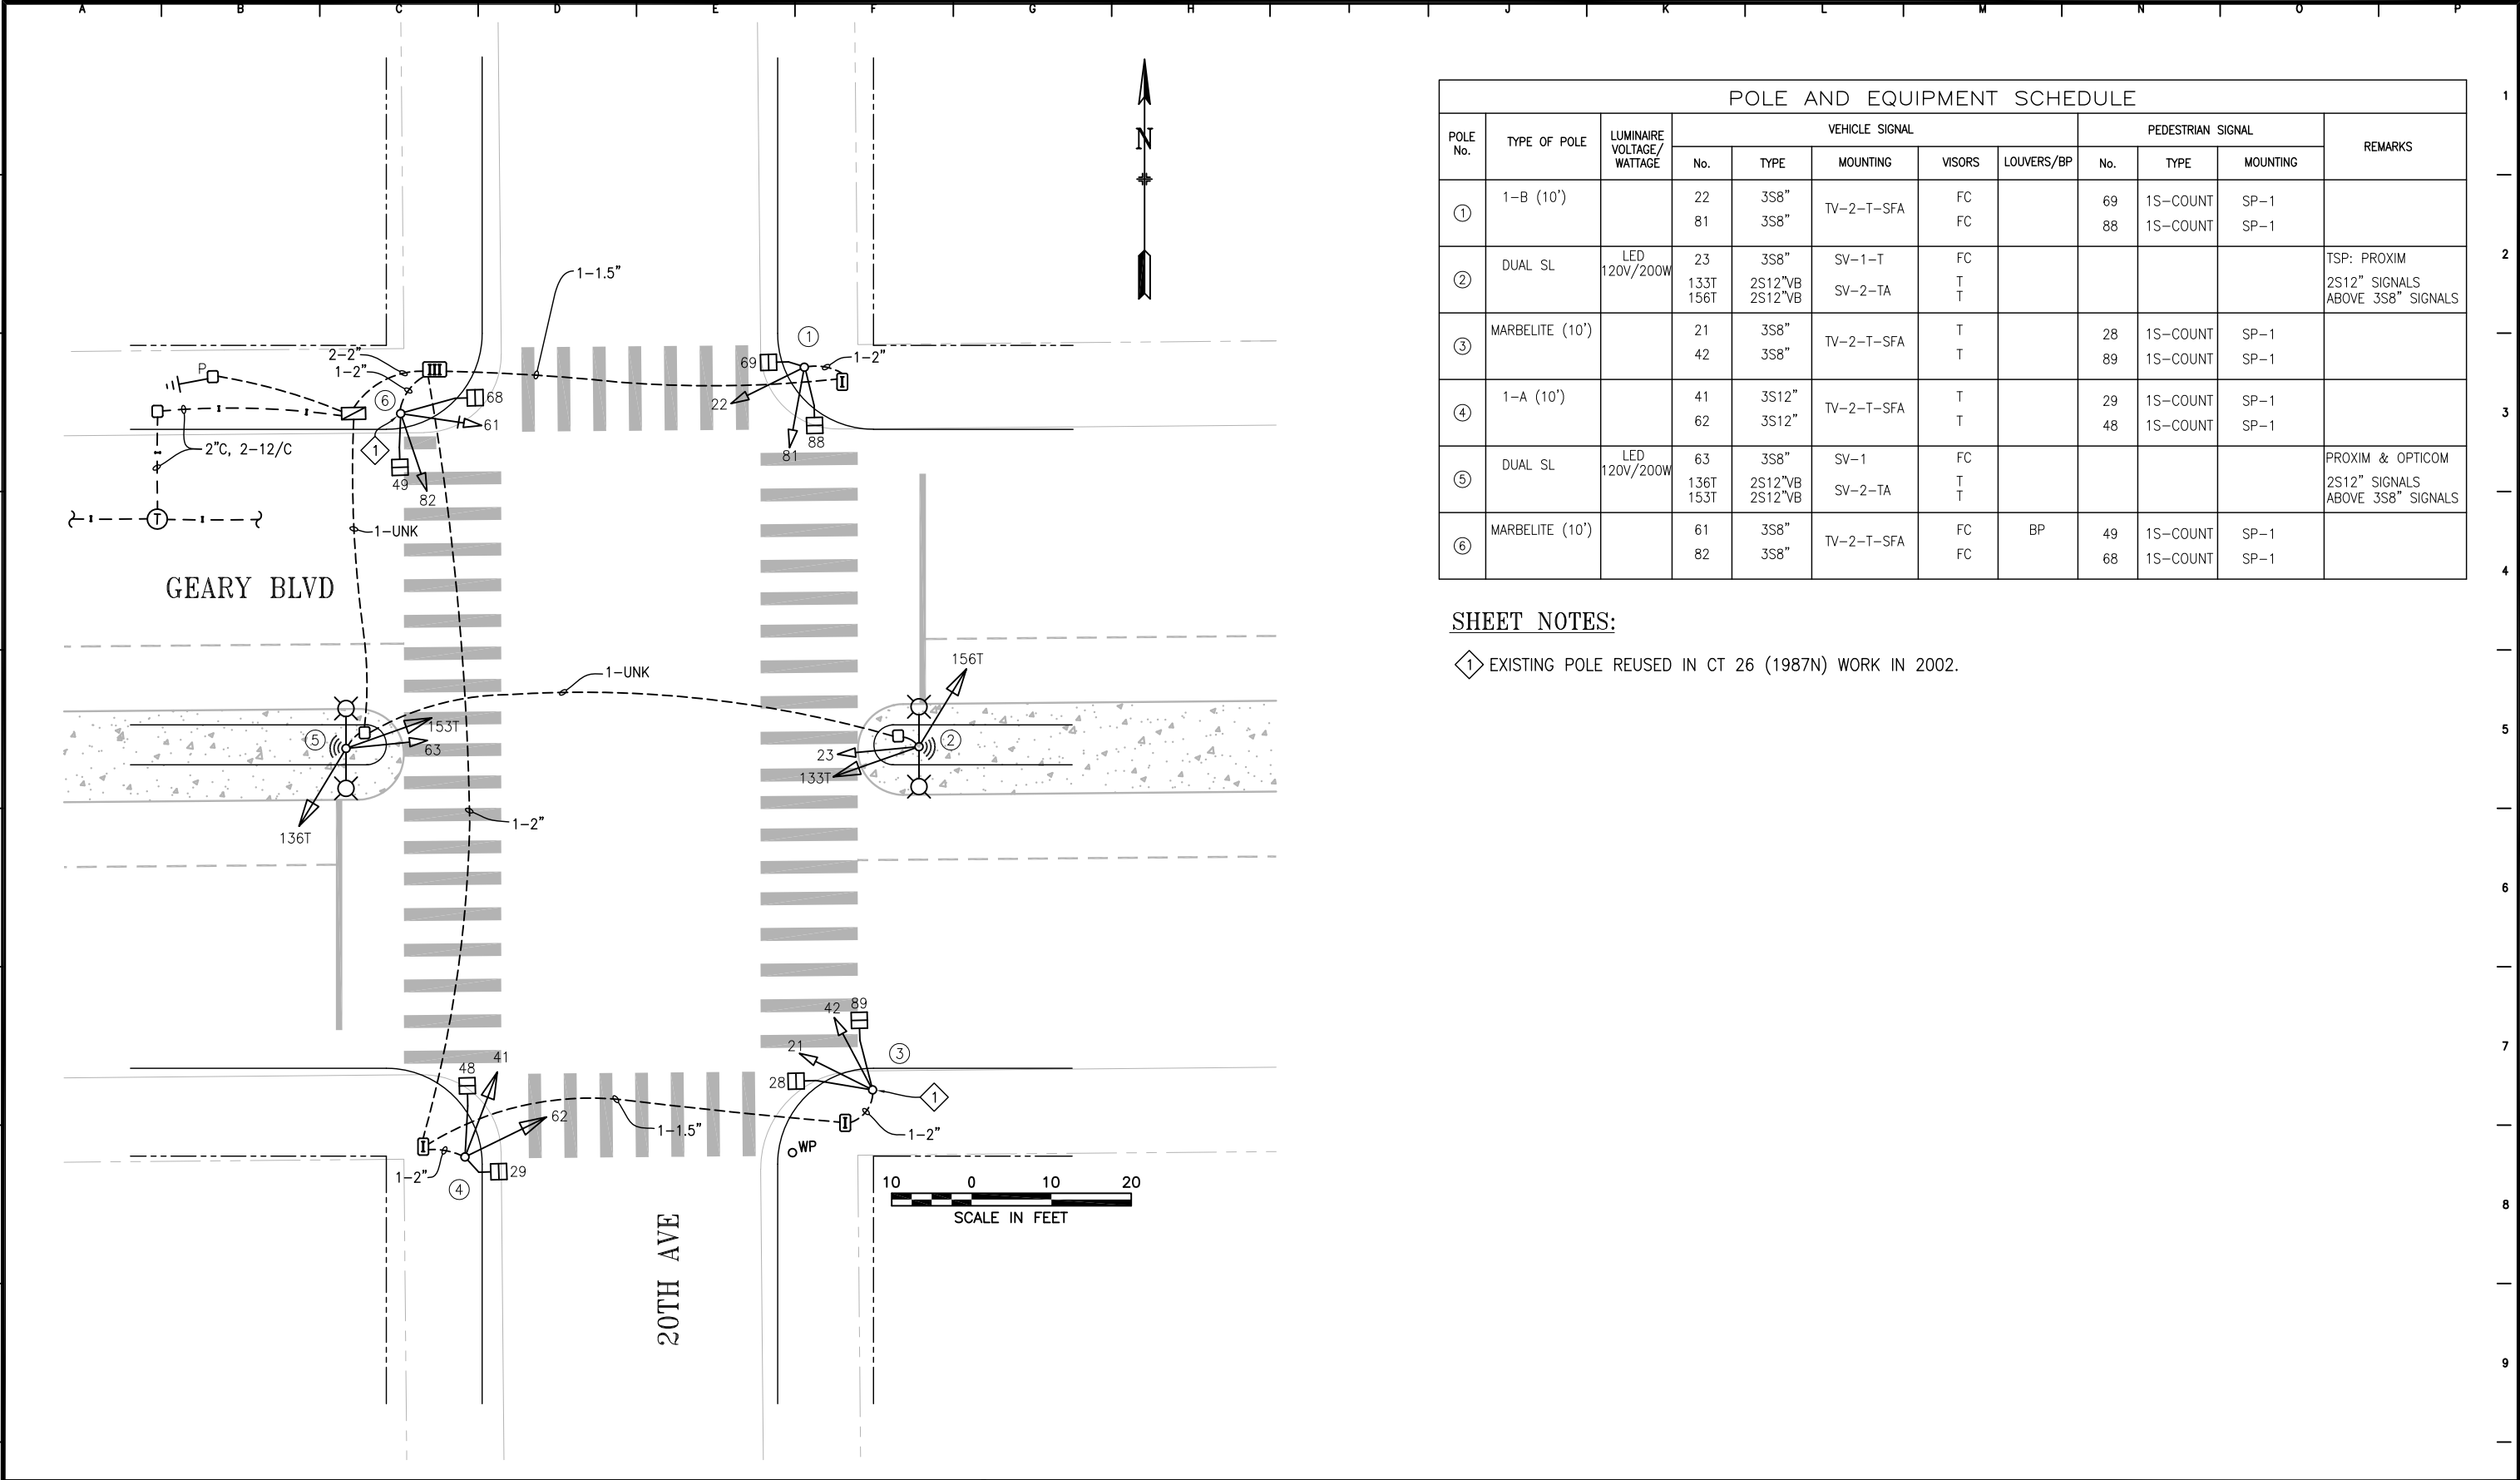

POLE AND EQUIPMENT SCHEDULE											
POLE No.	TYPE OF POLE	LUMINAIRE VOLTAGE/ WATTAGE	VEHICLE SIGNAL					PEDESTRIAN SIGNAL			REMARKS
			No.	TYPE	MOUNTING	VISORS	LOUVERS/BP	No.	TYPE	MOUNTING	
①	1-B (10')		22 81	3S8" 3S8"	TV-2-T-SFA	FC FC		69 88	1S-COUNT 1S-COUNT	SP-1 SP-1	
②	DUAL SL	LED 120V/200W	23 133T 156T	3S8" 2S12"VB 2S12"VB	SV-1-T SV-2-TA	FC T T					TSP: PROXIM 2S12" SIGNALS ABOVE 3S8" SIGNALS
③	MARBELITE (10')		21 42	3S8" 3S8"	TV-2-T-SFA	T T		28 89	1S-COUNT 1S-COUNT	SP-1 SP-1	
④	1-A (10')		41 62	3S12" 3S12"	TV-2-T-SFA	T T		29 48	1S-COUNT 1S-COUNT	SP-1 SP-1	
⑤	DUAL SL	LED 120V/200W	63 136T 153T	3S8" 2S12"VB 2S12"VB	SV-1 SV-2-TA	FC T T					PROXIM & OPTICOM 2S12" SIGNALS ABOVE 3S8" SIGNALS
⑥	MARBELITE (10')		61 82	3S8" 3S8"	TV-2-T-SFA	FC FC	BP	49 68	1S-COUNT 1S-COUNT	SP-1 SP-1	

SHEET NOTES:

① EXISTING POLE REUSED IN CT 26 (1987N) WORK IN 2002.

NO.	DATE	DESCRIPTION	BY	APPROVED
0	12/18/20	INSTALLED TRANSIT SIGNALS (ø13 & ø15) FOR GEARY EB & WB VIA SRC2020-283; CONVERTED FROM CT 26 (1987N) AS-BUILTS.	D. MACKOWSKI	K. KWONG
TABLE OF REVISIONS CHECKOUT DRAWING THROUGH THE SID CUSTODIAN FOR THE LATEST REVISION				



SFMTA

SEE CT 26 (1987N) E-2.0 FILE #74,251 FOR 8/20/2002 AS-BUILT DRAWING	SCALE AS SHOWN	TRAFFIC SIGNAL INVENTORY DIAGRAM	CNN NO: 27505000
DRAWN BY: D. MACKOWSKI DATE: 06/23/21	SHEET OF SHEETS 1 OF 1		REV NO: 0
CHECKED BY: K. KWONG DATE: 07/23/21		20TH AVE & GEARY BLVD	