


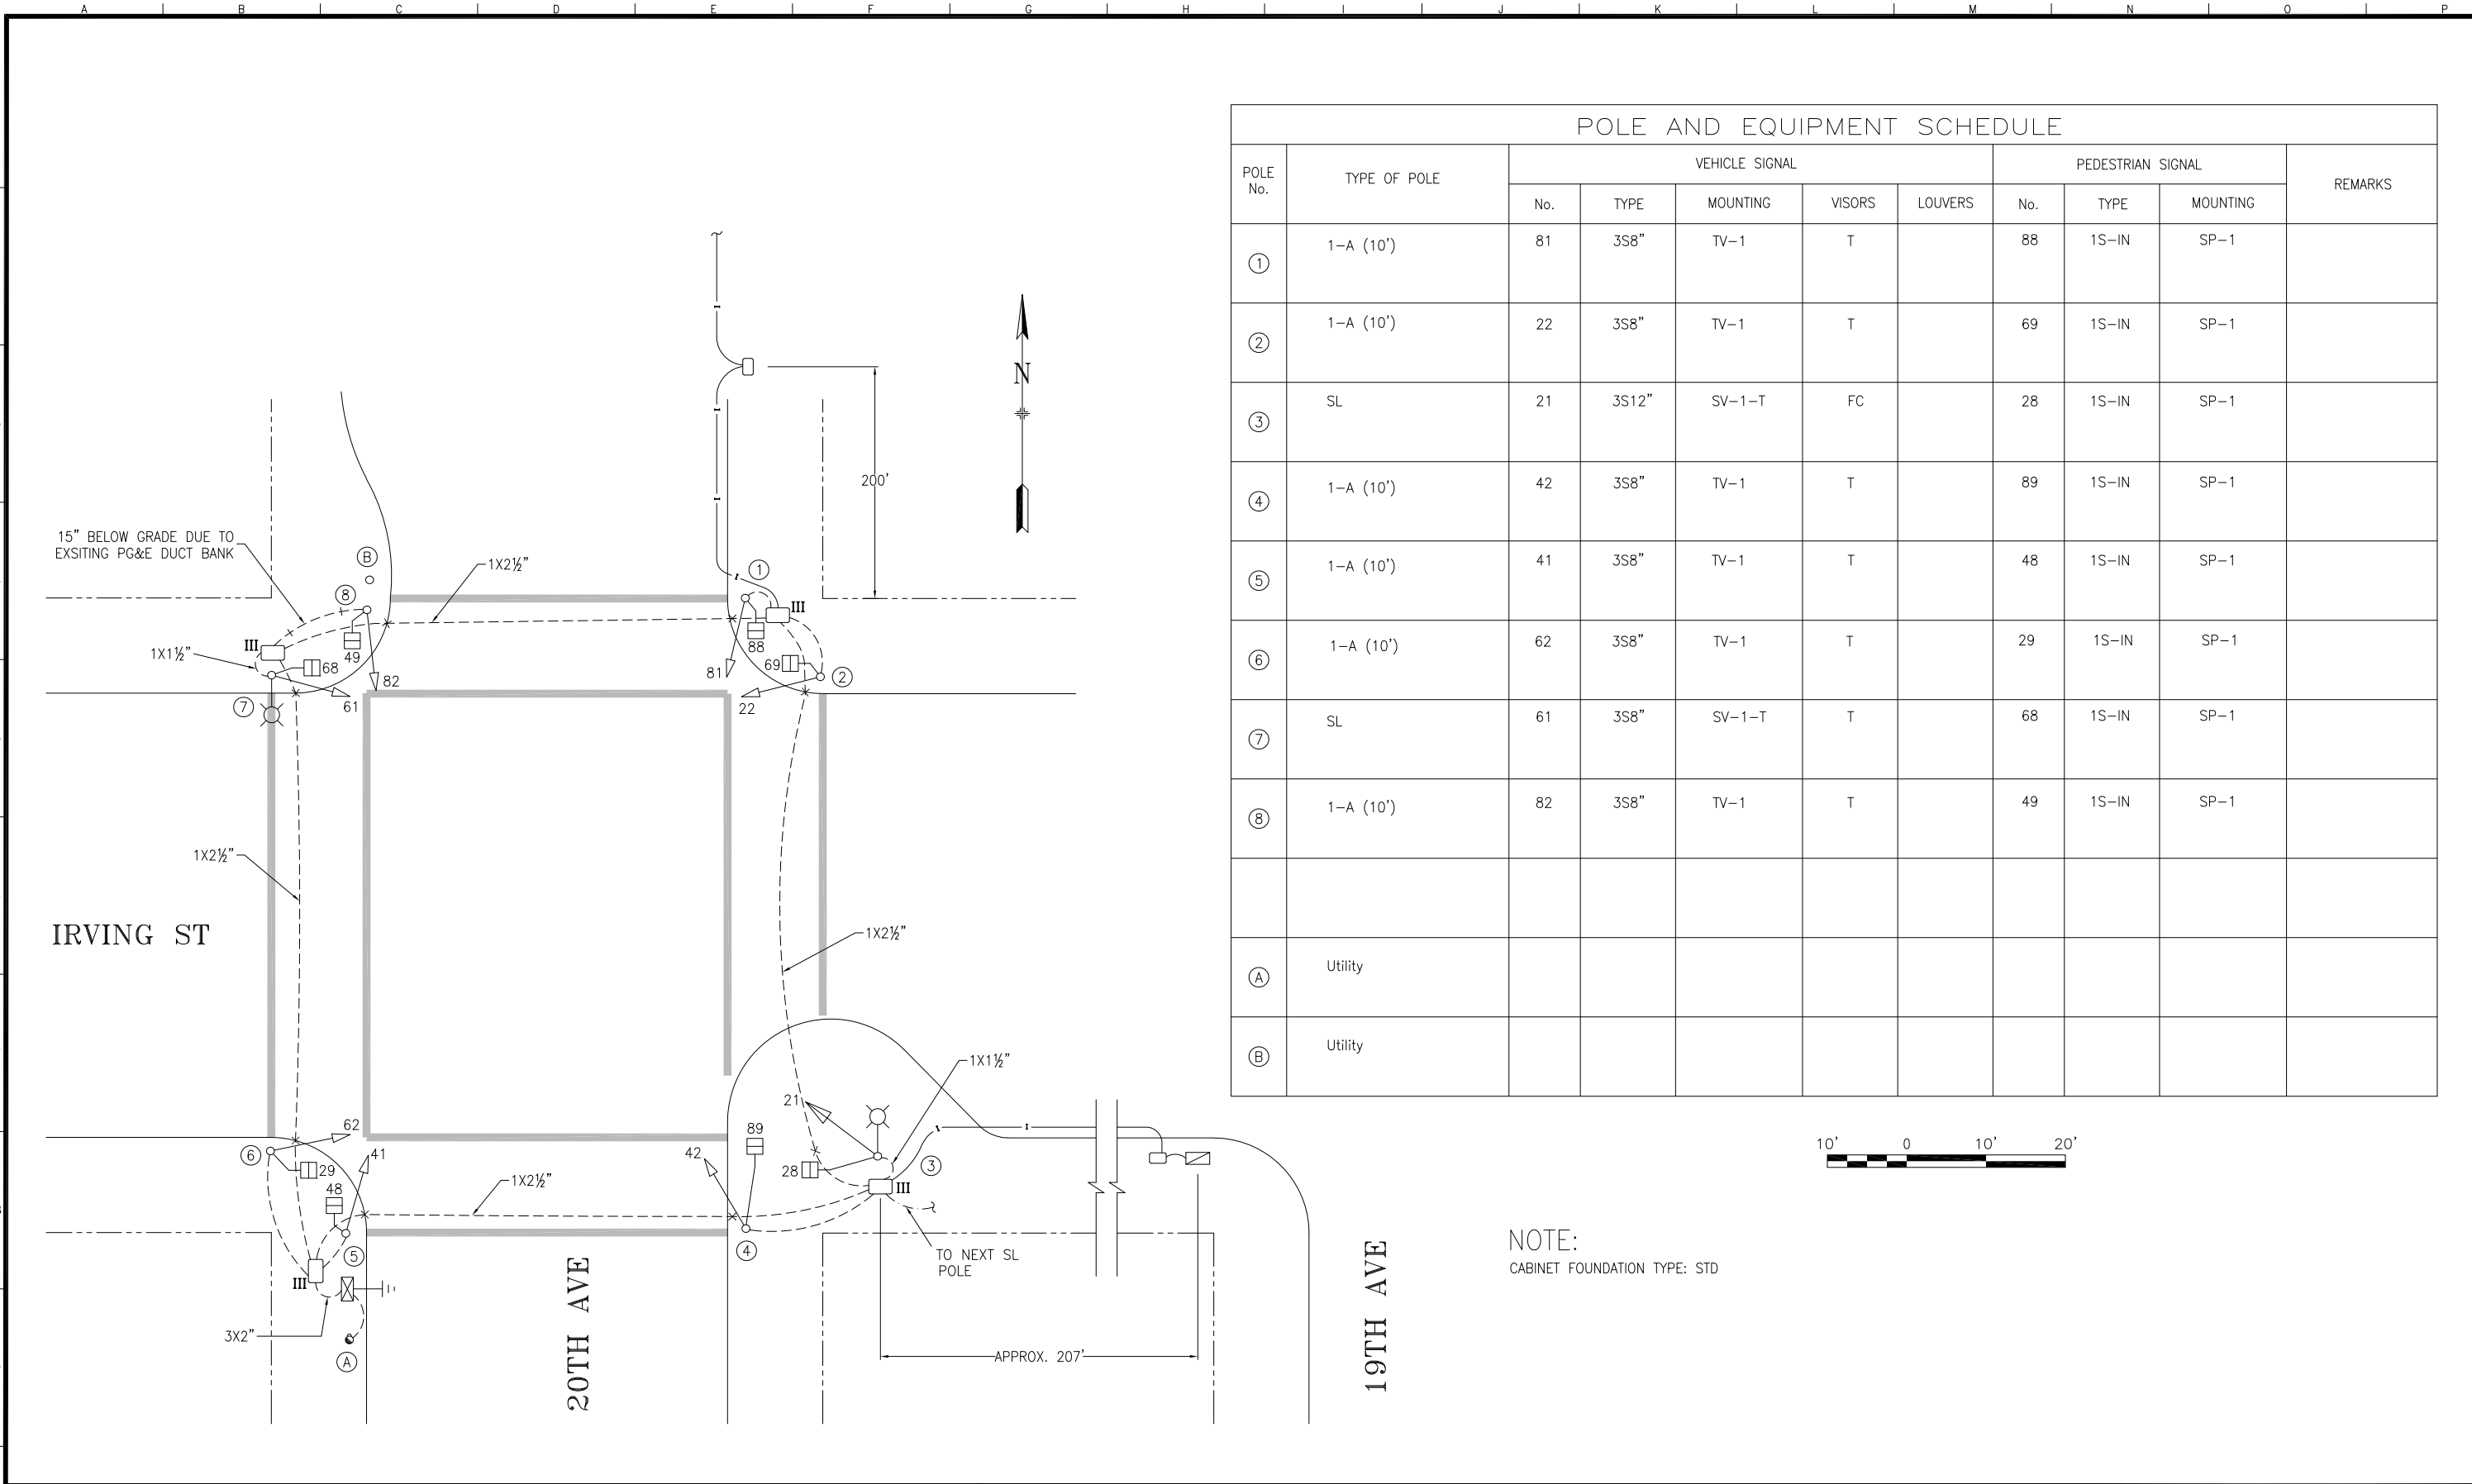

POLE AND EQUIPMENT SCHEDULE										
POLE No.	TYPE OF POLE	VEHICLE SIGNAL					PEDESTRIAN SIGNAL			REMARKS
		No.	TYPE	MOUNTING	VISORS	LOUVERS	No.	TYPE	MOUNTING	
①	1-A (10')	81	3S8"	TV-1	T		88	1S-IN	SP-1	
②	1-A (10')	22	3S8"	TV-1	T		69	1S-IN	SP-1	
③	SL	21	3S12"	SV-1-T	FC		28	1S-IN	SP-1	
④	1-A (10')	42	3S8"	TV-1	T		89	1S-IN	SP-1	
⑤	1-A (10')	41	3S8"	TV-1	T		48	1S-IN	SP-1	
⑥	1-A (10')	62	3S8"	TV-1	T		29	1S-IN	SP-1	
⑦	SL	61	3S8"	SV-1-T	T		68	1S-IN	SP-1	
⑧	1-A (10')	82	3S8"	TV-1	T		49	1S-IN	SP-1	
①	Utility									
②	Utility									

2	2/2/23	UPGRADED TO 2070 CONTROLLER/MSF CABINET W/ADAPTER PLATE SRC 2022-193	N.KOBAYASHI	G.DELEON
1	01/97	NEW TRAFFIC SIGNALS CT 48.	CXL	DVS
NO.	DATE	DESCRIPTION	BY	APPROVED

TABLE OF REVISIONS
CHECKOUT DRAWING THROUGH THE SID CUSTODIAN FOR THE LATEST REVISION



SFMTA

DRAWN BY:	DATE:
CXL	08/02/99
CHECKED BY:	DATE:

SCALE	1" = 20'
SHEET OF SHEETS	1 OF 1

TRAFFIC SIGNAL INVENTORY DIAGRAM	CNN NO: 27375000
20TH AVE & IRVING ST	REV NO: 2

FILE NAME: 20th_Irving.dwg
DATE: Jul 31 2000 16:47
ORIGIN: SALES & TAX
SCALE FACTOR: 120
PLOT SCALE: 1"=1'
EXTERNAL REFERENCES: 03/4/22.dwg
FONTS USED: ROMANS.SHX ROMANS.SHX ROMANS.SHX