


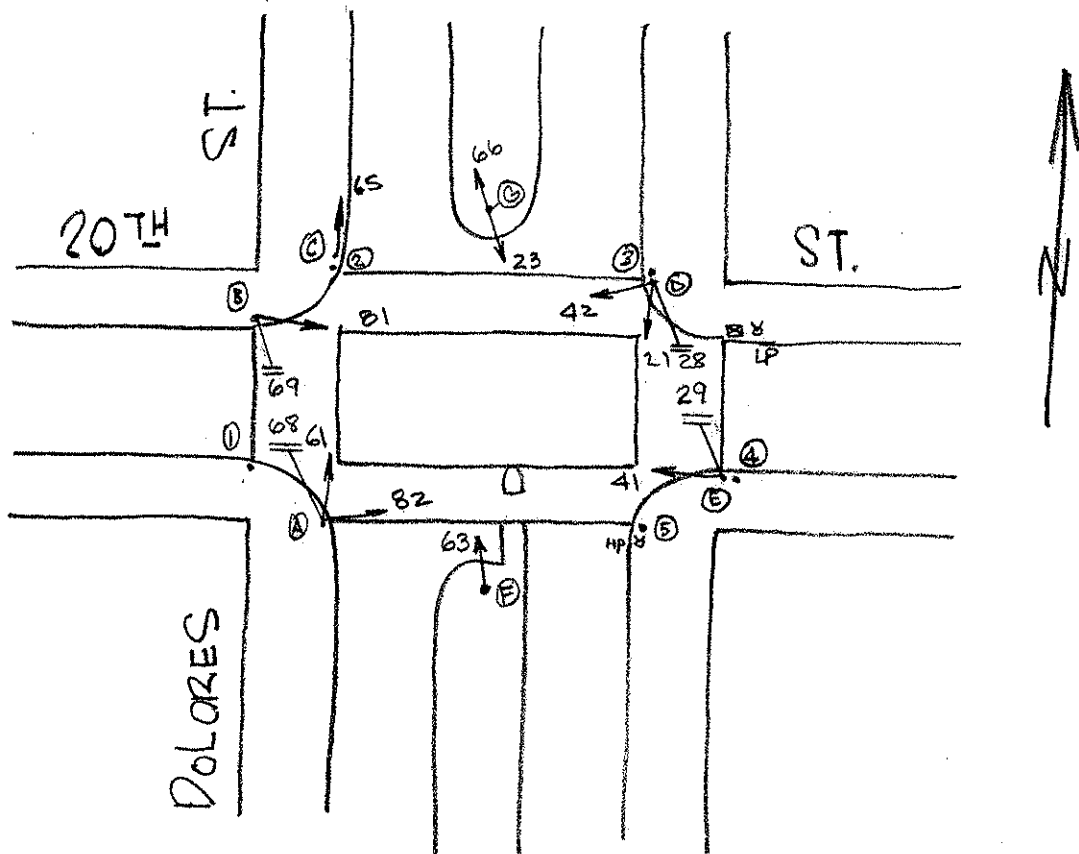

03-14-03

POLE	FUNC.	MAT'L	SIGNAL NO.	MAKE	NO. OF SECT.	SIZE	VISOR	B.P. OR LOUVERS	MOUN'T	PED SIGNAL NO.	LEGEND	MESSAGE		MAKE	MOUN'T
												ELEMENT	COLOR		
A	S	S	82	EC	3	8"	FC 8"	NO	T	28	INT	IS-I	W/OR	ICC	S
B	S	S	61	EC	3	8"	FC 8"	NO	T	29	INT	IS-I	W/OR	ICC	S
C	S	S	63	TCT	4	12"	FC 12"	NO	T	68	INT	IS-I	W/OR	ICC	S
D	S	S	81	EA	3	8"	FC 8"	NO	T	69	INT	IS-I	W/OR	ICC	S
E	S	S	65	EA	3	8"	FC 8"	NO	T						
F	S	S	42	EA	3	8"	FC 8"	NO	T						
G	S	S	21	EA	3	8"	FC 8"	NO	T						
1	U	W	23	TCT	4	12"	FC 12"	NO	T						
2	U	W	41	EA	3	8"	FC 8"	NO	T						
3	U	W	66	TCT	3	8"	FC 8"	NO	T						
4	U	W													
5	U	W													

CONTROLLER CABINET SIZE : ORDINARY BASE CABINET: YES

COMMENTS : Adding LT green arrows to 63 and 23.
Upgrading from 3 section 8" to 4 section 12"