


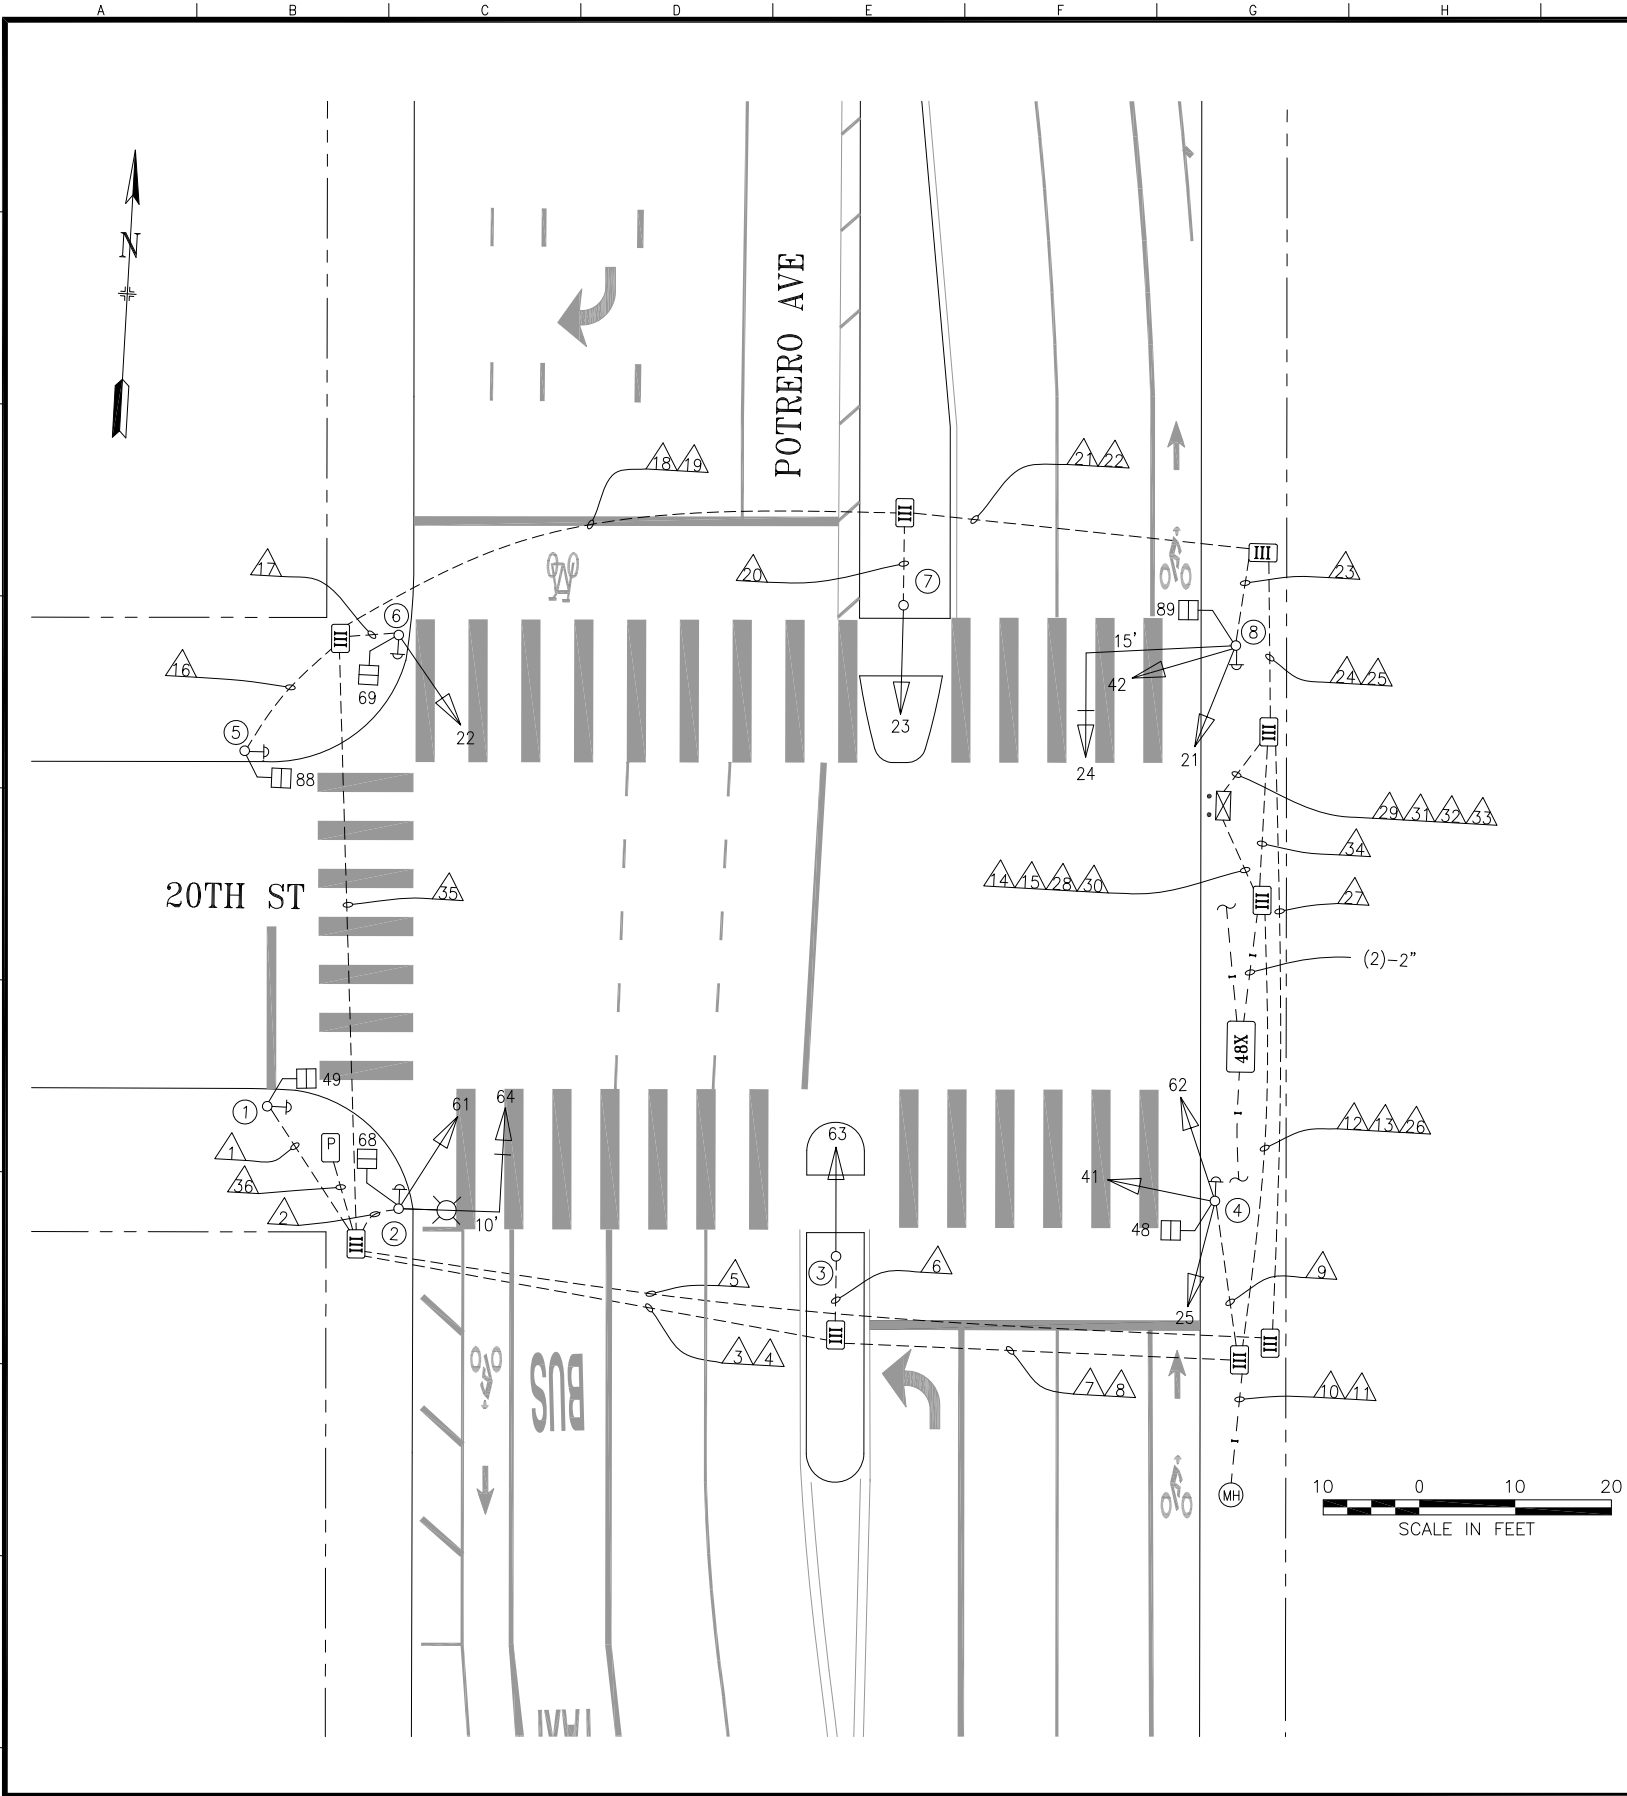

POLE & EQUIPMENT SCHEDULE										
POLE No.	TYPE OF POLE	VEHICLE SIGNAL					PEDESTRIAN SIGNAL			REMARKS
		No.	TYPE	MOUNTING	VISORS	LOUVERS/BP	No.	TYPE	MOUNTING	
①	1-A (7')						49	1S-COUNT	TP-1	APS-2W
②	19-1-100 W/ 10' MAST ARM	61 64	3S12" 3S12"	SV-1-T MAS	T T	BP	68	1S-COUNT	SP-1	APS-2W TSP
③	1-A (10')	63	3S12"	TV-1-T	T					
④	1-A (15')	25 41 62	3S12" 3S12" 3S12"	SV-3-TA	T T T		48	1S-COUNT	SP-1	APS-2W
⑤	1-A (7')						88	1S-COUNT	TP-1	APS-2W
⑥	1-A (10')	22	3S12"	TV-1-T	T		69	1S-COUNT	SP-1(22")	APS-2W
⑦	1-A (10')	23	3S12"	TV-1-T	T					
⑧	16-1-100 W/ 15' MAST ARM	21 42 24	3S12" 3S12" 3S12"	SV-2-TC W/ EXTENDER & COUPLER MAS	T T T	BP	89	1S-COUNT	SP-1	APS-2W TSP

0	01/10/18	UPGRADED BY 2127J; CONVERTED FROM AS-BUILTS	Hfu	Ventura	
NO.	DATE	DESCRIPTION	BY	APP.	
TABLE OF REVISIONS					
CHECK WITH TRACING TO SEE IF YOU HAVE LATEST REVISION					

REFERENCE INFORMATION & FILE NO. OF SURVEYS



SAN FRANCISCO MUNICIPAL TRANSPORTATION AGENCY

CITY AND COUNTY OF SAN FRANCISCO

DRAWN:	DATE:
H.YU	07/2019
CHECKED:	DATE:
L.VENTURA	09/2020

SCALE:
AS SHOWN
SHEET OF SHEETS
1 OF 2

TRAFFIC SIGNAL INVENTORY DIAGRAM
20TH STREET AND POTRERO AVENUE

CNN NO.
24001000
REV NO.
0

