


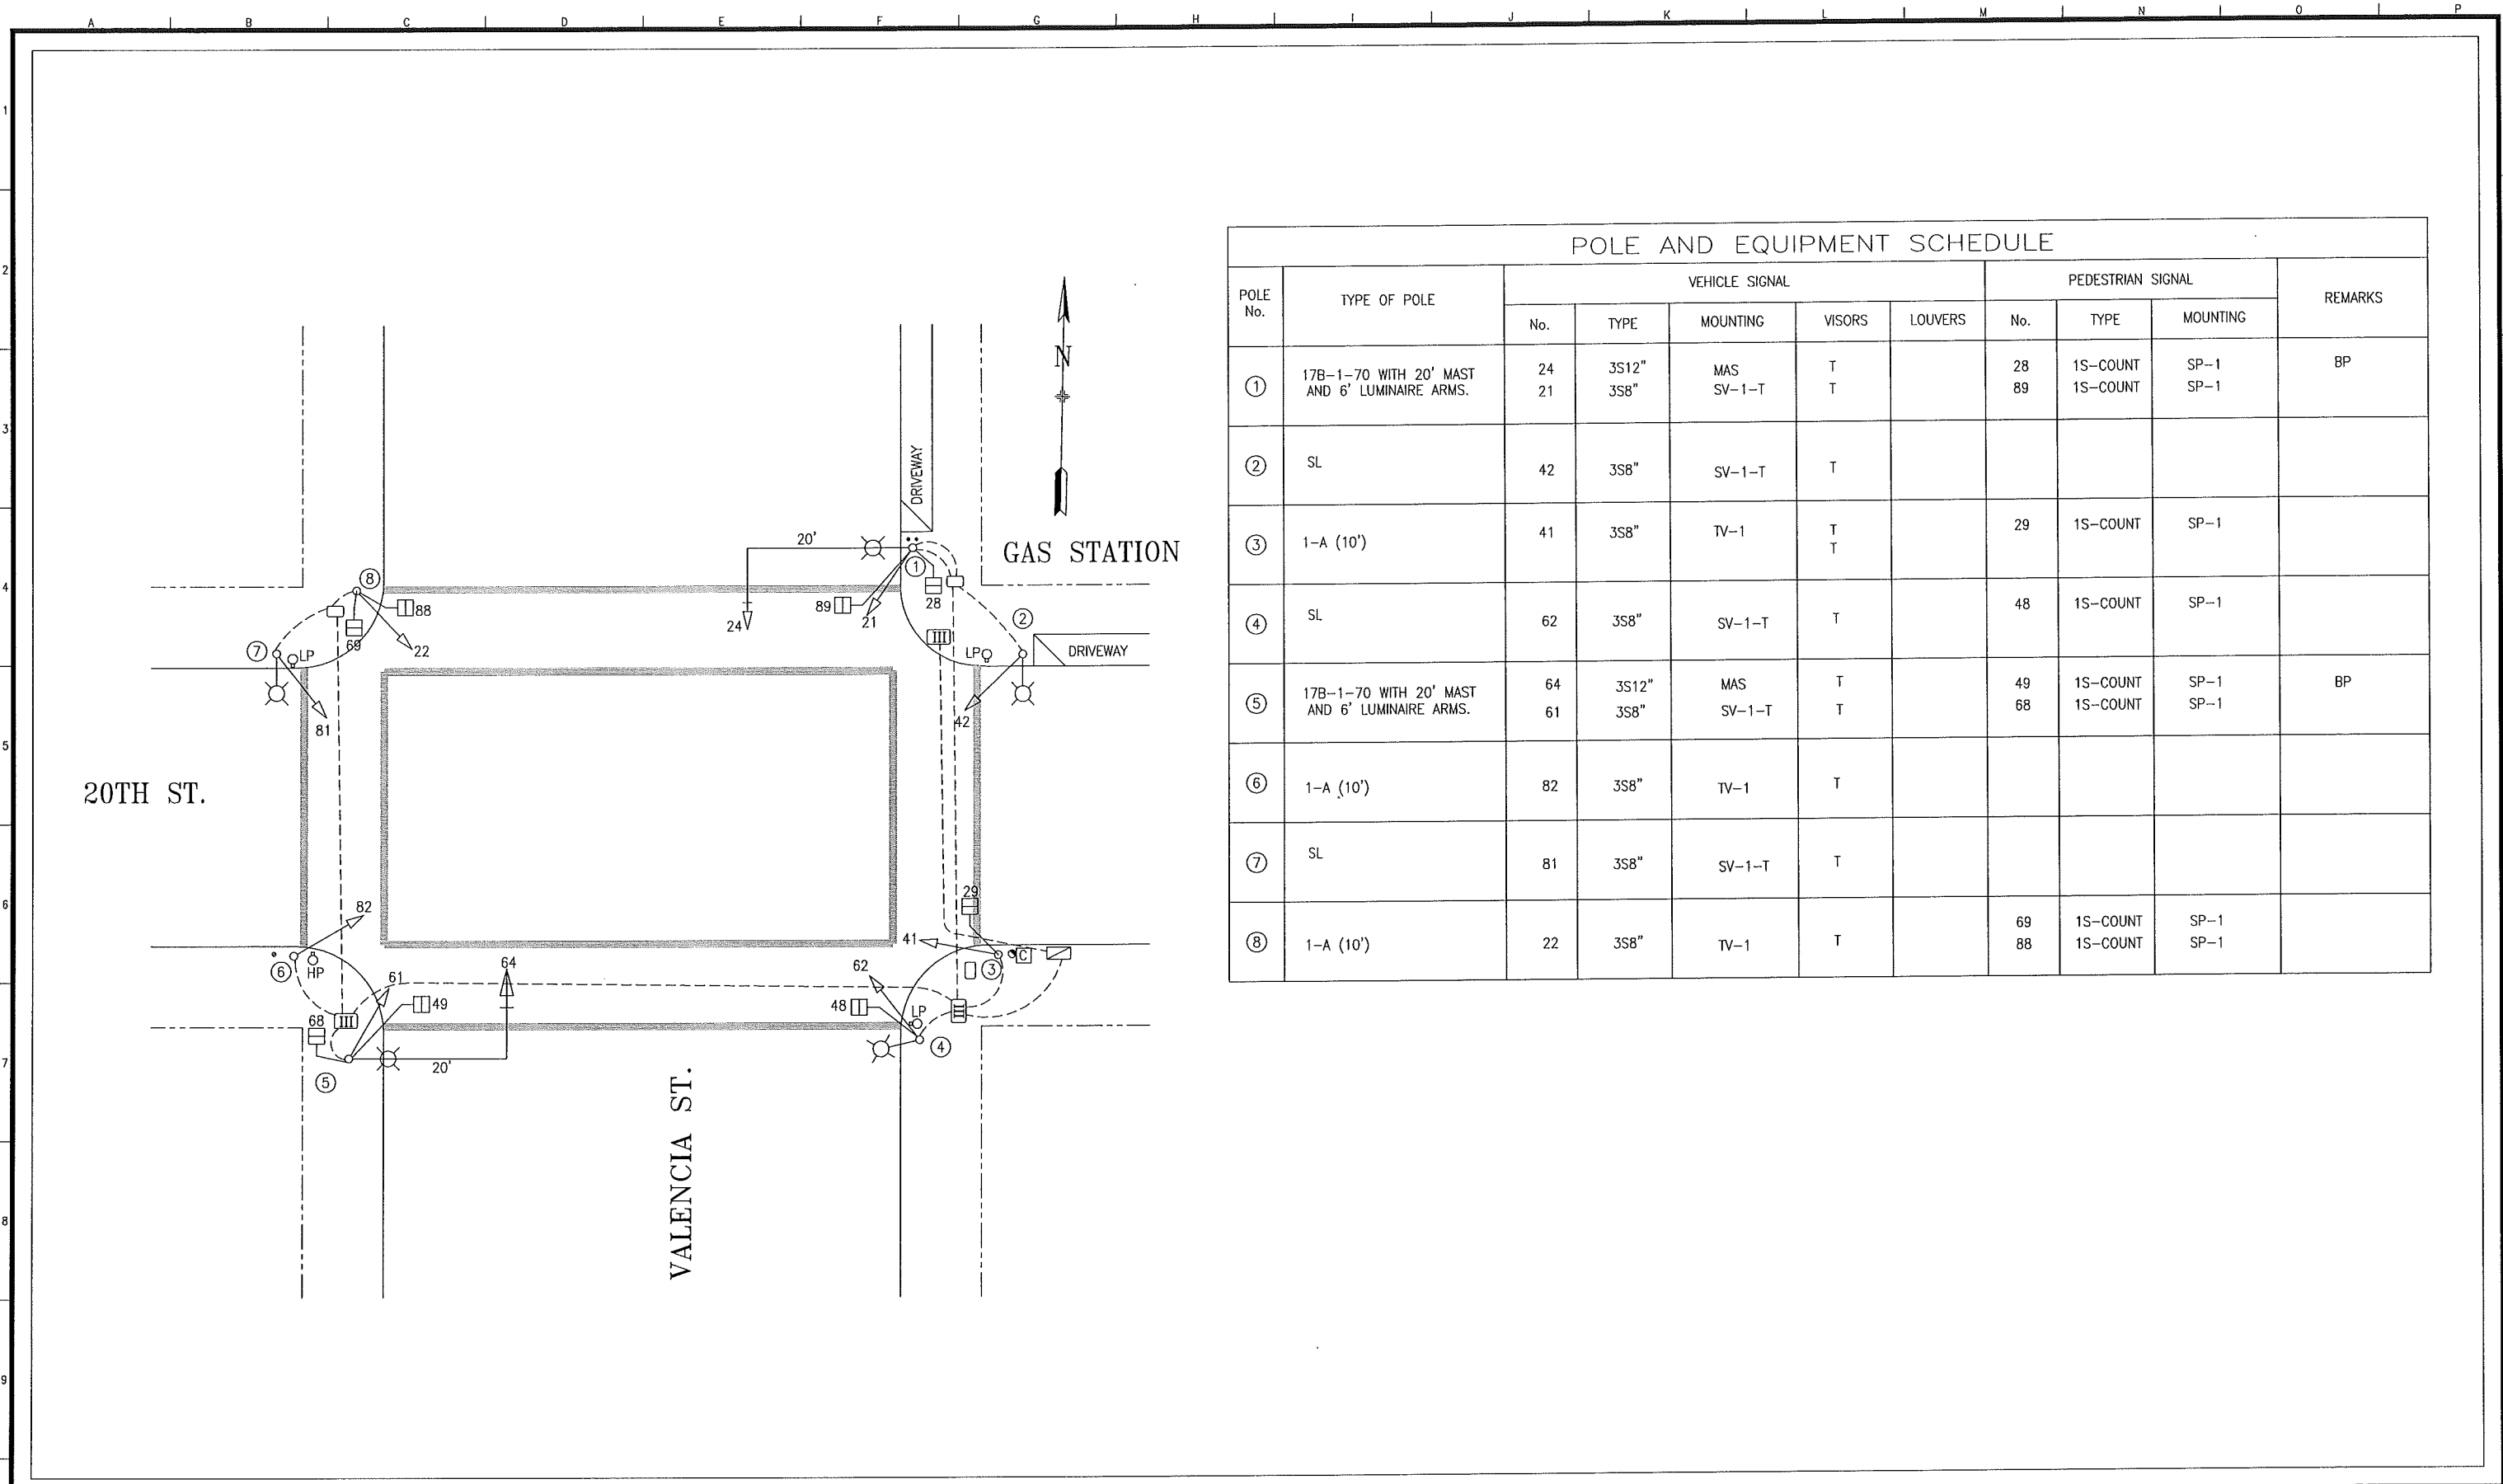

POLE AND EQUIPMENT SCHEDULE										
POLE No.	TYPE OF POLE	VEHICLE SIGNAL					PEDESTRIAN SIGNAL			REMARKS
		No.	TYPE	MOUNTING	VISORS	LOUVERS	No.	TYPE	MOUNTING	
①	17B-1-70 WITH 20' MAST AND 6' LUMINAIRE ARMS.	24	3S12"	MAS	T		28	1S-COUNT	SP-1	BP
		21	3S8"	SV-1-T	T		89	1S-COUNT	SP-1	
②	SL	42	3S8"	SV-1-T	T					
③	1-A (10')	41	3S8"	TV-1	T		29	1S-COUNT	SP-1	
④	SL	62	3S8"	SV-1-T	T		48	1S-COUNT	SP-1	
⑤	17B-1-70 WITH 20' MAST AND 6' LUMINAIRE ARMS.	64	3S12"	MAS	T		49	1S-COUNT	SP-1	BP
		61	3S8"	SV-1-T	T		68	1S-COUNT	SP-1	
⑥	1-A (10')	82	3S8"	TV-1	T					
⑦	SL	81	3S8"	SV-1-T	T					
⑧	1-A (10')	22	3S8"	TV-1	T		69	1S-COUNT	SP-1	
							88	1S-COUNT	SP-1	

1 07/05 ADD ADDITIONAL PED SIGNALS BY SIGNAL SHOP.			CXL JK	COMPLETION DATE / ELECTRICIAN INITIAL		DEPARTMENT OF PARKING AND TRAFFIC DIVISION OF TRAFFIC ENGINEERING CITY AND COUNTY OF SAN FRANCISCO	DRAWN: CXL DATE: 4/03 SCALE: 1" = 20'	TRAFFIC SIGNAL INVENTORY DIAGRAM	CNN NO. 24153000
NO.	DATE	DESCRIPTION	BY				APP.		CHECKED: JK DATE: 5/06 SHEET OF SHEETS 1 OF 1
TABLE OF REVISIONS CHECK WITH TRACING TO SEE IF YOU HAVE LATEST REVISION									

Drawing Path: T:\E_FILES\Official_Records\Signal_Inventory\Current\20ST_Valencia.dwg, Login: CLEUNG2
Plot Time: Thu, 13 Apr 2006 - 3:17pm
Dimension Scale: 120 Model Units: Feet
Measurement Units are English
Signal Inventory Diagram Title Block [T:\E_FILES\Special Projects & Street Use\SID\View SID\Signal Inventory Diagram Title Block.dwg]