
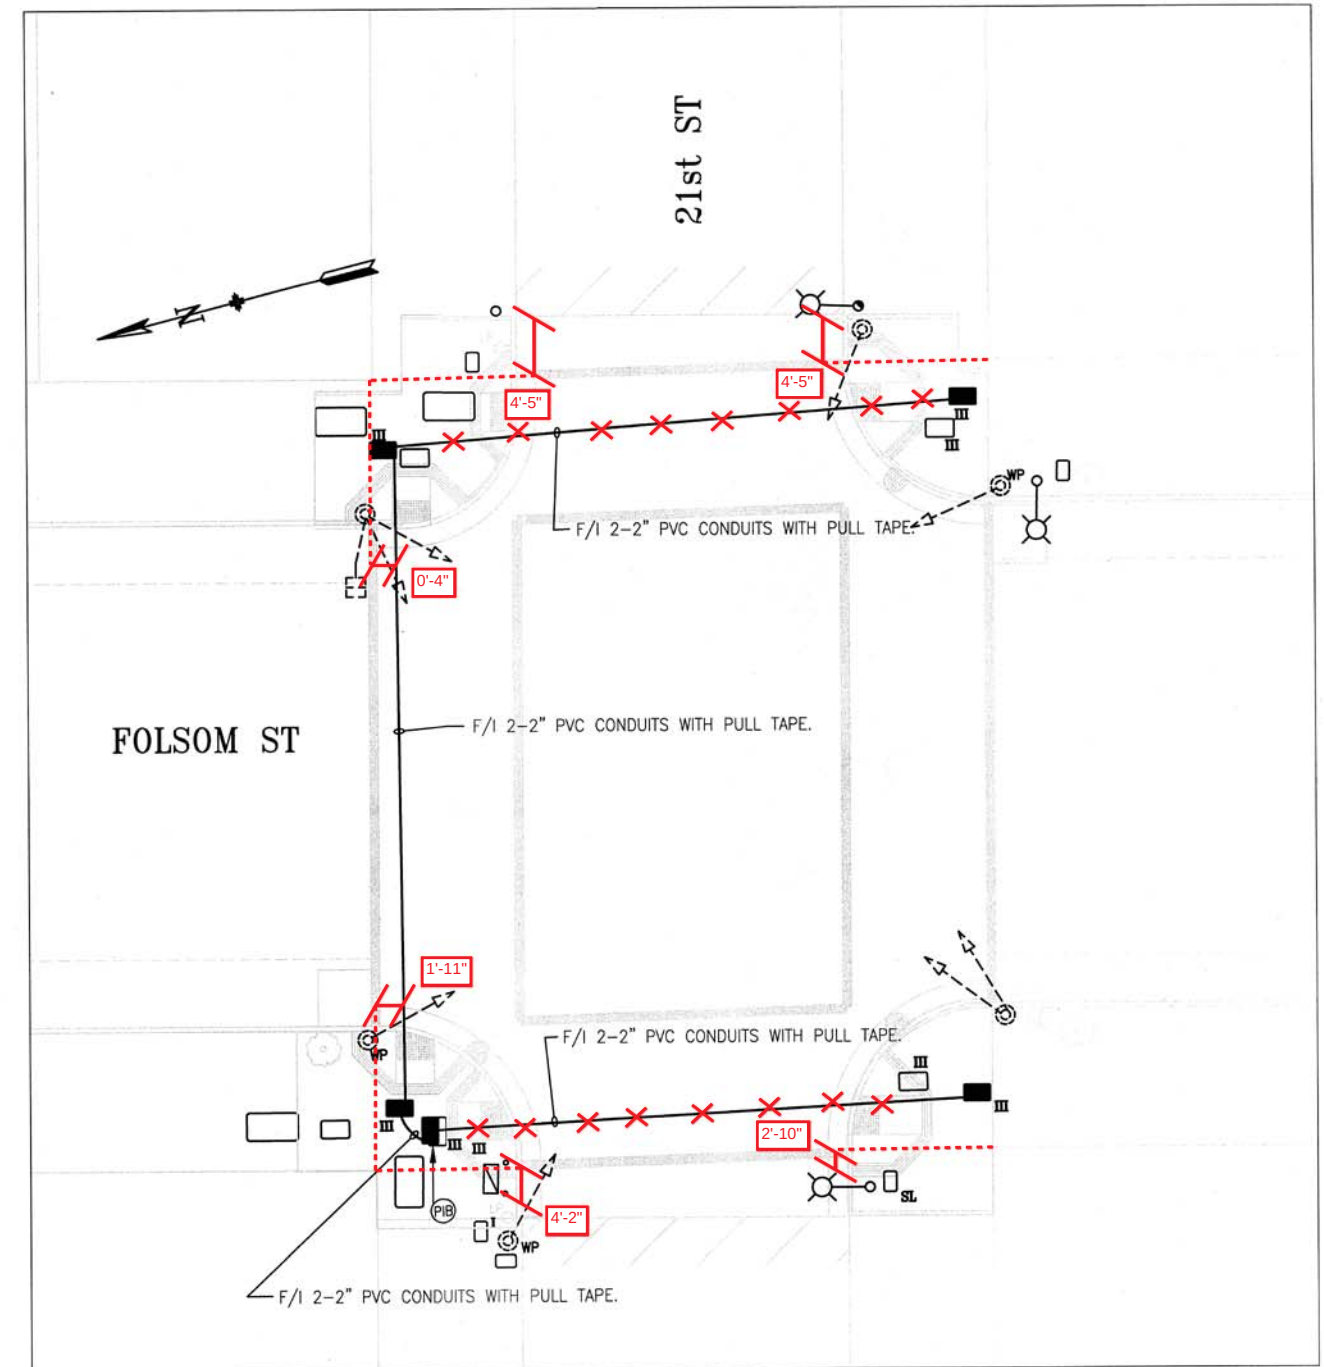


COMMENTS: Replaced Ped Signals with ICC

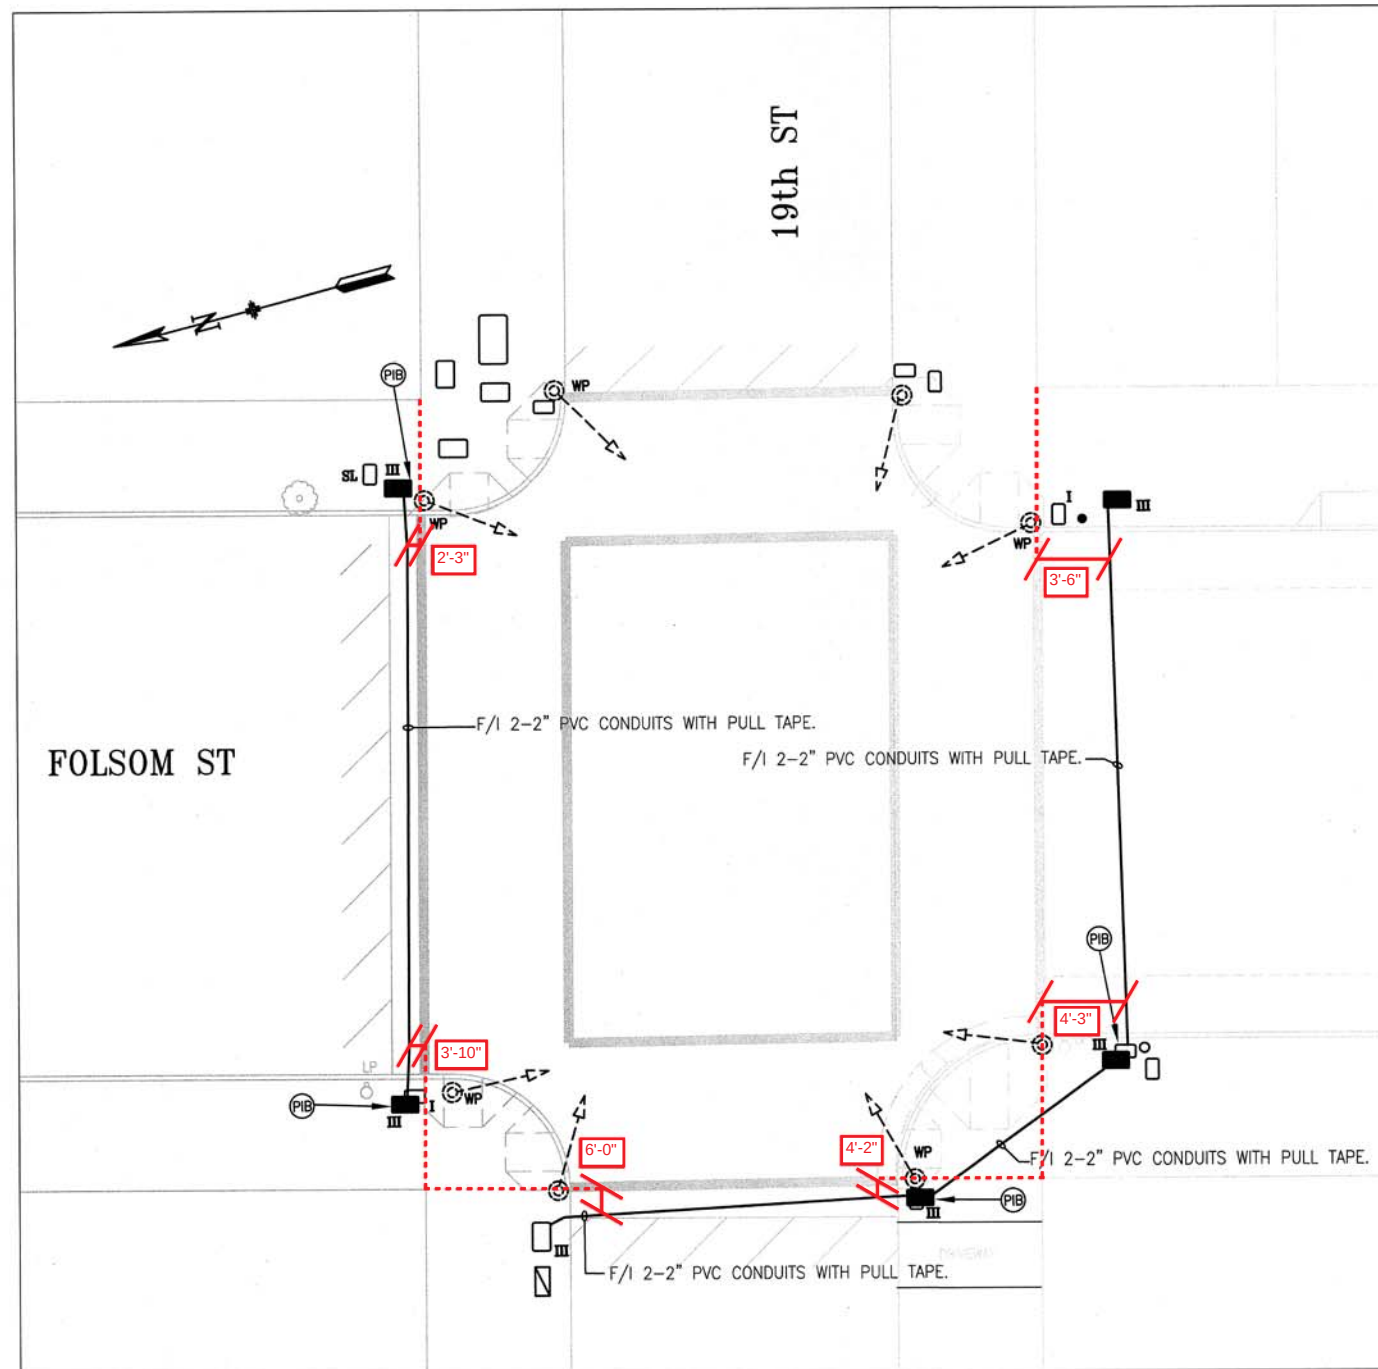

AS-BUILT
DATE: 9/30/13
BY: MIKE WONG
PHOENIX ELECTRIC
1350 VAN DYKE AVENUE
SAN FRANCISCO, CA 94124

BASE BID

NO.	DATE	DESCRIPTION	BY	APP.

TABLE OF REVISIONS
CHECK WITH TRACING TO SEE IF YOU HAVE LATEST REVISION

REFERENCE INFORMATION
& FILE NO. OF SURVEYS



BUREAU OF ENGINEERING
DEPARTMENT OF PUBLIC WORKS
CITY AND COUNTY OF SAN FRANCISCO



DESIGNED KK	DATE 7/12	APPROVED [Signature]	DATE 9/11/12
DRAWN KK	DATE 7/12	SECTION MANAGER [Signature]	DATE 7/12
CHECKED SL	DATE 7/12	DEPUTY BUREAU MANAGER [Signature]	DATE 7/12
		BUREAU MANAGER [Signature]	DATE

SCALE
1"=20'
SHEET OF SHEETS
53 of 67

**FOLSOM STREETSCAPE
IMPROVEMENTS PROJECT**

**FOLSOM STREET
19TH STREET AND 21ST STREET INTERSECTIONS
TRAFFIC SIGNAL WORK**

CONTRACT NO. 1677J
DRAWING NO. E-1.0
FILE NO. 91598
REV. NO. 0