


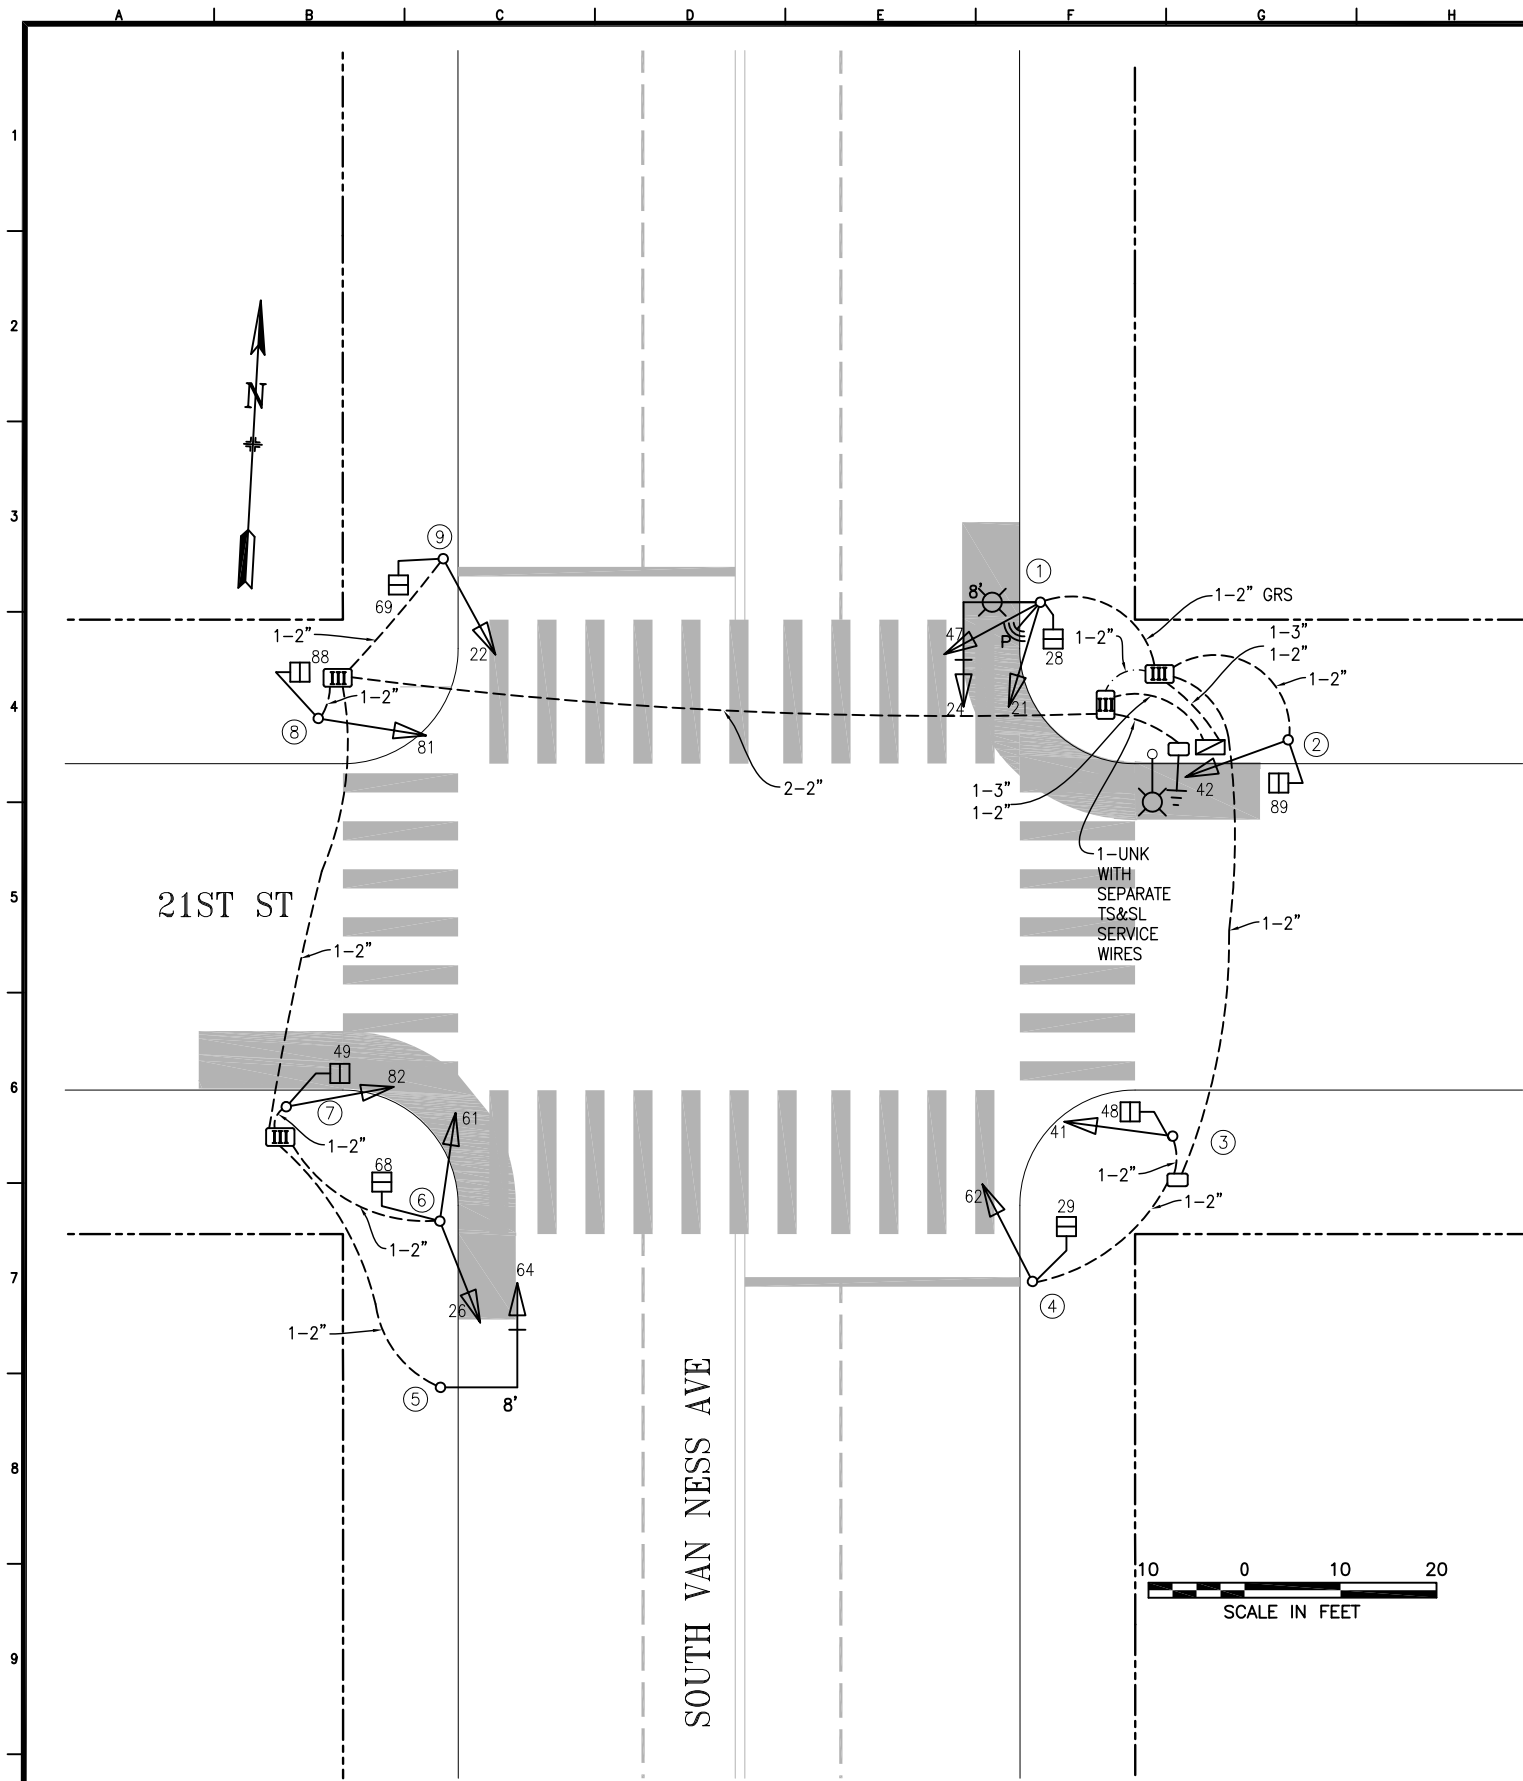

POLE AND EQUIPMENT SCHEDULE													
POLE No.	TYPE OF POLE	LUMINAIRE TYPE	VEHICLE SIGNAL					PEDESTRIAN SIGNAL				ITS DEVICE	REMARKS
			No.	TYPE	MOUNTING	VISORS	LOUVERS/BP	No.	TYPE	MOUNTING	BUTTON		
①	17-2-100 WITH 8' MAST ARM & 6' LUMINAIRE ARM		21 47 24	3S12" 3S12" 3S12"	SV-2-TC MAS 	T T T	BACKPLATE	28	1S-COUNT	SP-1		PREEMPT RADIO	
②	1-A (10')		42	3S12"	TV-1-T	T		89	1S-COUNT	SP-1			
③	1-A (10')		41	3S12"	TV-1-T	T		48	1S-COUNT	SP-1			
④	1-A (10')		62	3S12"	TV-1-T	T		29	1S-COUNT	SP-1			
⑤	16-2-100 WITH 8' MAST ARM		64	3S12"	MAS 	T	BACKPLATE						
⑥	1-A (10')		26 61	3S12" 3S12"	TV-2-T	T T		68	1S-COUNT	SP-1			
⑦	1-A (10')		82	3S12"	TV-1-T	T		49	1S-COUNT	SP-1			
⑧	1-A (10')		81	3S12"	TV-1-T	T		88	1S-COUNT	SP-1			
⑨	1-A (10')		22	3S12"	TV-1-T	T		69	1S-COUNT	SP-1			

NOTES:

① PLUMBIZER MOUNTED BETWEEN YELLOW AND GREEN SECTIONS

NO.	DATE	DESCRIPTION	BY	APPROVED
3	7/01/22	SRC 2022-067: ADDED PREEMPT RADIO	JLee	LVentura
2	7/21/21	NOTE SERVICE PT & ADD GROUND ROD PER 2823J AS-BUILT	DYeung	GDeLeon
1	12/18/18	SIGNAL UPGRADE CONTRACT #2823J. NEW MAST ARM POLES	DYeung	GDeLeon
0	04/29/14	SIGNAL UPGRADE ACTIVATED THRU 1901J AND CONVERTED FROM AS-BUILTS	GD	MVelasco

TABLE OF REVISIONS
CHECKOUT DRAWING THROUGH THE SID CUSTODIAN FOR THE LATEST REVISION



SFMTA

DRAWN BY:	DATE:
AScales	07/06/2015
CHECKED BY:	DATE:
MVelasco	07/2015

SCALE
AS SHOWN
SHEET OF SHEETS
1 OF 1

TRAFFIC SIGNAL INVENTORY DIAGRAM
21ST STREET AND SOUTH VAN NESS AVENUE

CNN NO:
24083000
REV NO:
3