


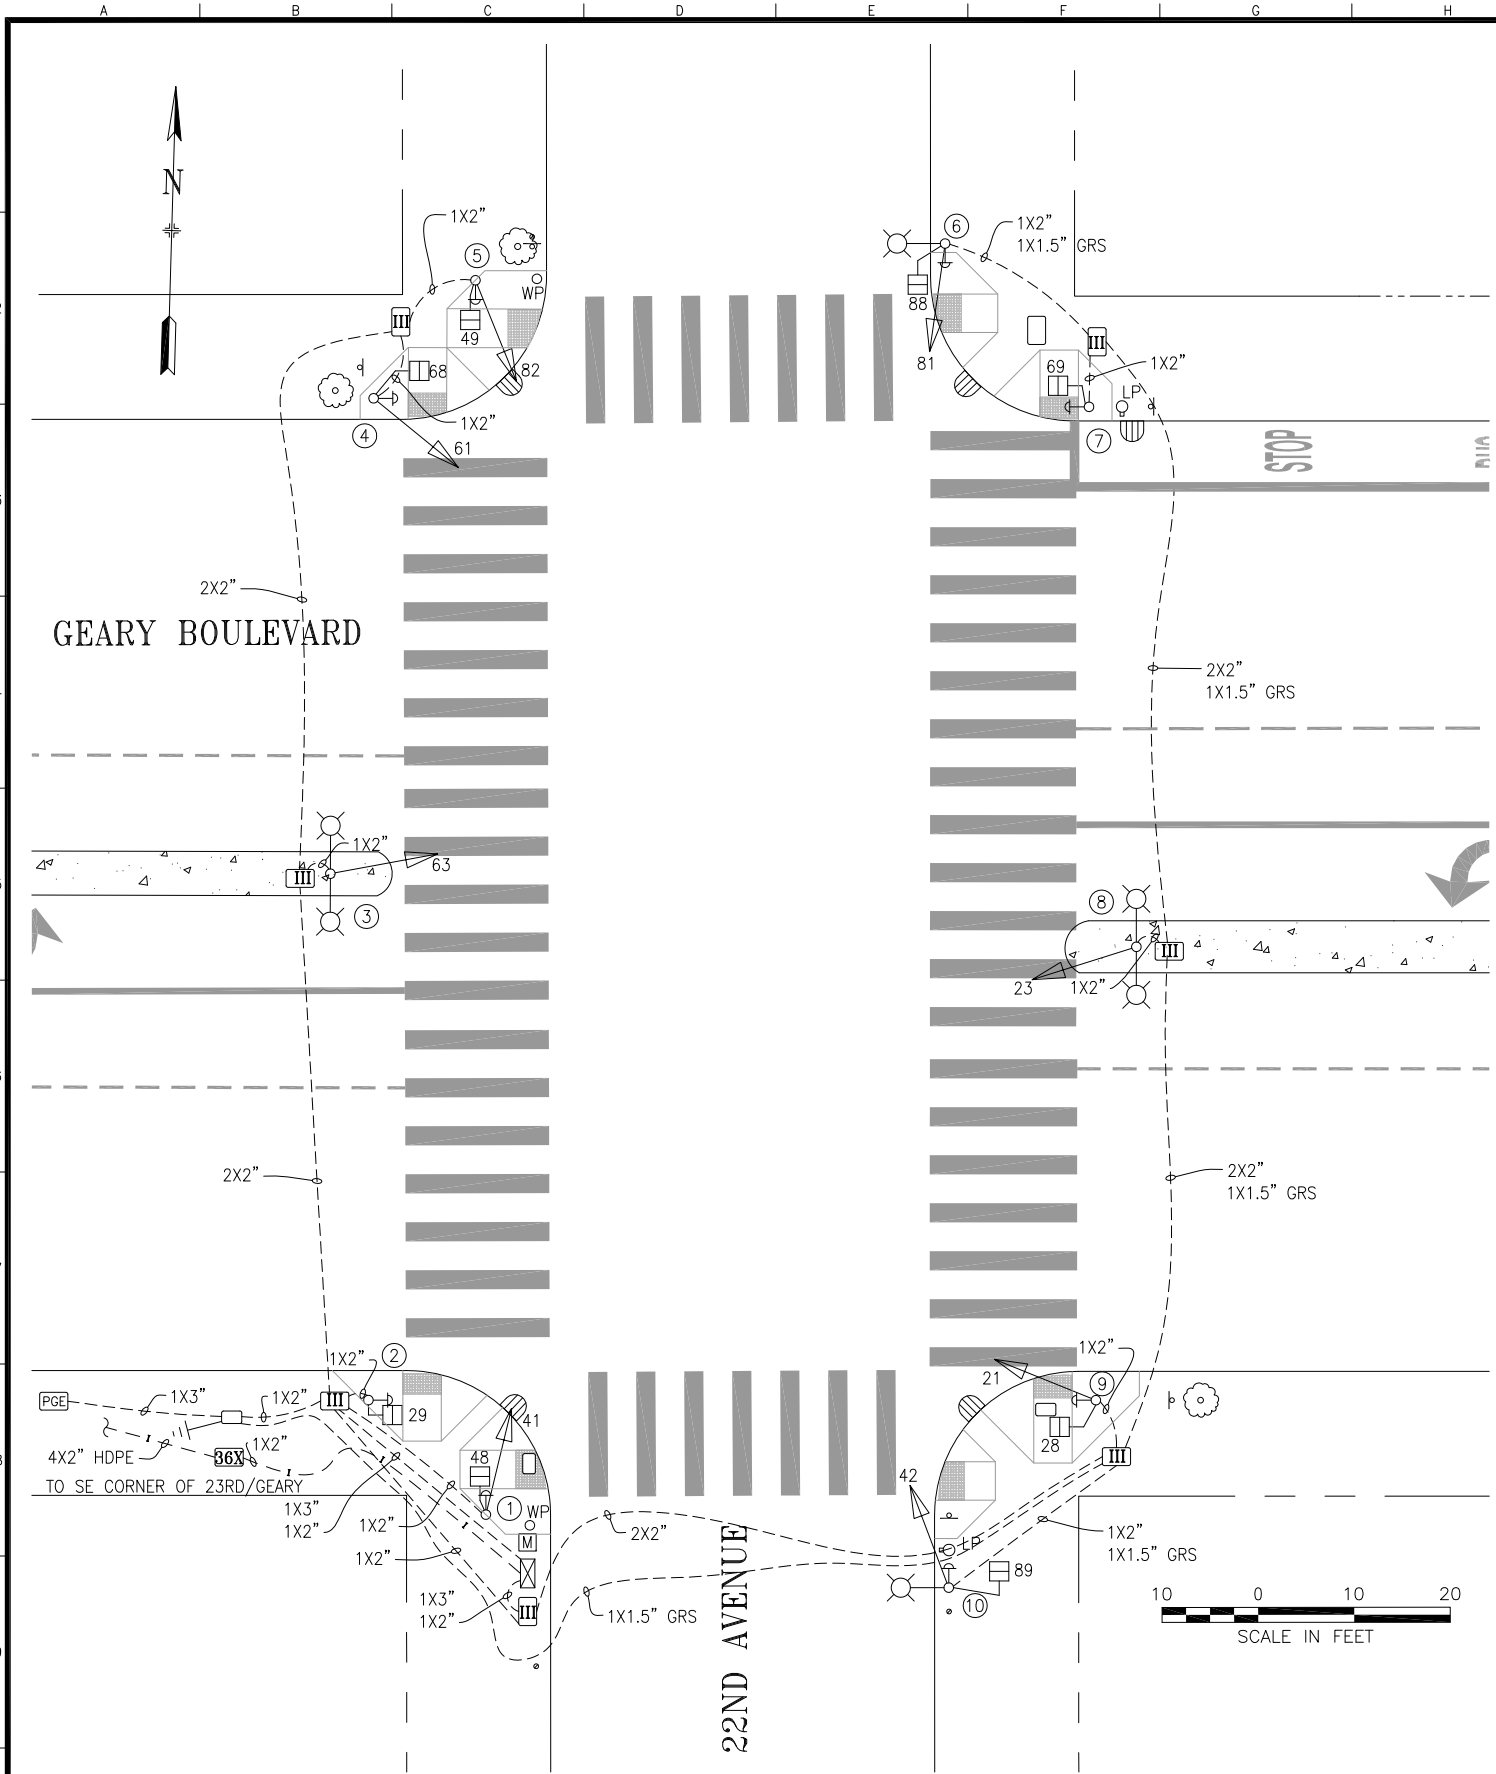

POLE AND EQUIPMENT SCHEDULE											
POLE No.	TYPE OF POLE	LUMINAIRE VOLTAGE/WATTAGE	VEHICLE SIGNAL					PEDESTRIAN SIGNAL			REMARKS
			No.	TYPE	MOUNTING	VISORS	LOUVERS	No.	TYPE	MOUNTING	
①	1-A (10')		41	3S12"	TV-1-T	T		48	1S-COUNT	SP-1	APS-4W
②	1-A (10')							29	1S-COUNT	SP-1	APS-4W
③	MARBLELITE SL W/DUAL LUMINAIRE ARMS		63	3S12"	SV-1	T					
④	1-A (10')		61	3S12"	TV-1-T	T		68	1S-COUNT	SP-1	APS-4W
⑤	1-A (10')		82	3S12"	TV-1-T	T		49	1S-COUNT	SP-1	APS-4W
⑥	CITY STANDARD STREET LIGHT	150W HPS	81	3S12"	SV-1-T	T		88	1S-COUNT	SP-1	APS-4W
⑦	1-A (10')							69	1S-COUNT	SP-1	APS-4W
⑧	MARBLELITE SL W/DUAL LUMINAIRE ARMS		23	3S12"	SV-1	T					
⑨	1-A (10')		21	3S12"	TV-1-T	T		28	1S-COUNT	SP-1	APS-4W
⑩	CITY STANDARD STREET LIGHT	150W HPS	42	3S12"	SV-1-T	T		89	1S-COUNT	SP-1	APS-4W

0	1/08/16	NEW SIGNAL ACTIVATED THROUGH 2477J	D.Young	M.Velasco	
NO.	DATE	DESCRIPTION	BY	APP.	
TABLE OF REVISIONS					
CHECK WITH TRACING TO SEE IF YOU HAVE LATEST REVISION					

REFERENCE INFORMATION
& FILE NO. OF SURVEYS



SAN FRANCISCO MUNICIPAL TRANSPORTATION AGENCY
CITY AND COUNTY OF SAN FRANCISCO

DRAWN: DATE:
A.SCALES 1/11/2017
CHECKED: DATE:
G.DELEON 1/13/2017

SCALE:

AS SHOWN

SHEET OF SHEETS

1 OF 1

TRAFFIC SIGNAL INVENTORY DIAGRAM

22ND AVENUE AND GEARY BOULEVARD

CNN NO.

27538000

REV NO.

0