


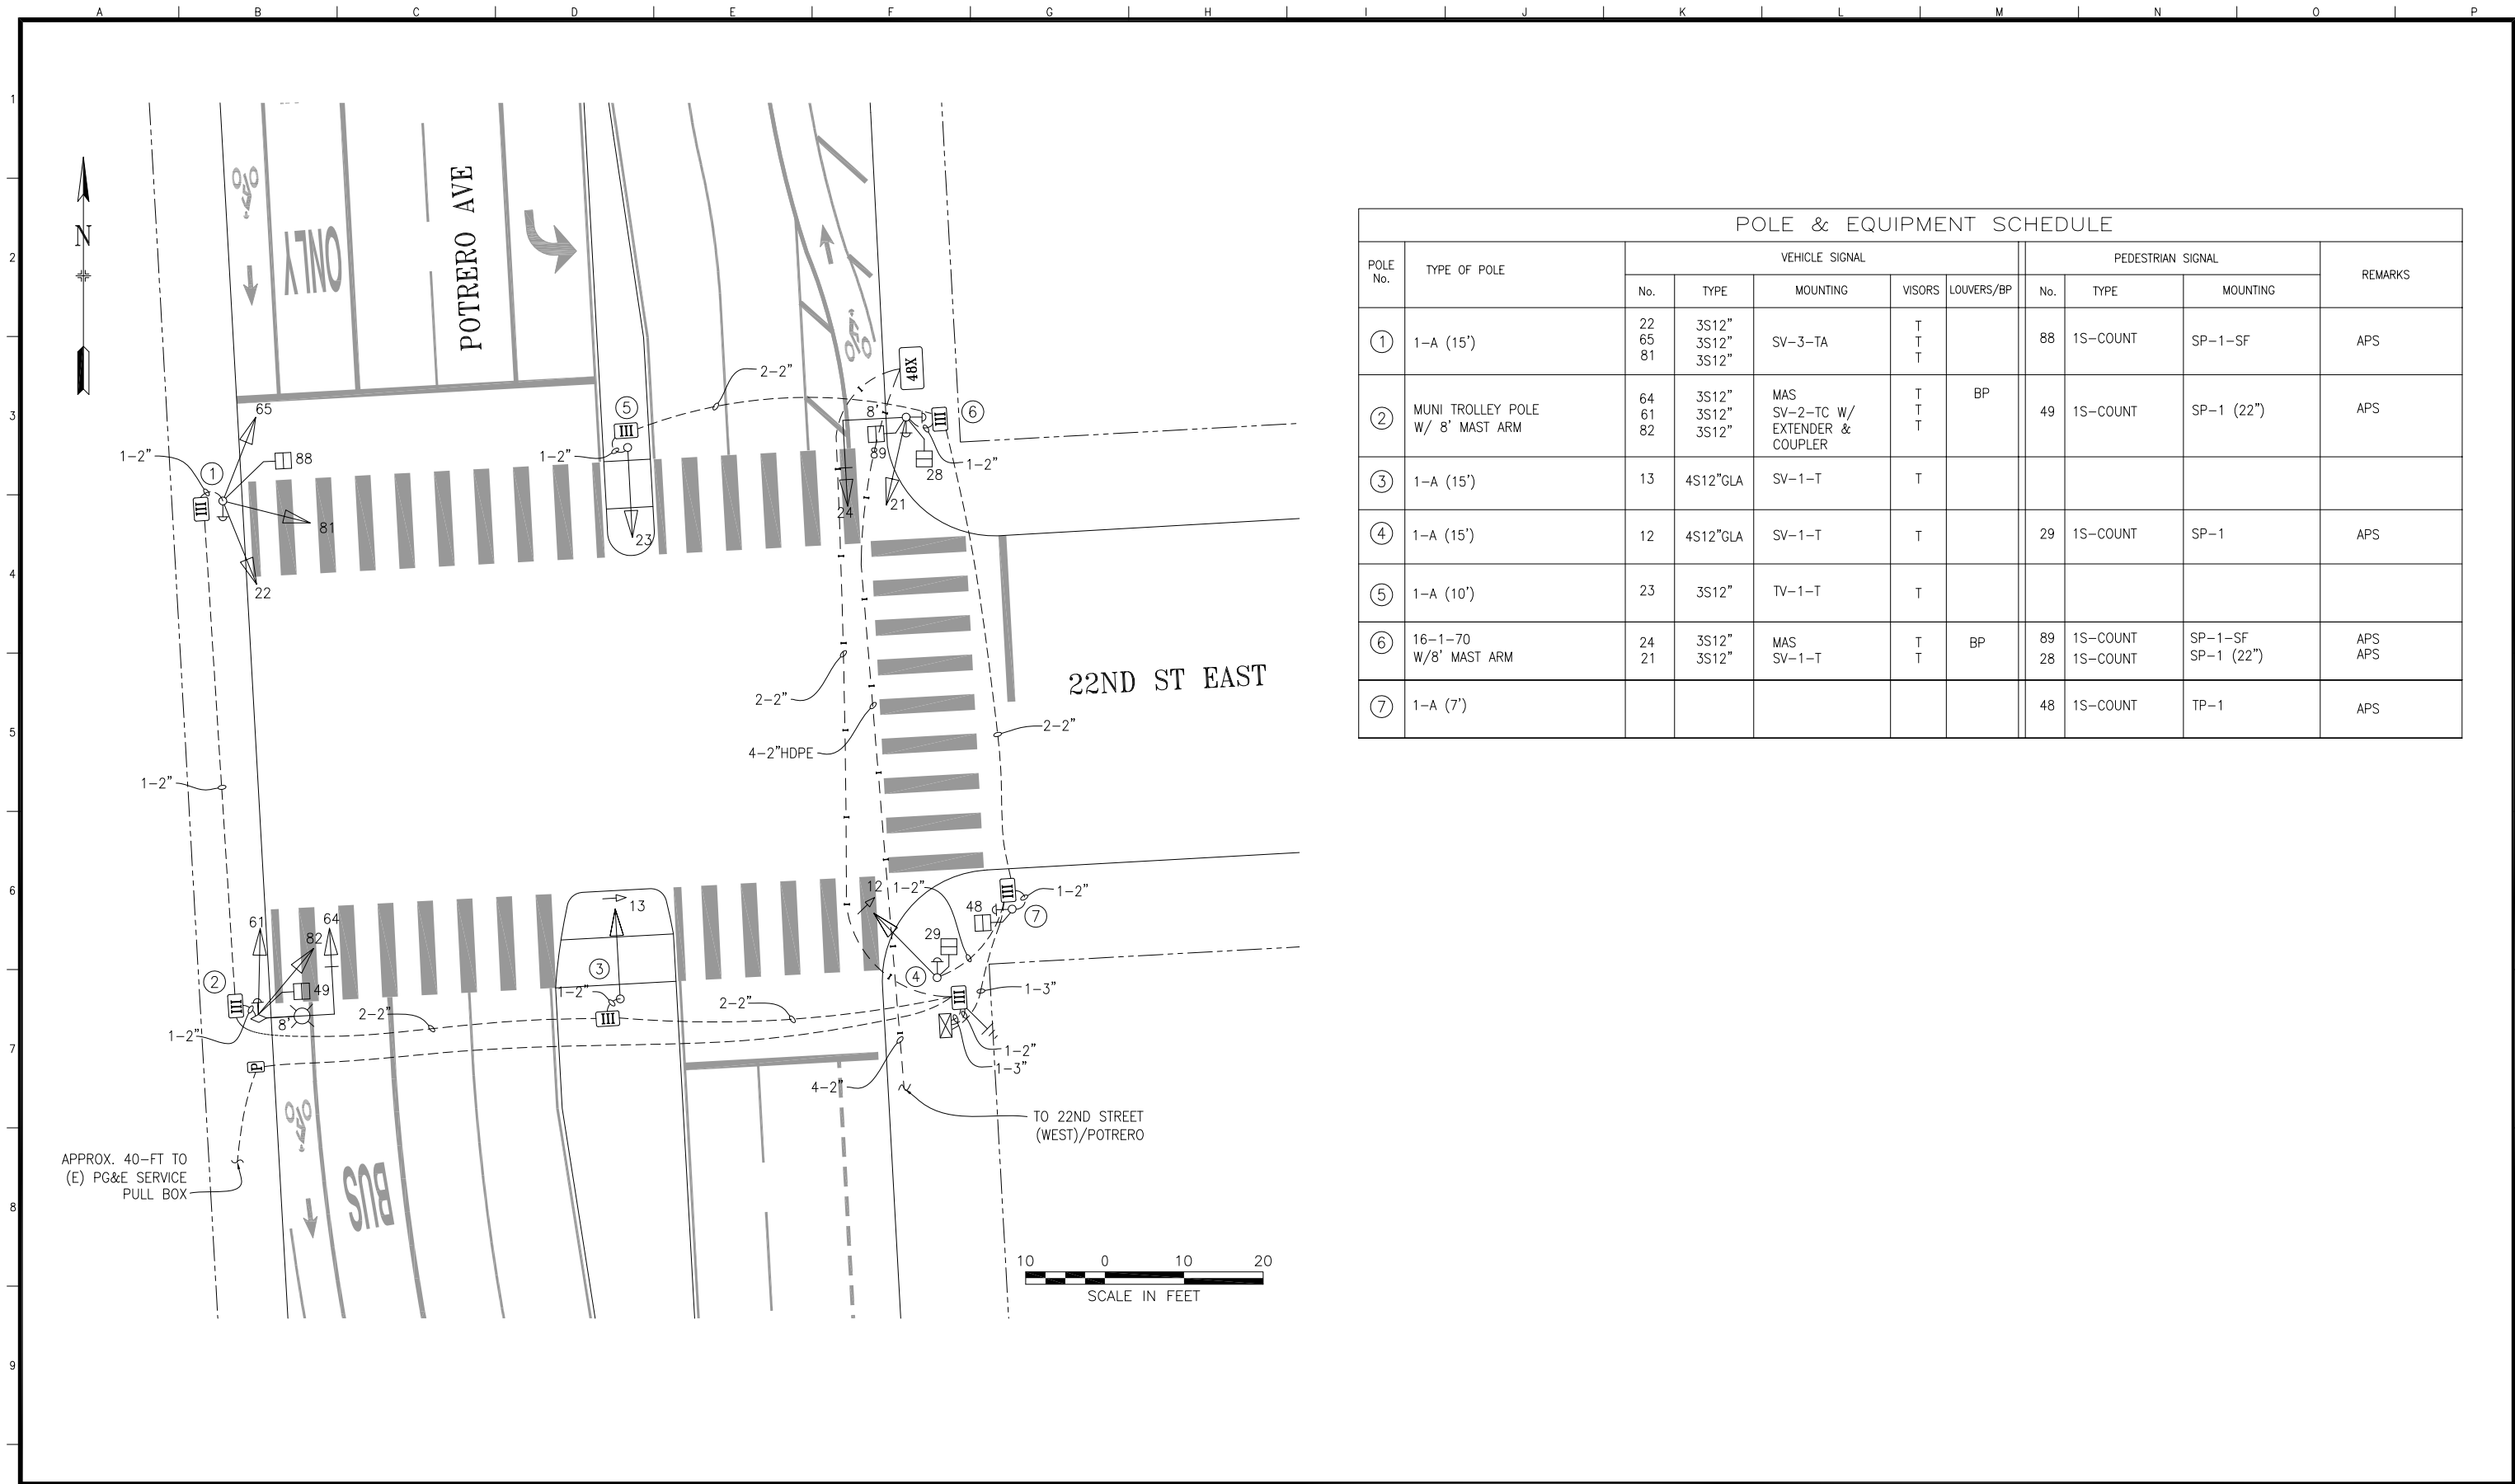

POLE & EQUIPMENT SCHEDULE										
POLE No.	TYPE OF POLE	VEHICLE SIGNAL					PEDESTRIAN SIGNAL			REMARKS
		No.	TYPE	MOUNTING	VISORS	LOUVERS/BP	No.	TYPE	MOUNTING	
①	1-A (15')	22 65 81	3S12" 3S12" 3S12"	SV-3-TA	T T T		88	1S-COUNT	SP-1-SF	APS
②	MUNI TROLLEY POLE W/ 8' MAST ARM	64 61 82	3S12" 3S12" 3S12"	MAS SV-2-TC W/ EXTENDER & COUPLER	T T T	BP	49	1S-COUNT	SP-1 (22")	APS
③	1-A (15')	13	4S12"GLA	SV-1-T	T					
④	1-A (15')	12	4S12"GLA	SV-1-T	T		29	1S-COUNT	SP-1	APS
⑤	1-A (10')	23	3S12"	TV-1-T	T					
⑥	16-1-70 W/8' MAST ARM	24 21	3S12" 3S12"	MAS SV-1-T	T T	BP	89 28	1S-COUNT 1S-COUNT	SP-1-SF SP-1 (22")	APS APS
⑦	1-A (7')						48	1S-COUNT	TP-1	APS

TABLE OF REVISIONS				
NO.	DATE	DESCRIPTION	BY	APP.
1	02/19/19	UPGRADED SIGNAL HEADS/POLES FOR 3&4, SRC 2018-422	L.VENTURA	D.ALABA
0	08/24/18	UPGRADED BY 2127J; CONVERTED FROM AS-BUILTS	L.VENTURA	D.ALABA
CHECK WITH TRACING TO SEE IF YOU HAVE LATEST REVISION				

REFERENCE INFORMATION & FILE NO. OF SURVEYS



SAN FRANCISCO MUNICIPAL TRANSPORTATION AGENCY

CITY AND COUNTY OF SAN FRANCISCO

DRAWN:	DATE:
L.VENTURA	10/2018
CHECKED:	DATE:
D.ALABA	10/2018

SCALE:
AS SHOWN
SHEET OF SHEETS
1 OF 1

TRAFFIC SIGNAL INVENTORY DIAGRAM
22ND STREET (EAST) AND POTRERO AVENUE

CNN NO.
23967000
REV NO.
1