


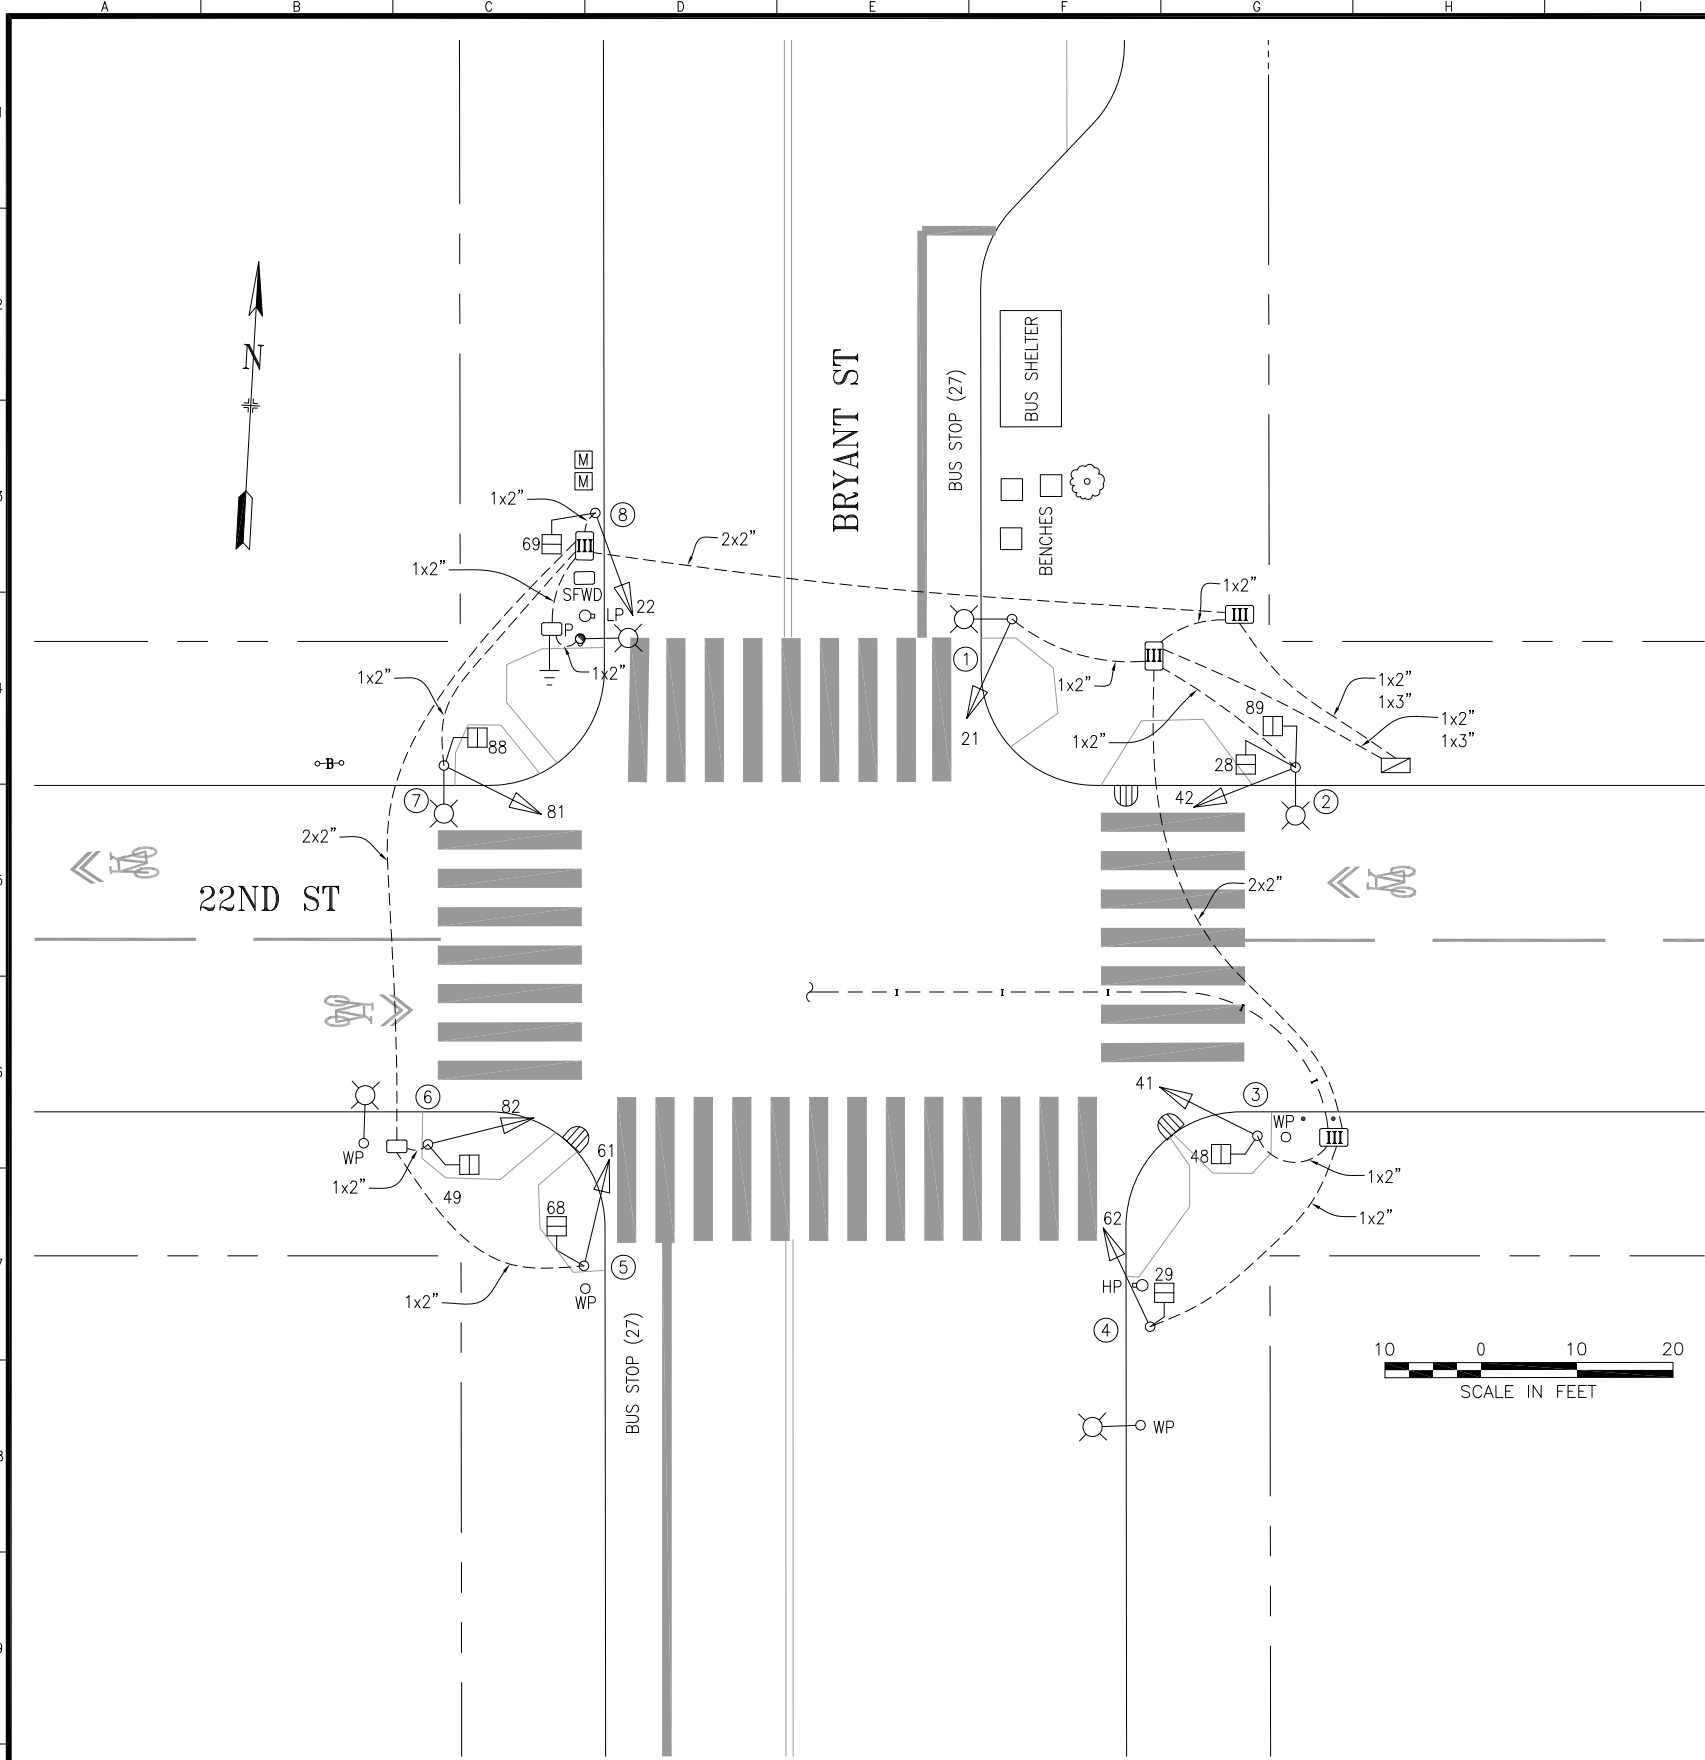

POLE AND EQUIPMENT SCHEDULE											
POLE No.	TYPE OF POLE	LUMINAIRE VOLTAGE/WATTAGE	VEHICLE SIGNAL					PEDESTRIAN SIGNAL			REMARKS
			No.	TYPE	MOUNTING	VISORS	LOUVERS	No.	TYPE	MOUNTING	
①	CITY STANDARD STREET LIGHT	120V/150W	21	3S12"	SV-1-T	T					
②	CITY STANDARD STREET LIGHT	120V/150W	42	3S12"	SV-1-T	T		28 89	1S-COUNT 1S-COUNT	SP-1-SF (12") SP-1 (22")	
③	1-A (10')		41	3S12"	TV-1-T	T		48	1S-COUNT	SP-1	
④	1-A (10')		62	3S12"	TV-1-T	T		29	1S-COUNT	SP-1	
⑤	1-A (10')		61	3S12"	TV-1-T	T		68	1S-COUNT	SP-1	
⑥	1-A (10')		82	3S12"	TV-1-T	T		49	1S-COUNT	SP-1	
⑦	CITY STANDARD STREET LIGHT	120V/150W	81	3S12"	SV-1-T	T		88	1S-COUNT	SP-1	
⑧	1-A (10')		22	3S12"	TV-1-T	T		69	1S-COUNT	SP-1	

0	06/12/14	SIGNAL UPGRADE THRU 2142; SID CONVERTED FROM CONTRACT PLANS	SVohra	GDeLeon	
NO.	DATE	DESCRIPTION	BY	APP.	
TABLE OF REVISIONS					
CHECK WITH TRACING TO SEE IF YOU HAVE LATEST REVISION					

REFERENCE INFORMATION & FILE NO. OF SURVEYS



SAN FRANCISCO MUNICIPAL TRANSPORTATION AGENCY
CITY AND COUNTY OF SAN FRANCISCO

DRAWN:	DATE:
SVohra	12/2015
CHECKED:	DATE:
G. DeLeon	6/6/2015

SCALE:
AS SHOWN
SHEET OF SHEETS
1 OF 1

TRAFFIC SIGNAL INVENTORY DIAGRAM
22ND STREET AND BRYANT STREET

CNN NO.
23971000
REV NO.
0