
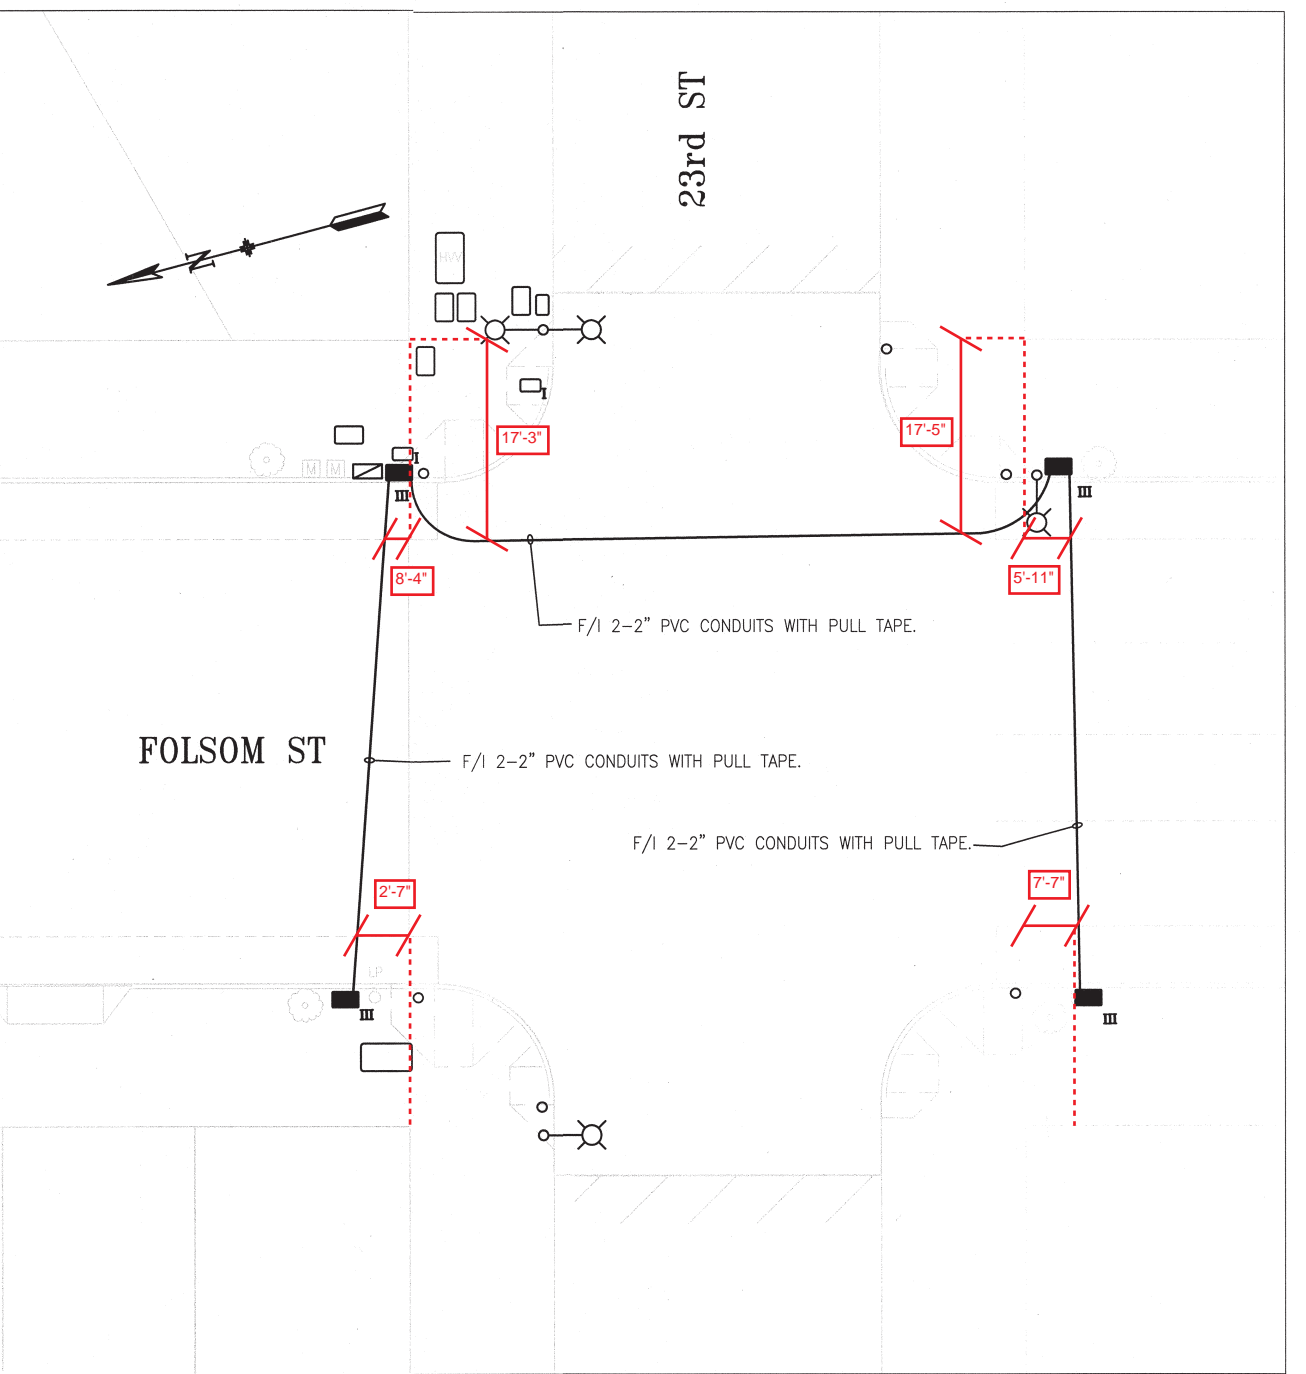


S-16-7

POLE	FUNC.	MAT'L	SIGNAL NO.	MAKE	NO. OF SECT.	SIZE	VISOR	B.P. OR LOUVERS	MOUN'T	PED SIGNAL NO.	LEGEND	MESSAGE		MAKE	MOUN'T
												ELEMENT	COLOR		
A	S	S	82	EC	3	8"	FC 8"	NO	T						
B	S	S	61	EC	3	8"	FC 8"	NO	T						
C	S	S	22	GA	3	8"	FC 8"	NO	T						
D	S	S	81	GA	3	8"	FC 8"	NO	T						
			42	CH	3	8"	FC 8"	NO	T						
			21	CH	3	8"	FC 8"	NO	T						
			62	EC	3	8"	FC 8"	NO	T						
1	U	W	41	EC	3	8"	FC 8"	NO	T						
2	U	W													
3	U	W													
4	U	W													

CONTROLLER CABINET SIZE : ORDINARY BASE CABINET: YES

COMMENTS :

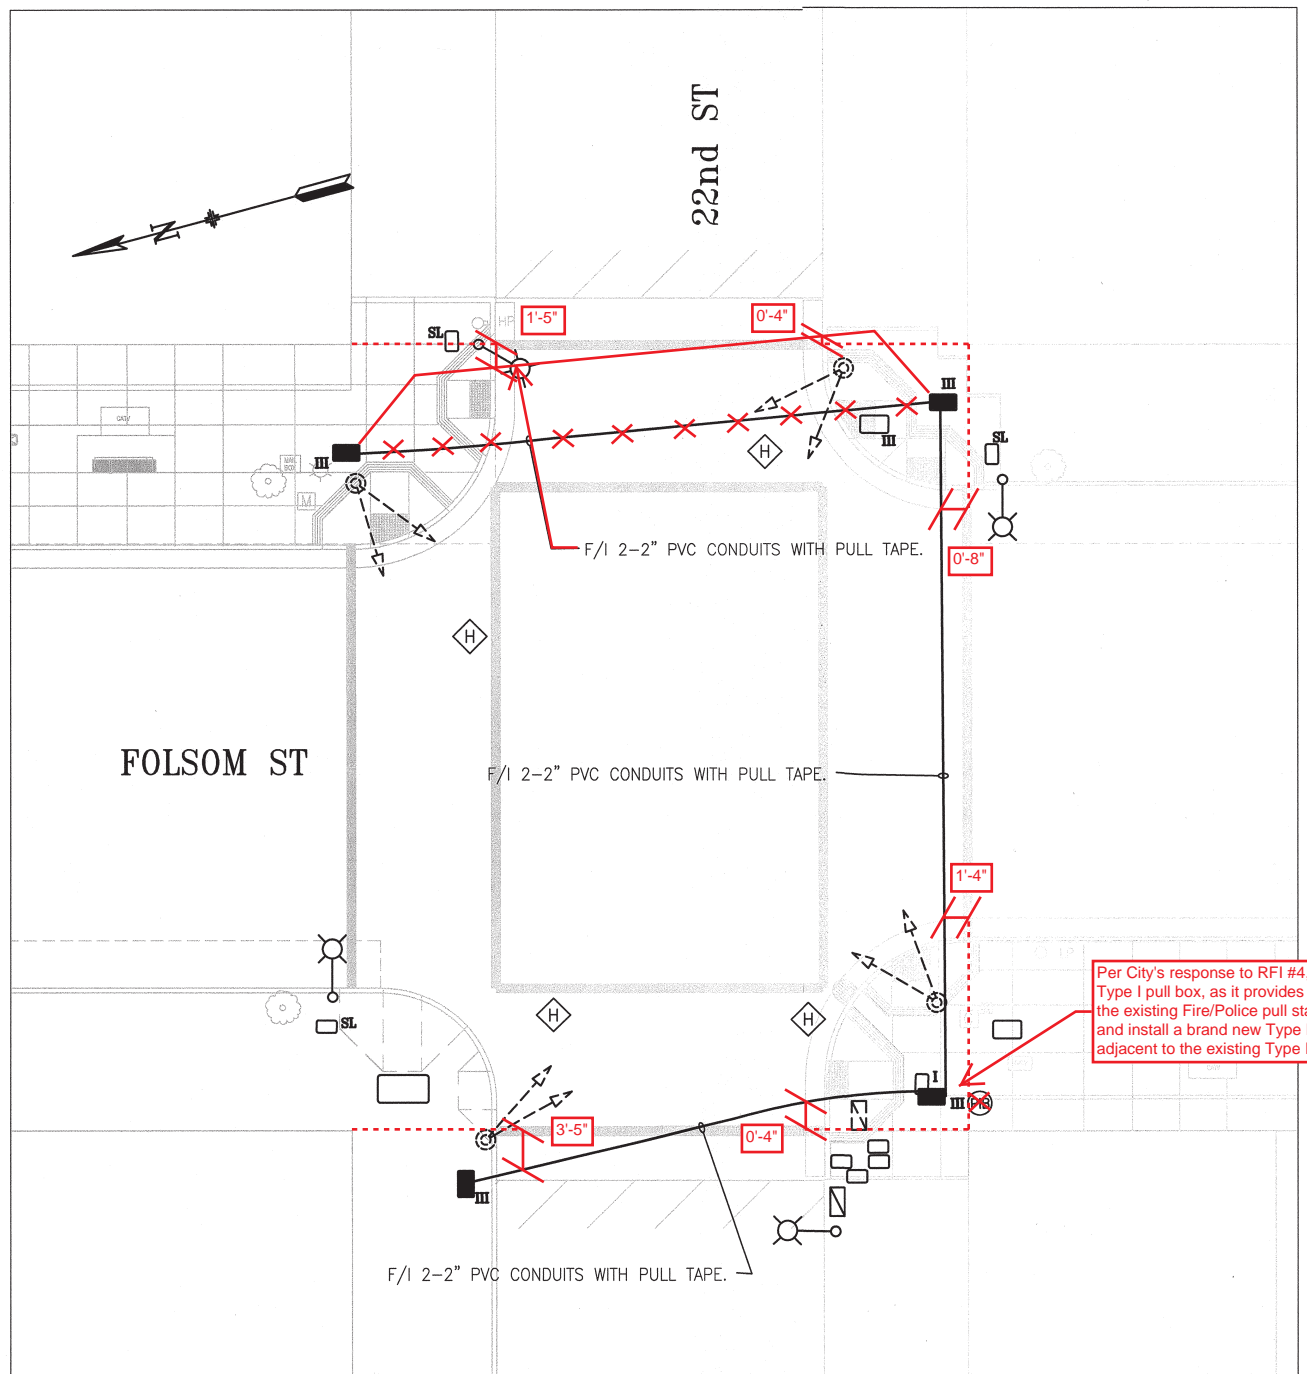

AS-BUILT
DATE: 9/30/13
BY: MIKE WONG
PHOENIX ELECTRIC
1350 VAN DYKE AVENUE
SAN FRANCISCO, CA 94124

BASE BID

NO.	DATE	DESCRIPTION	BY	APP.
TABLE OF REVISIONS				
CHECK WITH TRACING TO SEE IF YOU HAVE LATEST REVISION				

REFERENCE INFORMATION
& FILE NO. OF SURVEYS



BUREAU OF ENGINEERING
DEPARTMENT OF PUBLIC WORKS
CITY AND COUNTY OF SAN FRANCISCO



DESIGNED
KK 7/12
DRAWN
KK 7/12
CHECKED
SL 7/12

APPROVED
SECTION MANAGER 7/19/12
DEPUTY BUREAU MANAGER 7/19/12
BUREAU MANAGER 7/12

SCALE
1"=20'
SHEET OF SHEETS
54 of 67

**FOLSOM STREETSCAPE
IMPROVEMENTS PROJECT**

**FOLSOM STREET
22ND STREET AND 23RD STREET INTERSECTIONS
TRAFFIC SIGNAL WORK**

CONTRACT NO.
1677J
DRAWING NO.
E-2.0
FILE NO.
91599
REV. NO.
0