


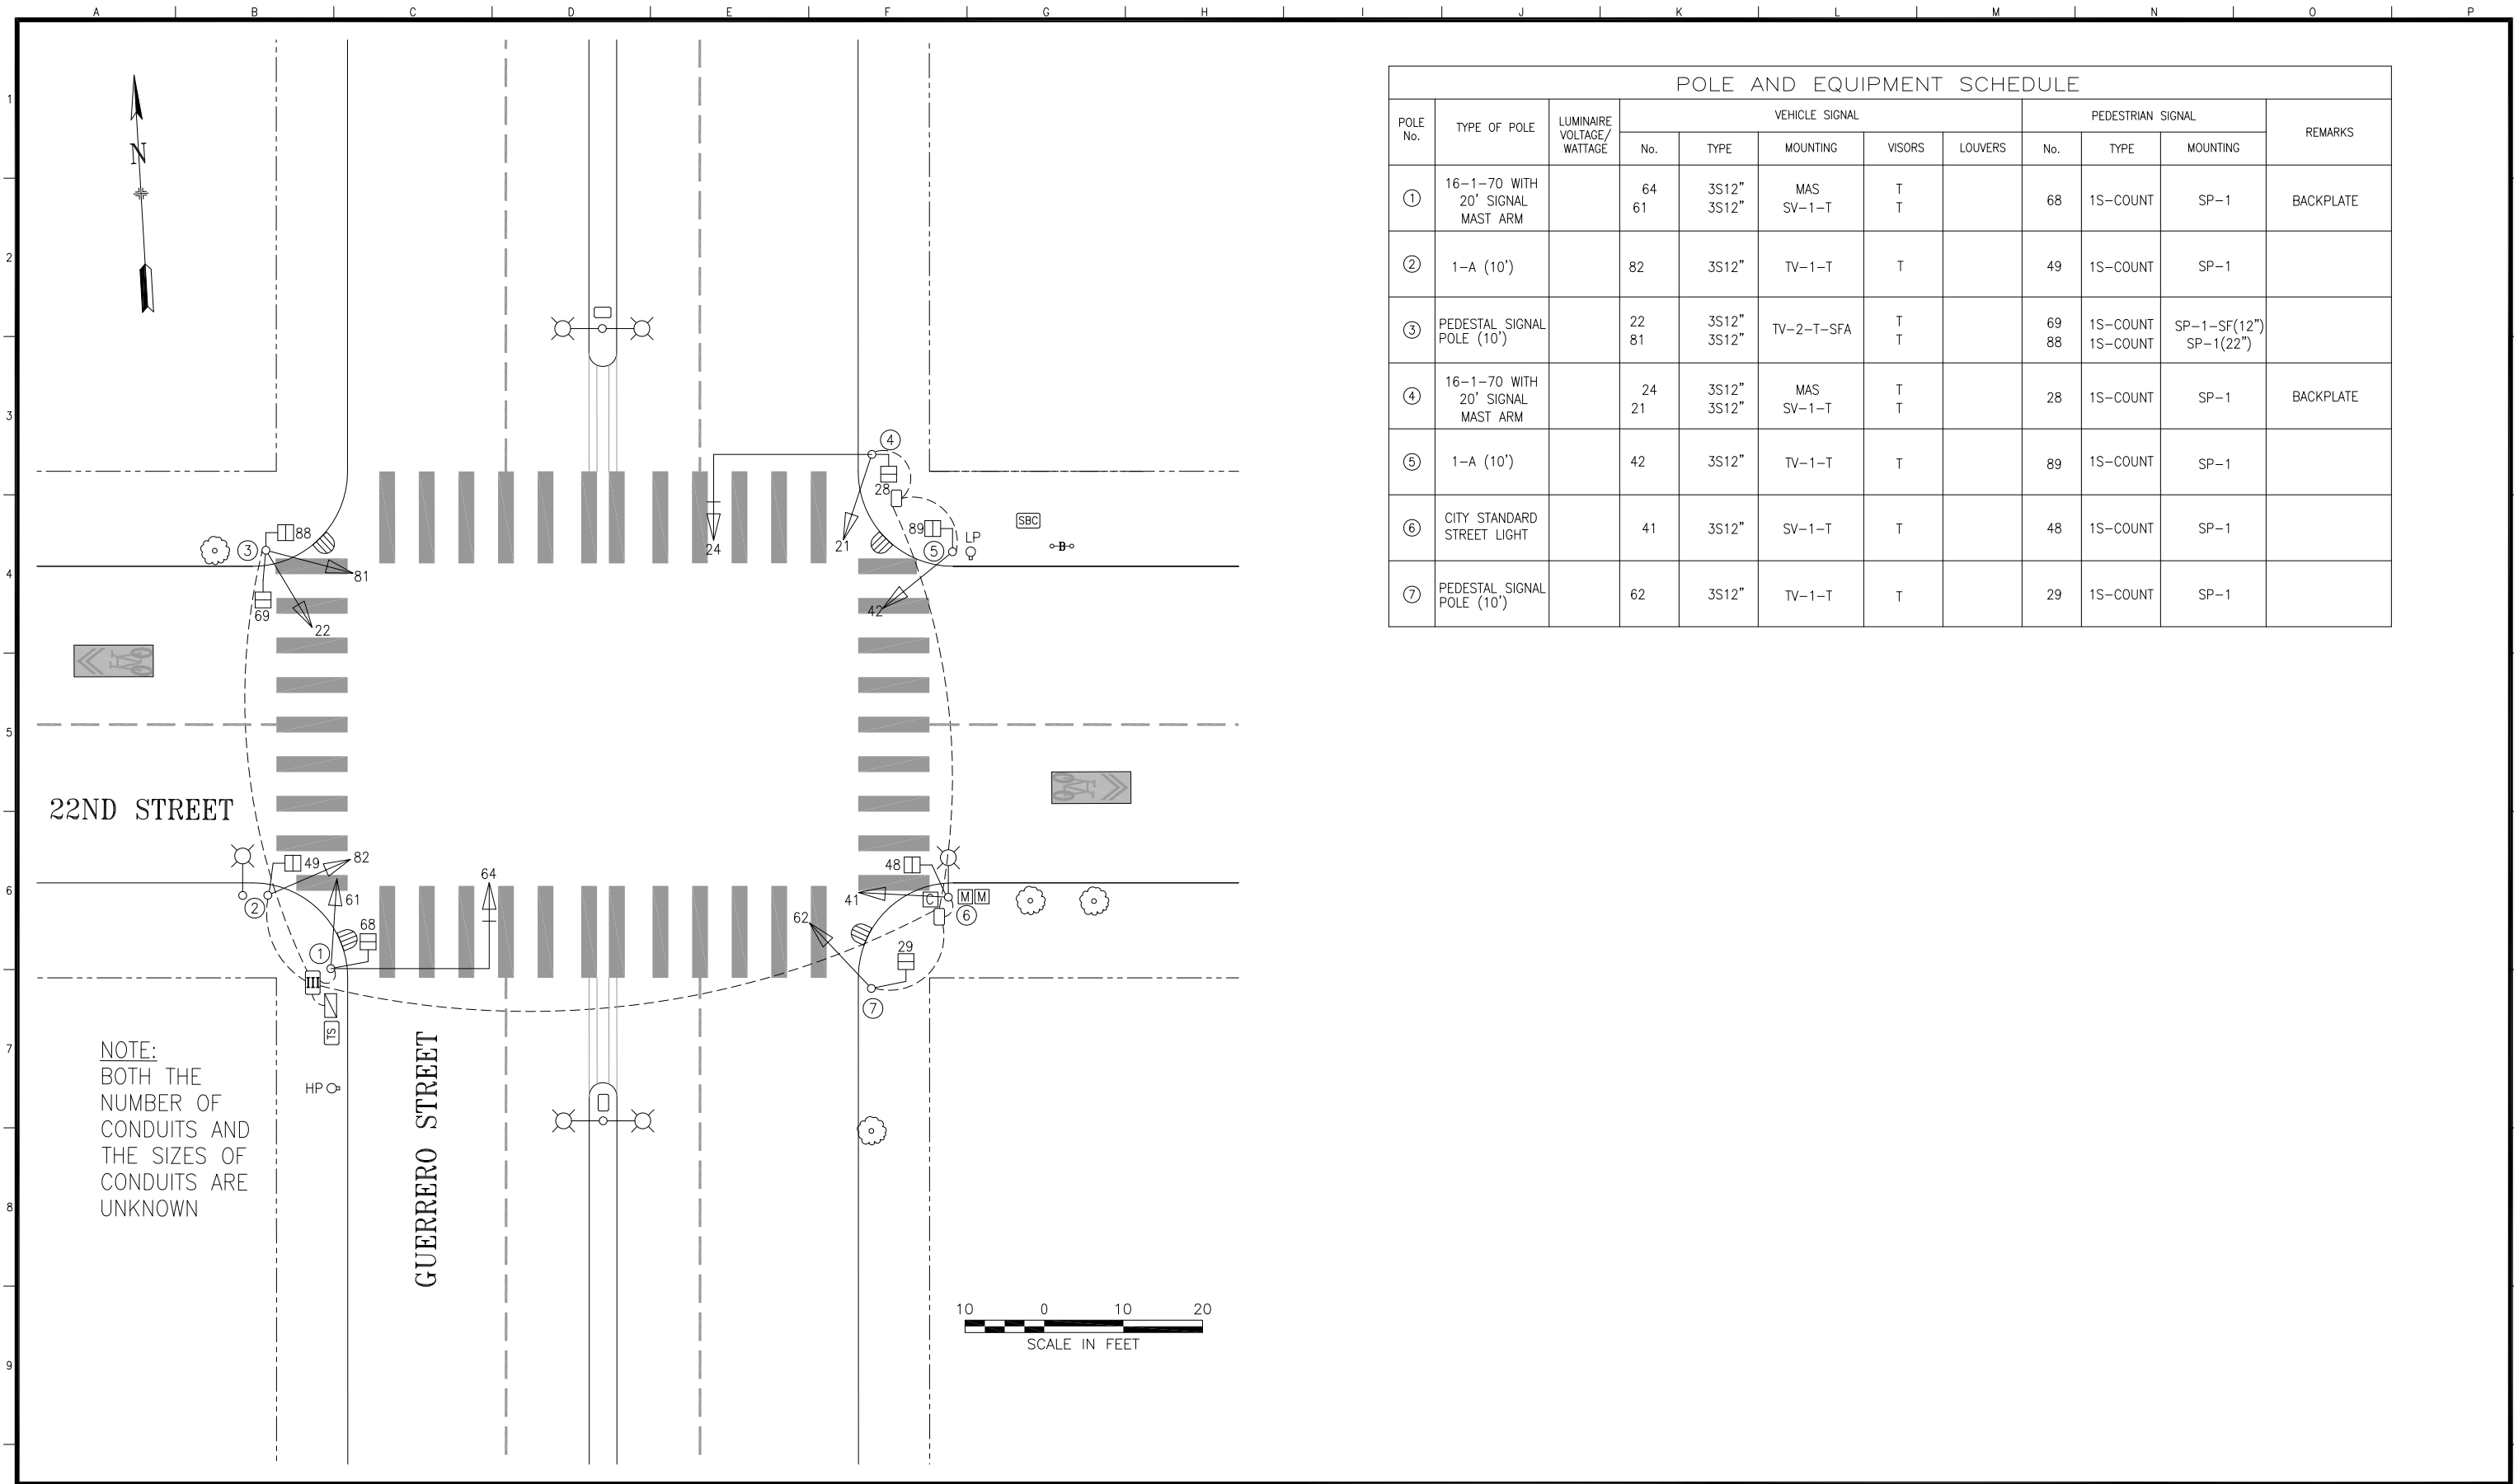

POLE AND EQUIPMENT SCHEDULE											
POLE No.	TYPE OF POLE	LUMINAIRE VOLTAGE/ WATTAGE	VEHICLE SIGNAL					PEDESTRIAN SIGNAL			REMARKS
			No.	TYPE	MOUNTING	VISORS	LOUVERS	No.	TYPE	MOUNTING	
①	16-1-70 WITH 20' SIGNAL MAST ARM		64 61	3S12" 3S12"	MAS SV-1-T	T T		68	1S-COUNT	SP-1	BACKPLATE
②	1-A (10')		82	3S12"	TV-1-T	T		49	1S-COUNT	SP-1	
③	PEDESTAL SIGNAL POLE (10')		22 81	3S12" 3S12"	TV-2-T-SFA	T T		69 88	1S-COUNT 1S-COUNT	SP-1-SF(12") SP-1(22")	
④	16-1-70 WITH 20' SIGNAL MAST ARM		24 21	3S12" 3S12"	MAS SV-1-T	T T		28	1S-COUNT	SP-1	BACKPLATE
⑤	1-A (10')		42	3S12"	TV-1-T	T		89	1S-COUNT	SP-1	
⑥	CITY STANDARD STREET LIGHT		41	3S12"	SV-1-T	T		48	1S-COUNT	SP-1	
⑦	PEDESTAL SIGNAL POLE (10')		62	3S12"	TV-1-T	T		29	1S-COUNT	SP-1	

0	8/4/15	2543J PUNCHLIST WALKTHROUGH; ADD PCS AND UPGRADE TO 12"	DYeung	Melasco	
NO.	DATE	DESCRIPTION	BY	APP.	
TABLE OF REVISIONS					
CHECK WITH TRACING TO SEE IF YOU HAVE LATEST REVISION					

REFERENCE INFORMATION & FILE NO. OF SURVEYS



SAN FRANCISCO MUNICIPAL TRANSPORTATION AGENCY
CITY AND COUNTY OF SAN FRANCISCO

DRAWN: AScales	DATE: 11/2015
CHECKED: MVelasco	DATE: 11/2015

SCALE: AS SHOWN
SHEET OF SHEETS 1 OF 1

TRAFFIC SIGNAL INVENTORY DIAGRAM
22ND STREET AND GUERRERO STREET

CNN NO. 25623000
REV NO. 0